


THIS MAP WAS PREPARED FOR ASSESSMENT PURPOSE ONLY.

SECTION 22 T.20S. R.12W. W.M.
DOUGLAS COUNTY

20 12 22

1" = 400'

SEE MAP 20 12 15

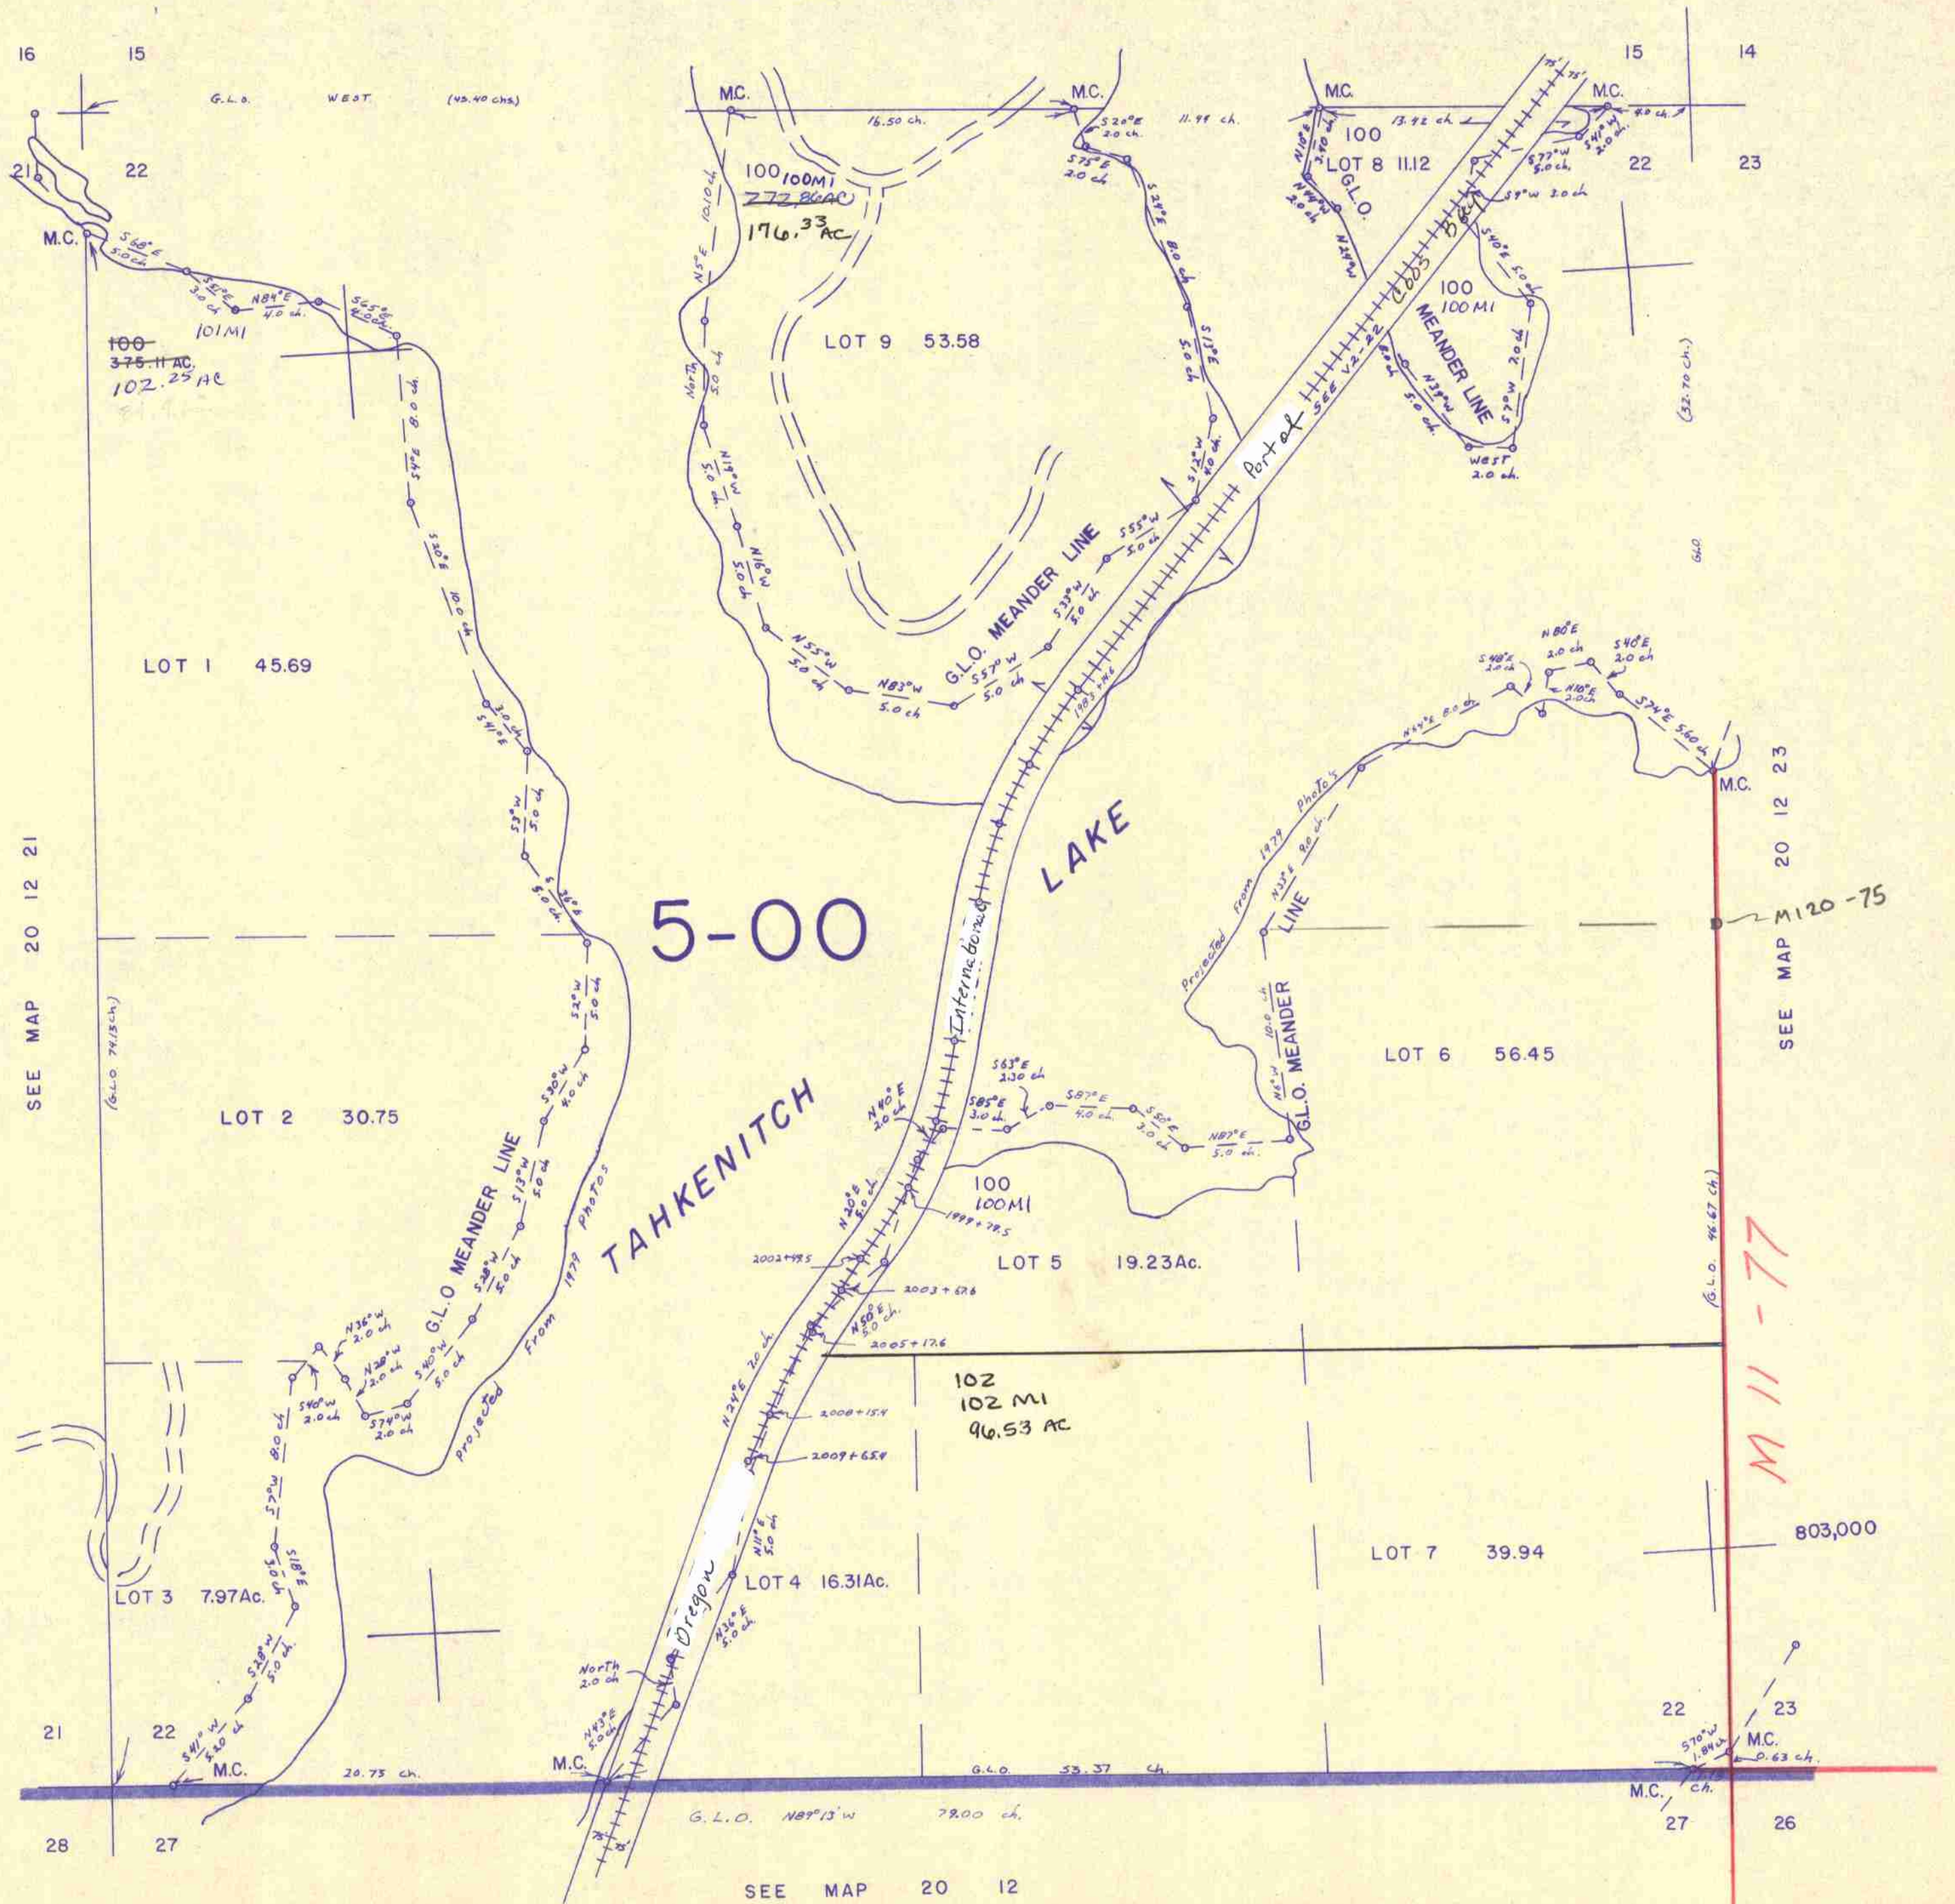

SEE MAP 20 12 21

SEE MAP 20 12 23

SEE MAP 20 12

20 12 22

1,049,000

3/8/22