


THIS MAP WAS PREPARED FOR ASSESSMENT PURPOSE ONLY.

SECTION 33 T.20S. R.12W. W.M. DOUGLAS COUNTY

1" = 400'

SEE MAP 20 12 28

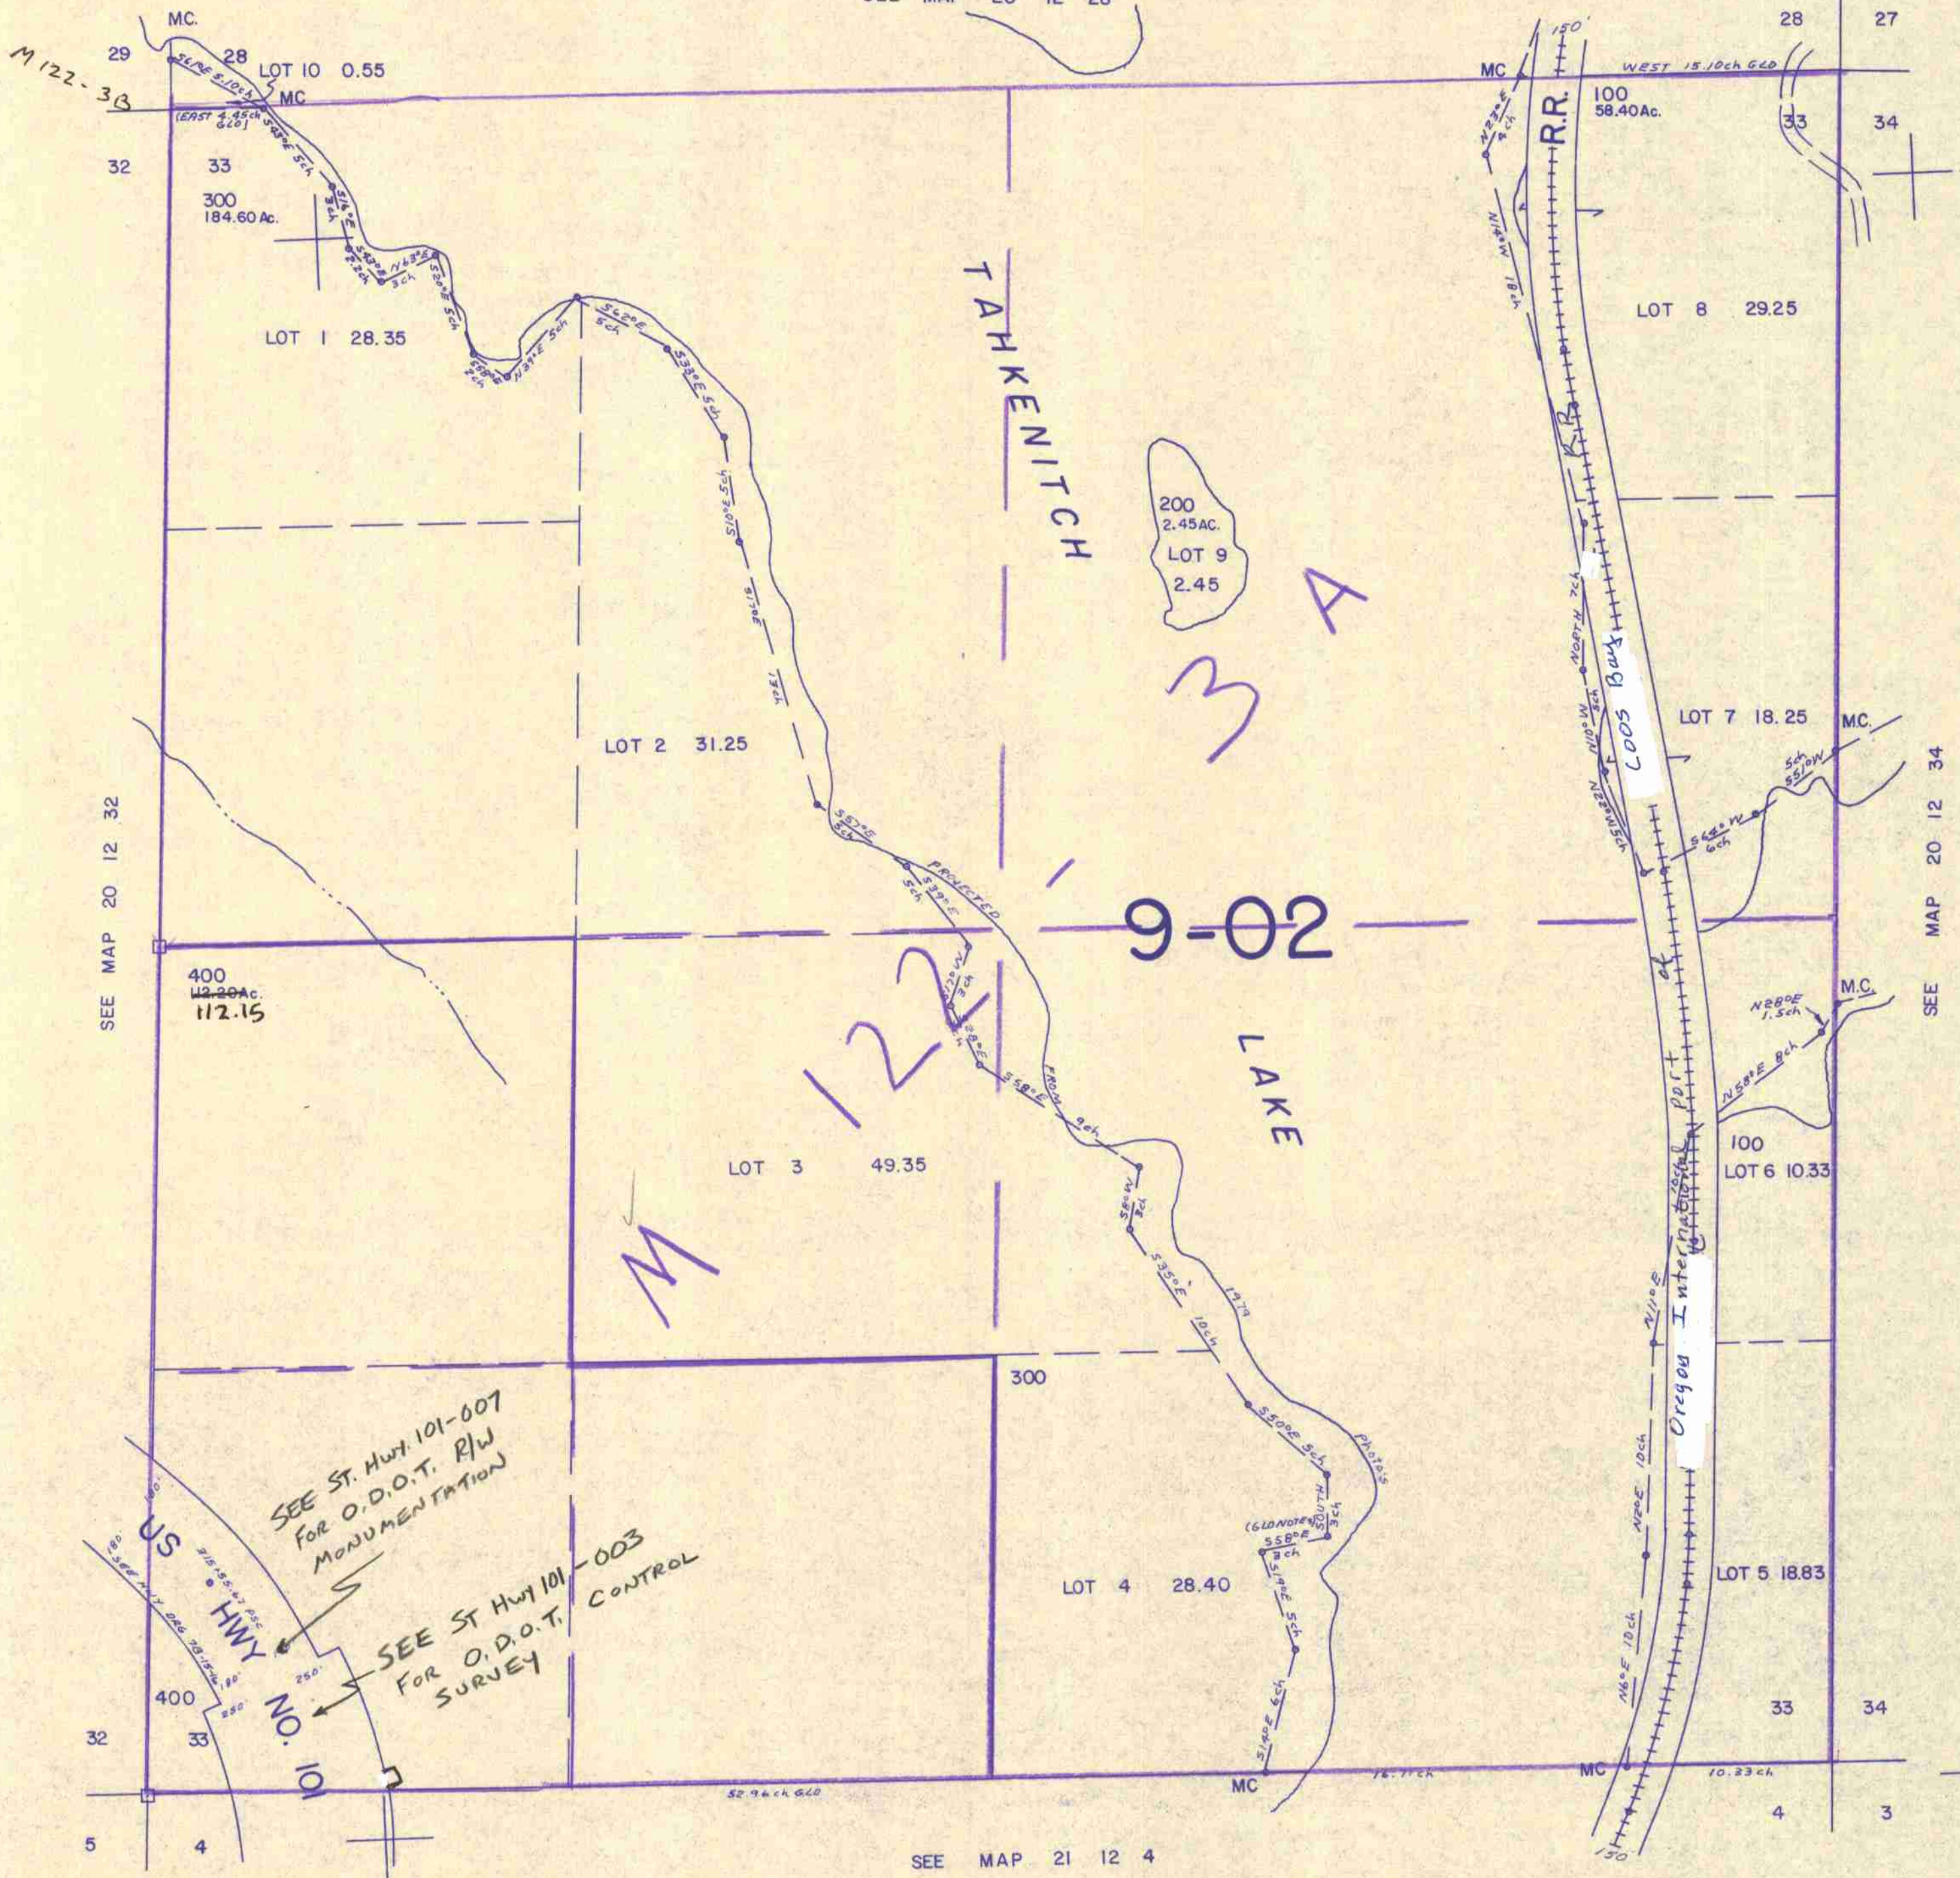

SEE MAP 20 12 32

SEE MAP 20 12 34

SEE ST. HWY 101-007 FOR O.D.O.T. R/W MONUMENTATION

SEE ST HWY 101-003 FOR O.D.O.T. CONTROL SURVEY

SEE MAP 21 12 4

