


THIS MAP WAS PREPARED FOR ASSESSMENT PURPOSE ONLY.

SECTION 35 T.20S. R.12W. W.M.
DOUGLAS COUNTY

20 12 35

1" = 400'

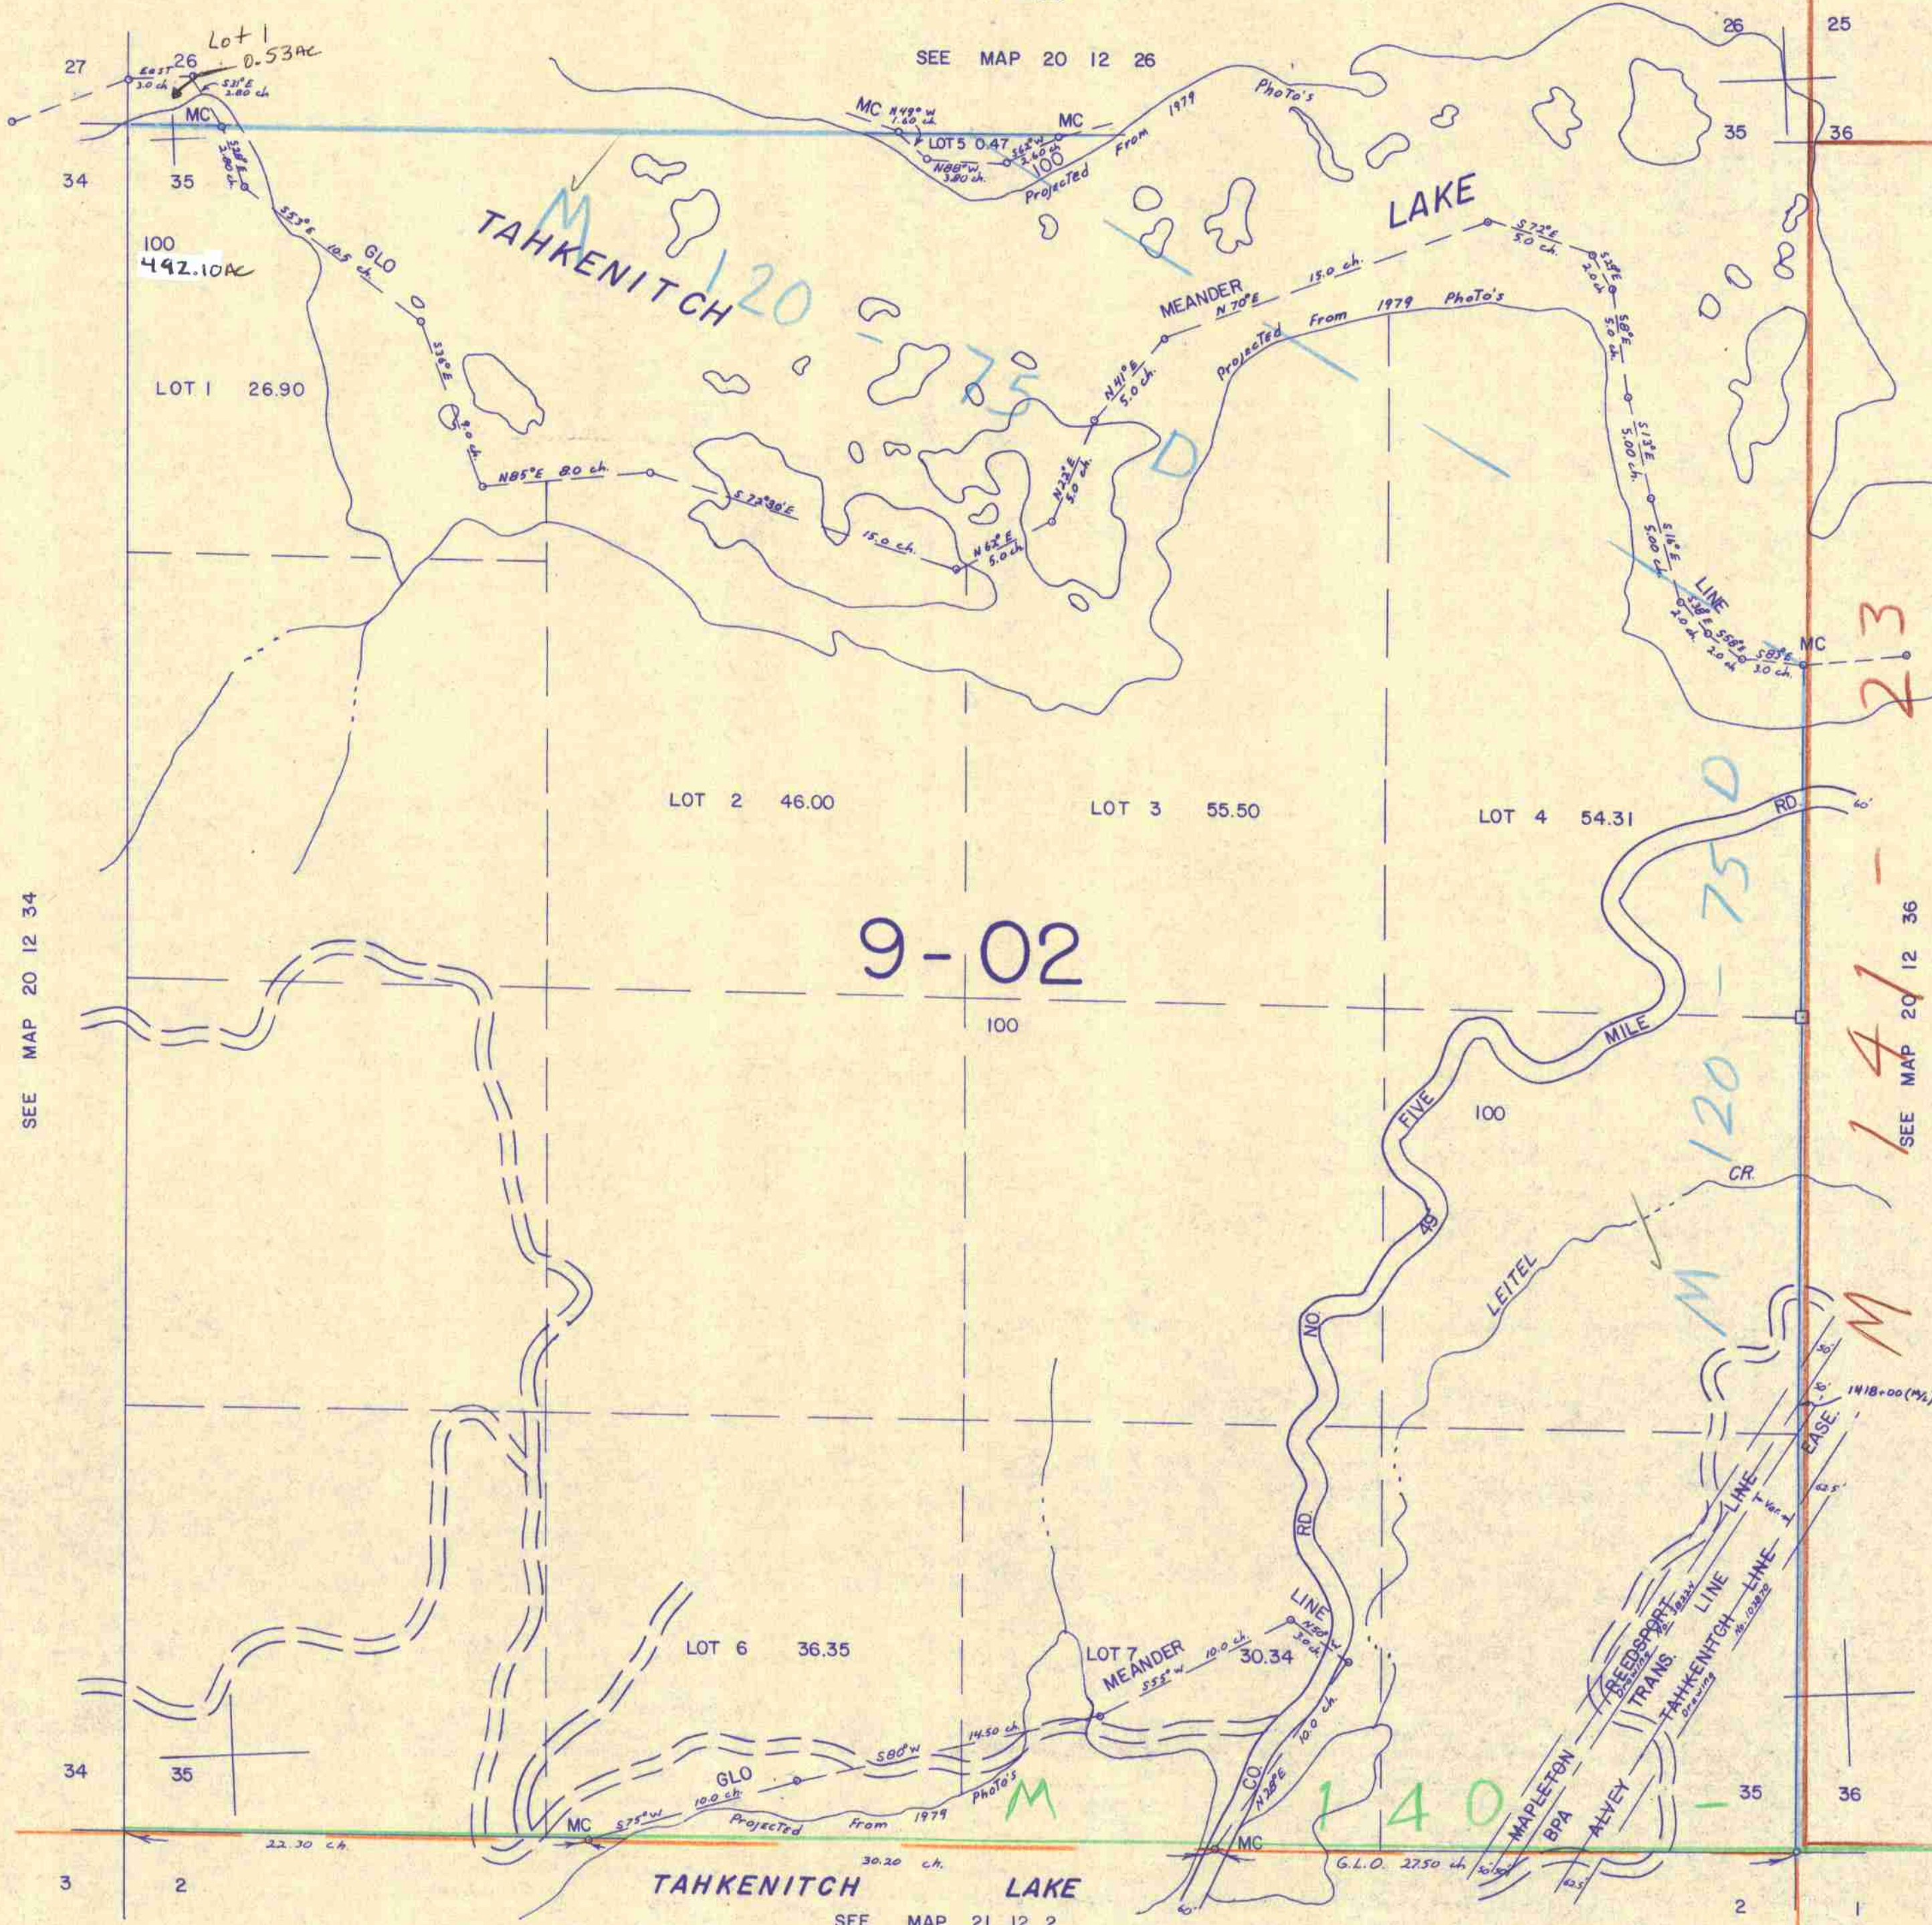

SEE MAP 20 12 34

SEE MAP 20 12 26

9-02

213

141

M

7

M 1 2 7 - 3 9

792,000

1,054,000

20 12 35

3/83 h