THIS MAP WAS PREPARED FOR ASSESSMENT PURPOSE ONLY.

SECTION 2 T.21 S. R.4W. W.M.
DOUGLAS COUNTY
1" = 400'
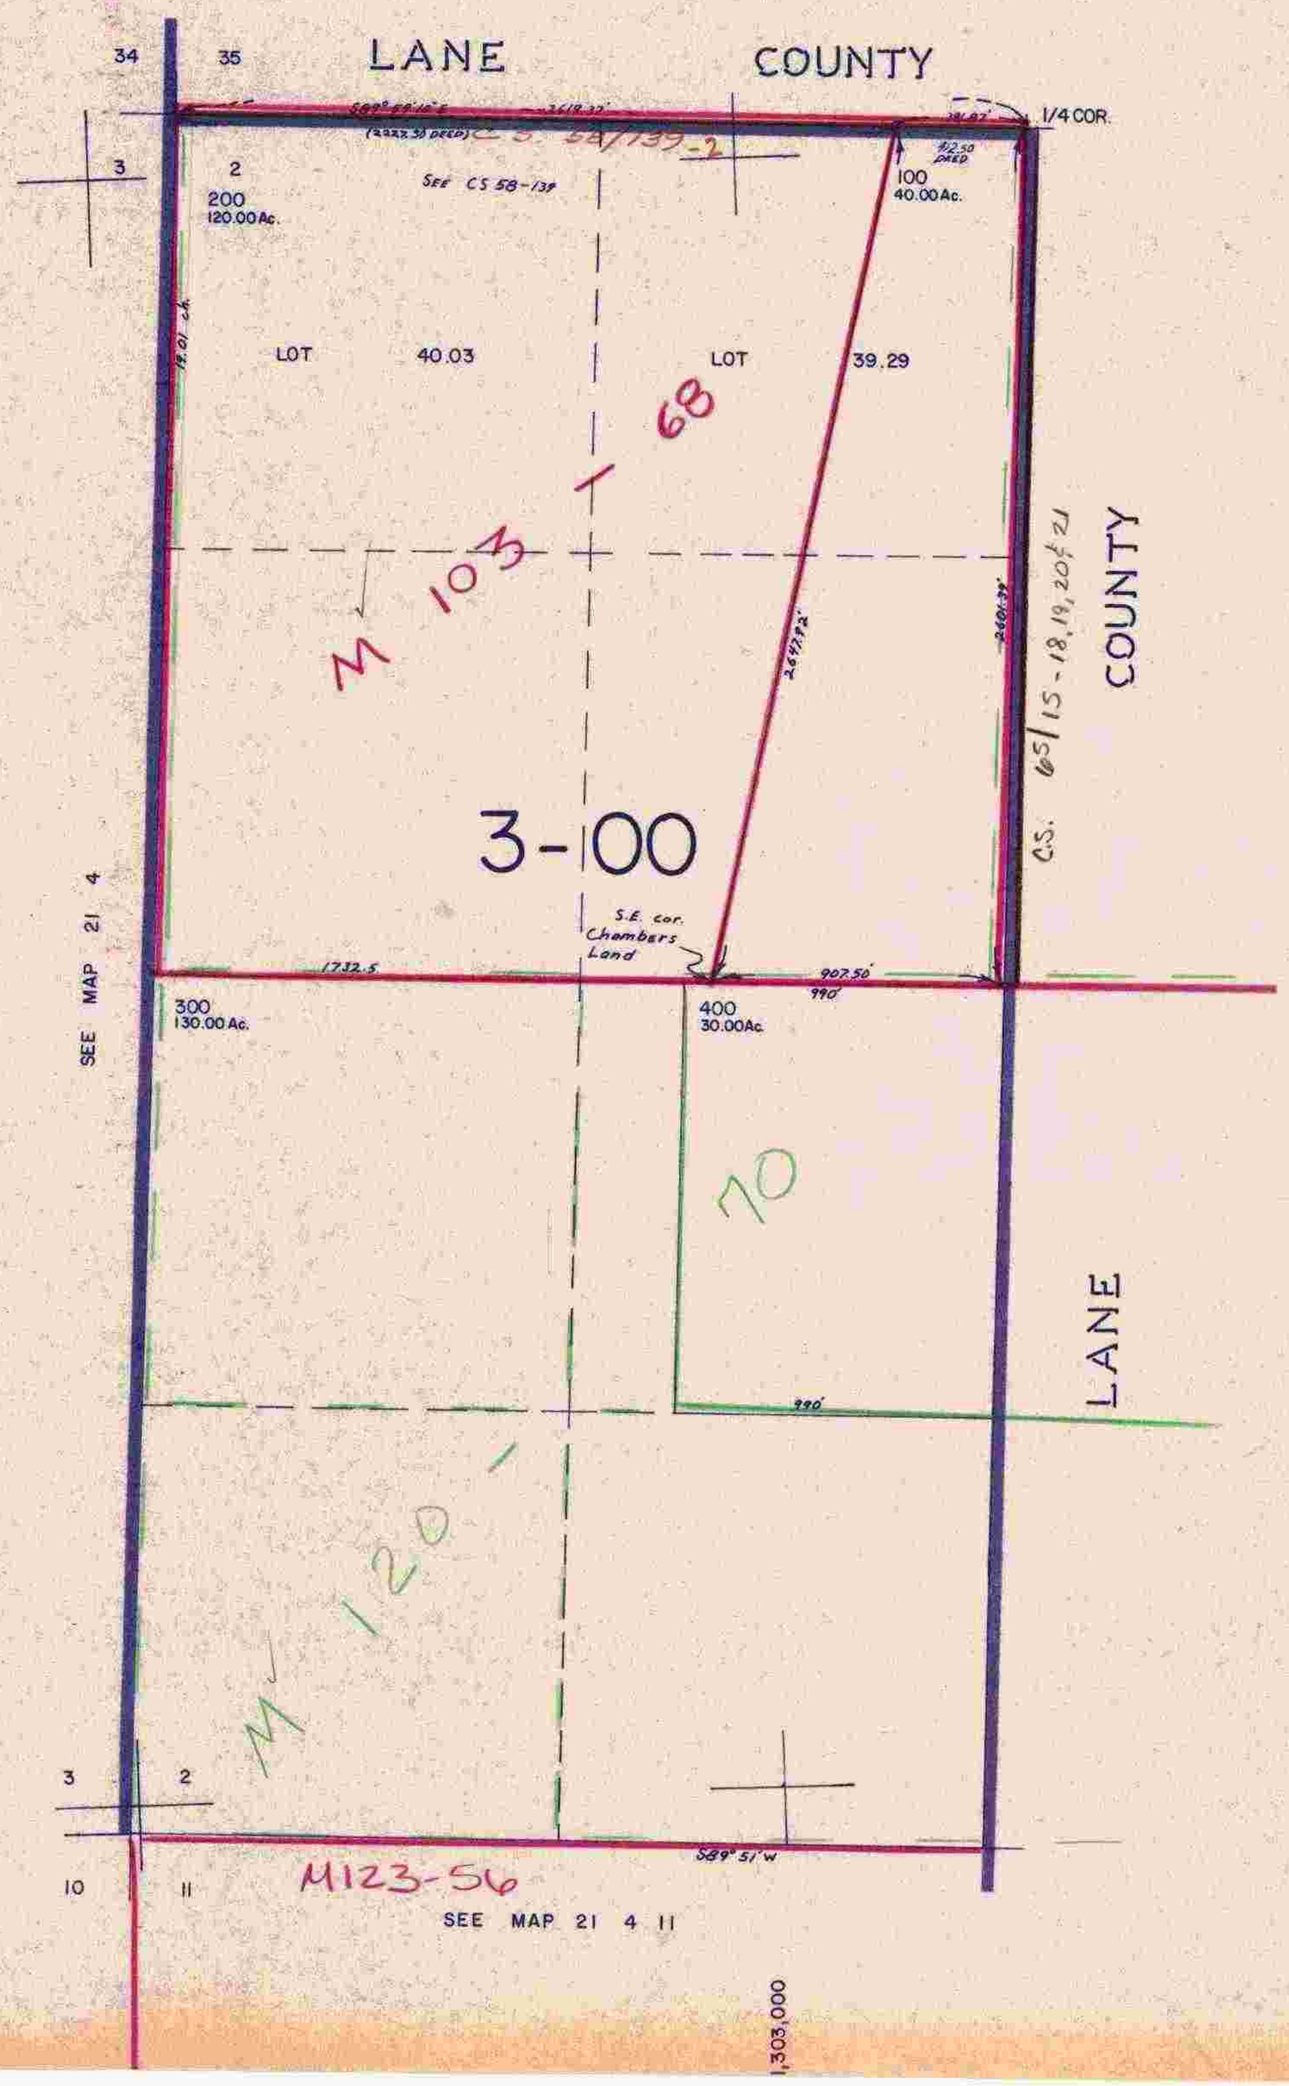
21 4 2