


SECTION 21 T.21S. R.5W. W.M.  
DOUGLAS COUNTY

REVISED ON  
4-01-92

21 5 21

1" = 400'

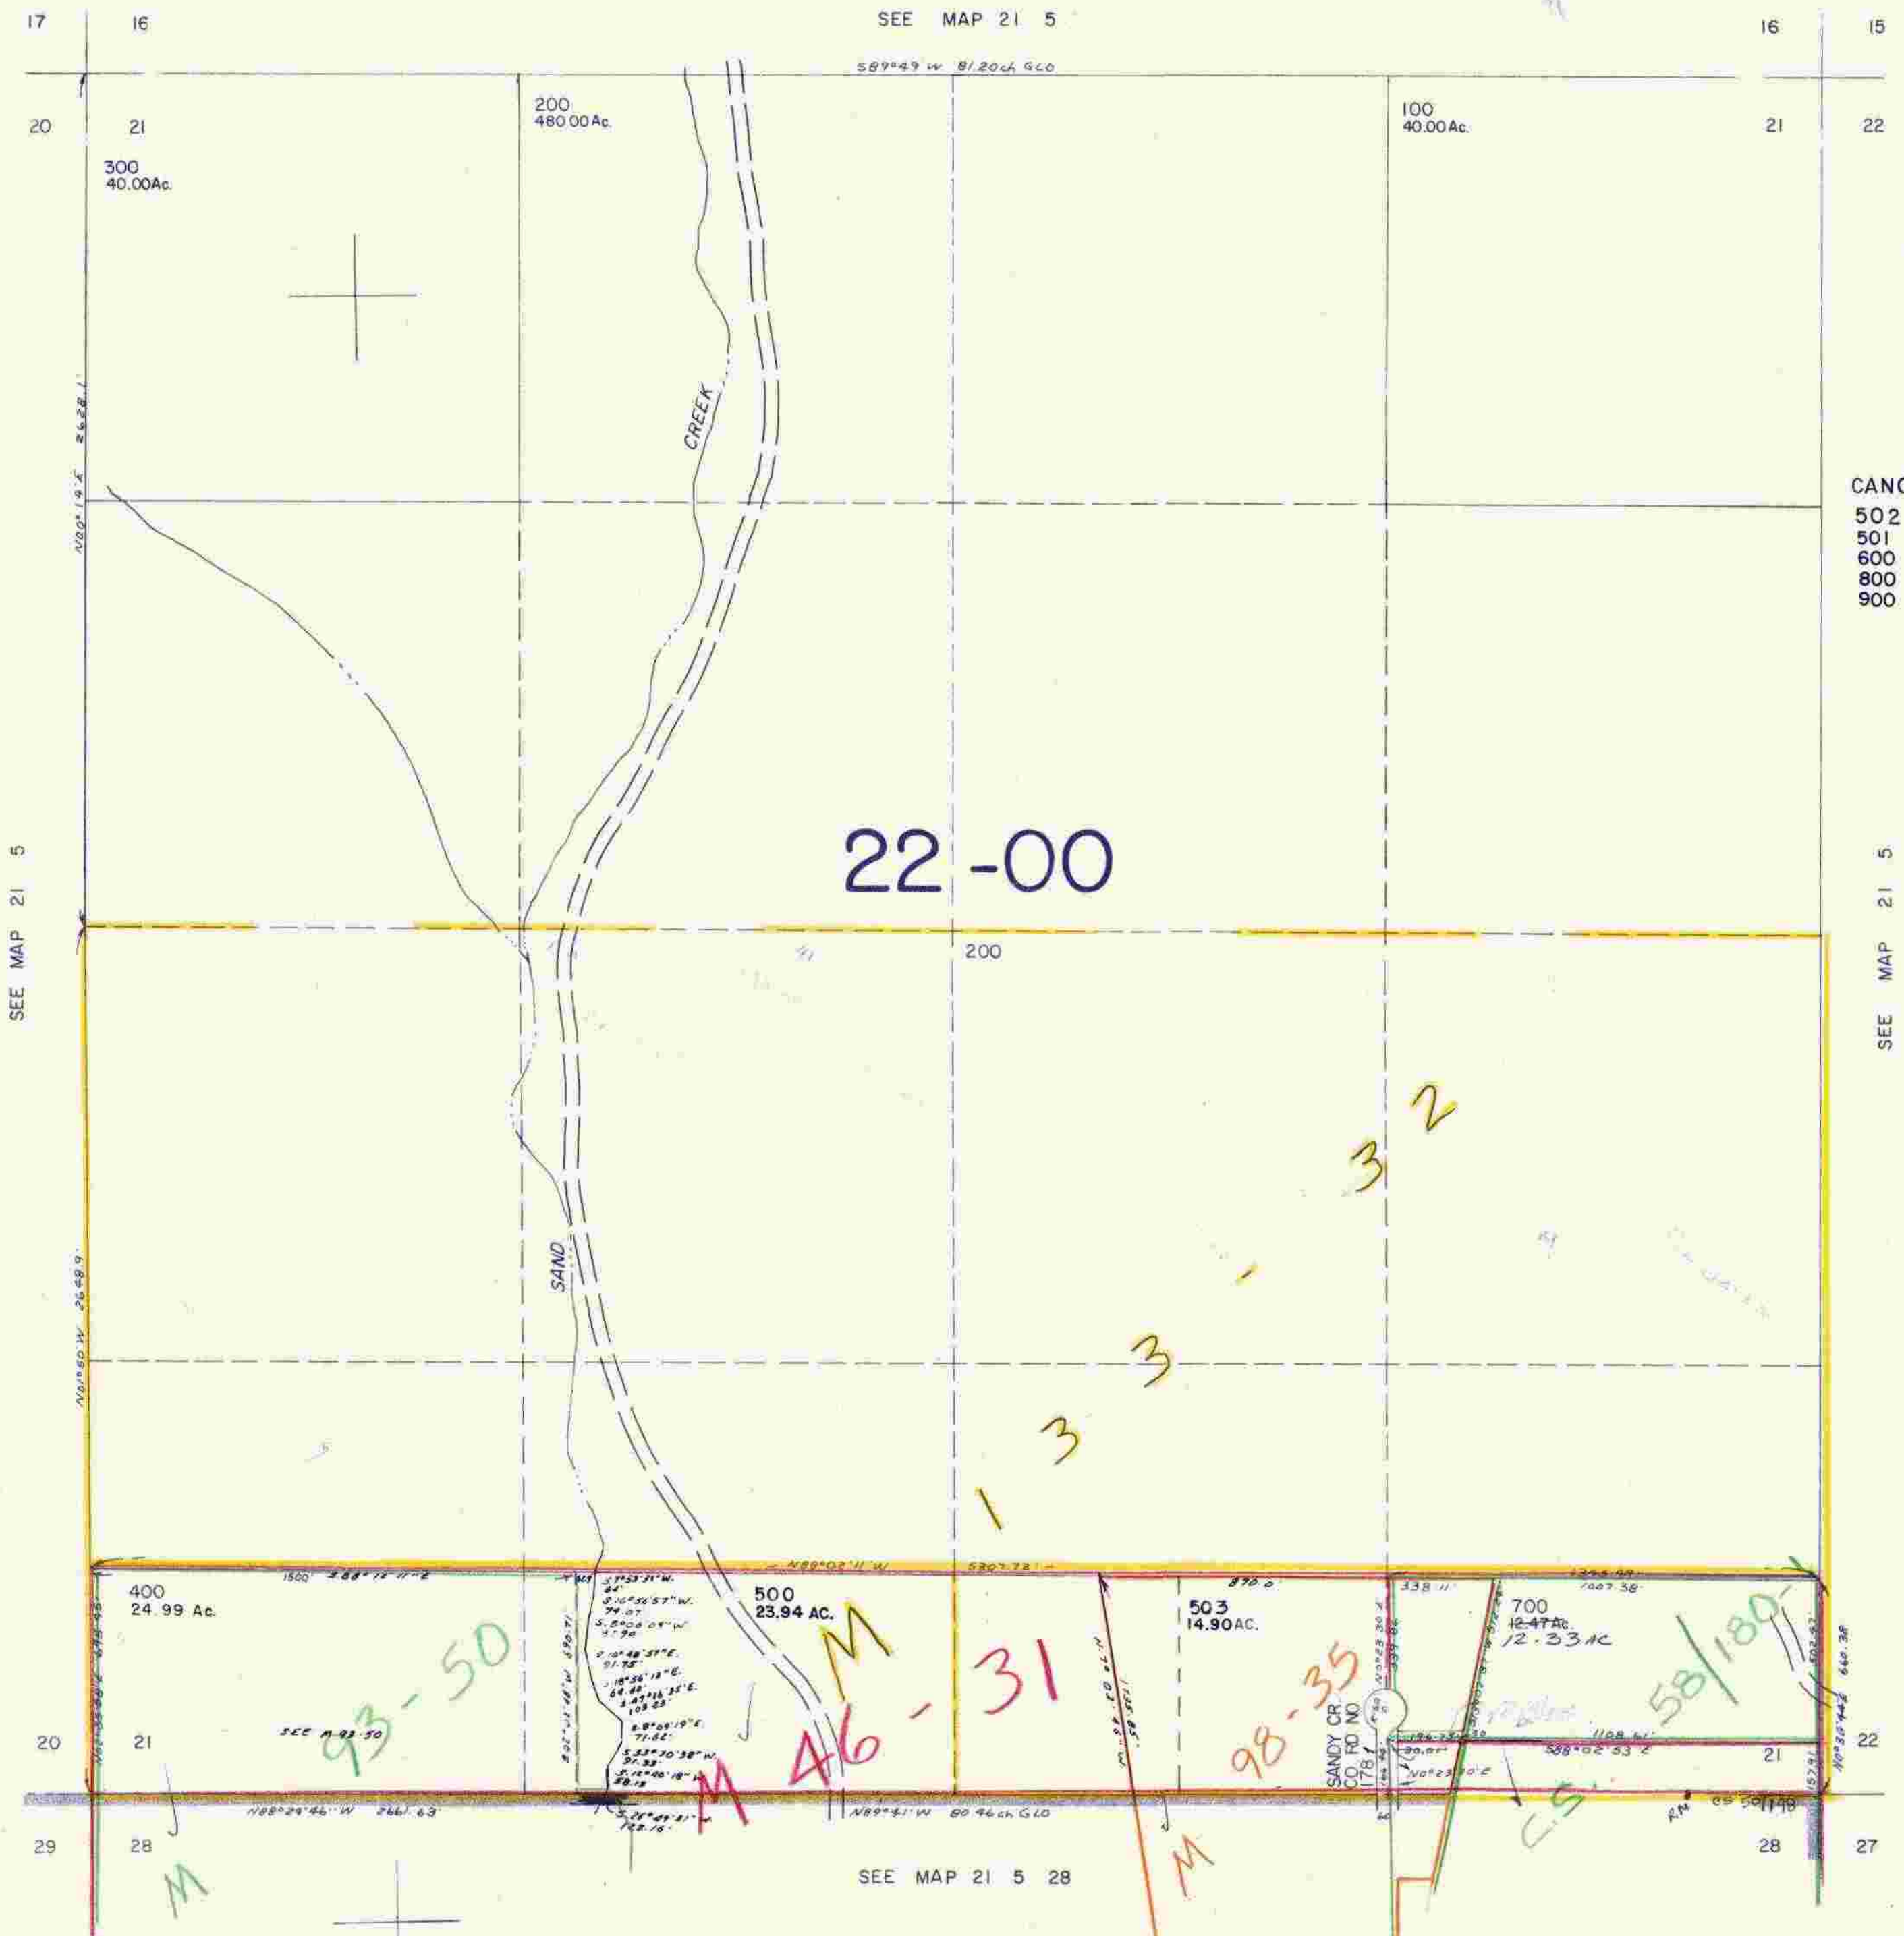

CANCELLED PARCEL NO'S  
502  
501  
600  
800  
900  
*701*

761,000

21 5 21