


THIS MAP WAS PREPARED FOR ASSESSMENT PURPOSE ONLY.

T.21S. R.9W. W.M.
DOUGLAS COUNTY

1" = 2000'
SEE MAP 20 9 M170-29

21 9
& INDEX

Cancelled No's
300 300 M1
400 700 M1
700 800 M1
900 900 M1
1000 2100

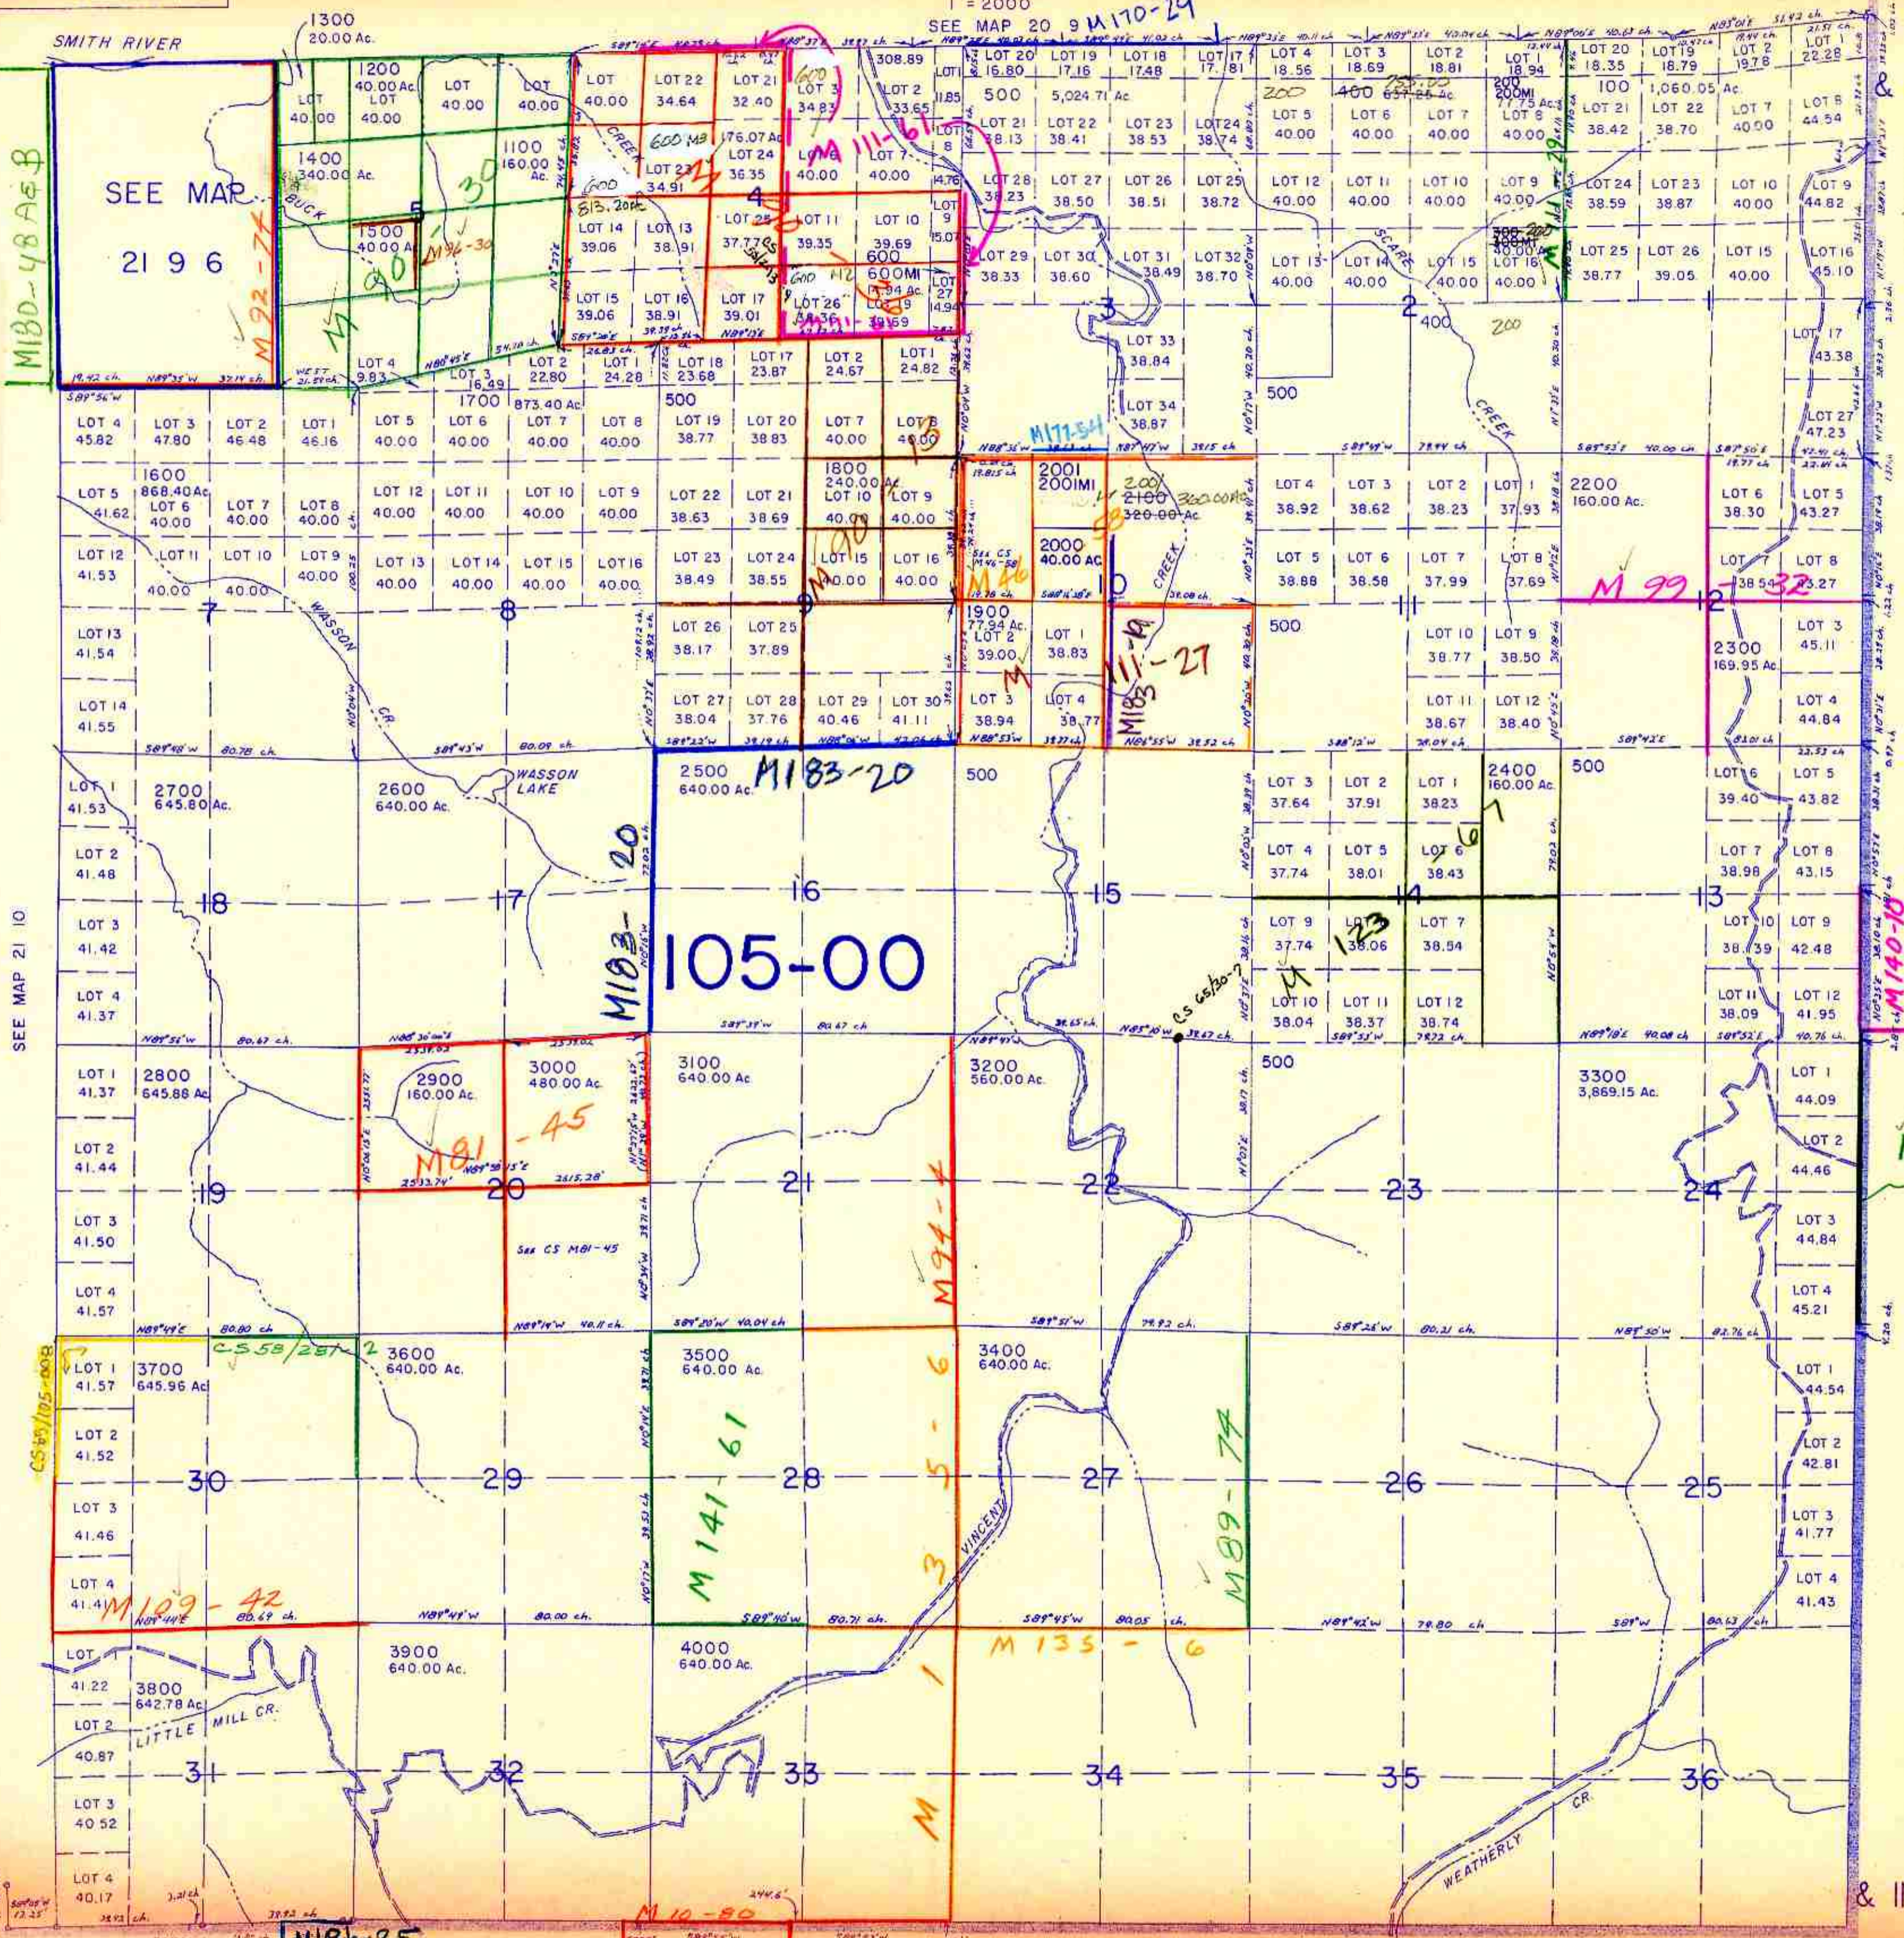

SEE MAP 21 10

SEE MAP 21 8

SEE MAP 22 9

21 9
& INDEX

12/89