


THIS MAP WAS PREPARED FOR ASSESSMENT PURPOSE ONLY.

SECTION 4 T.21S. R.10W. W.M.
DOUGLAS COUNTY

1" = 400'

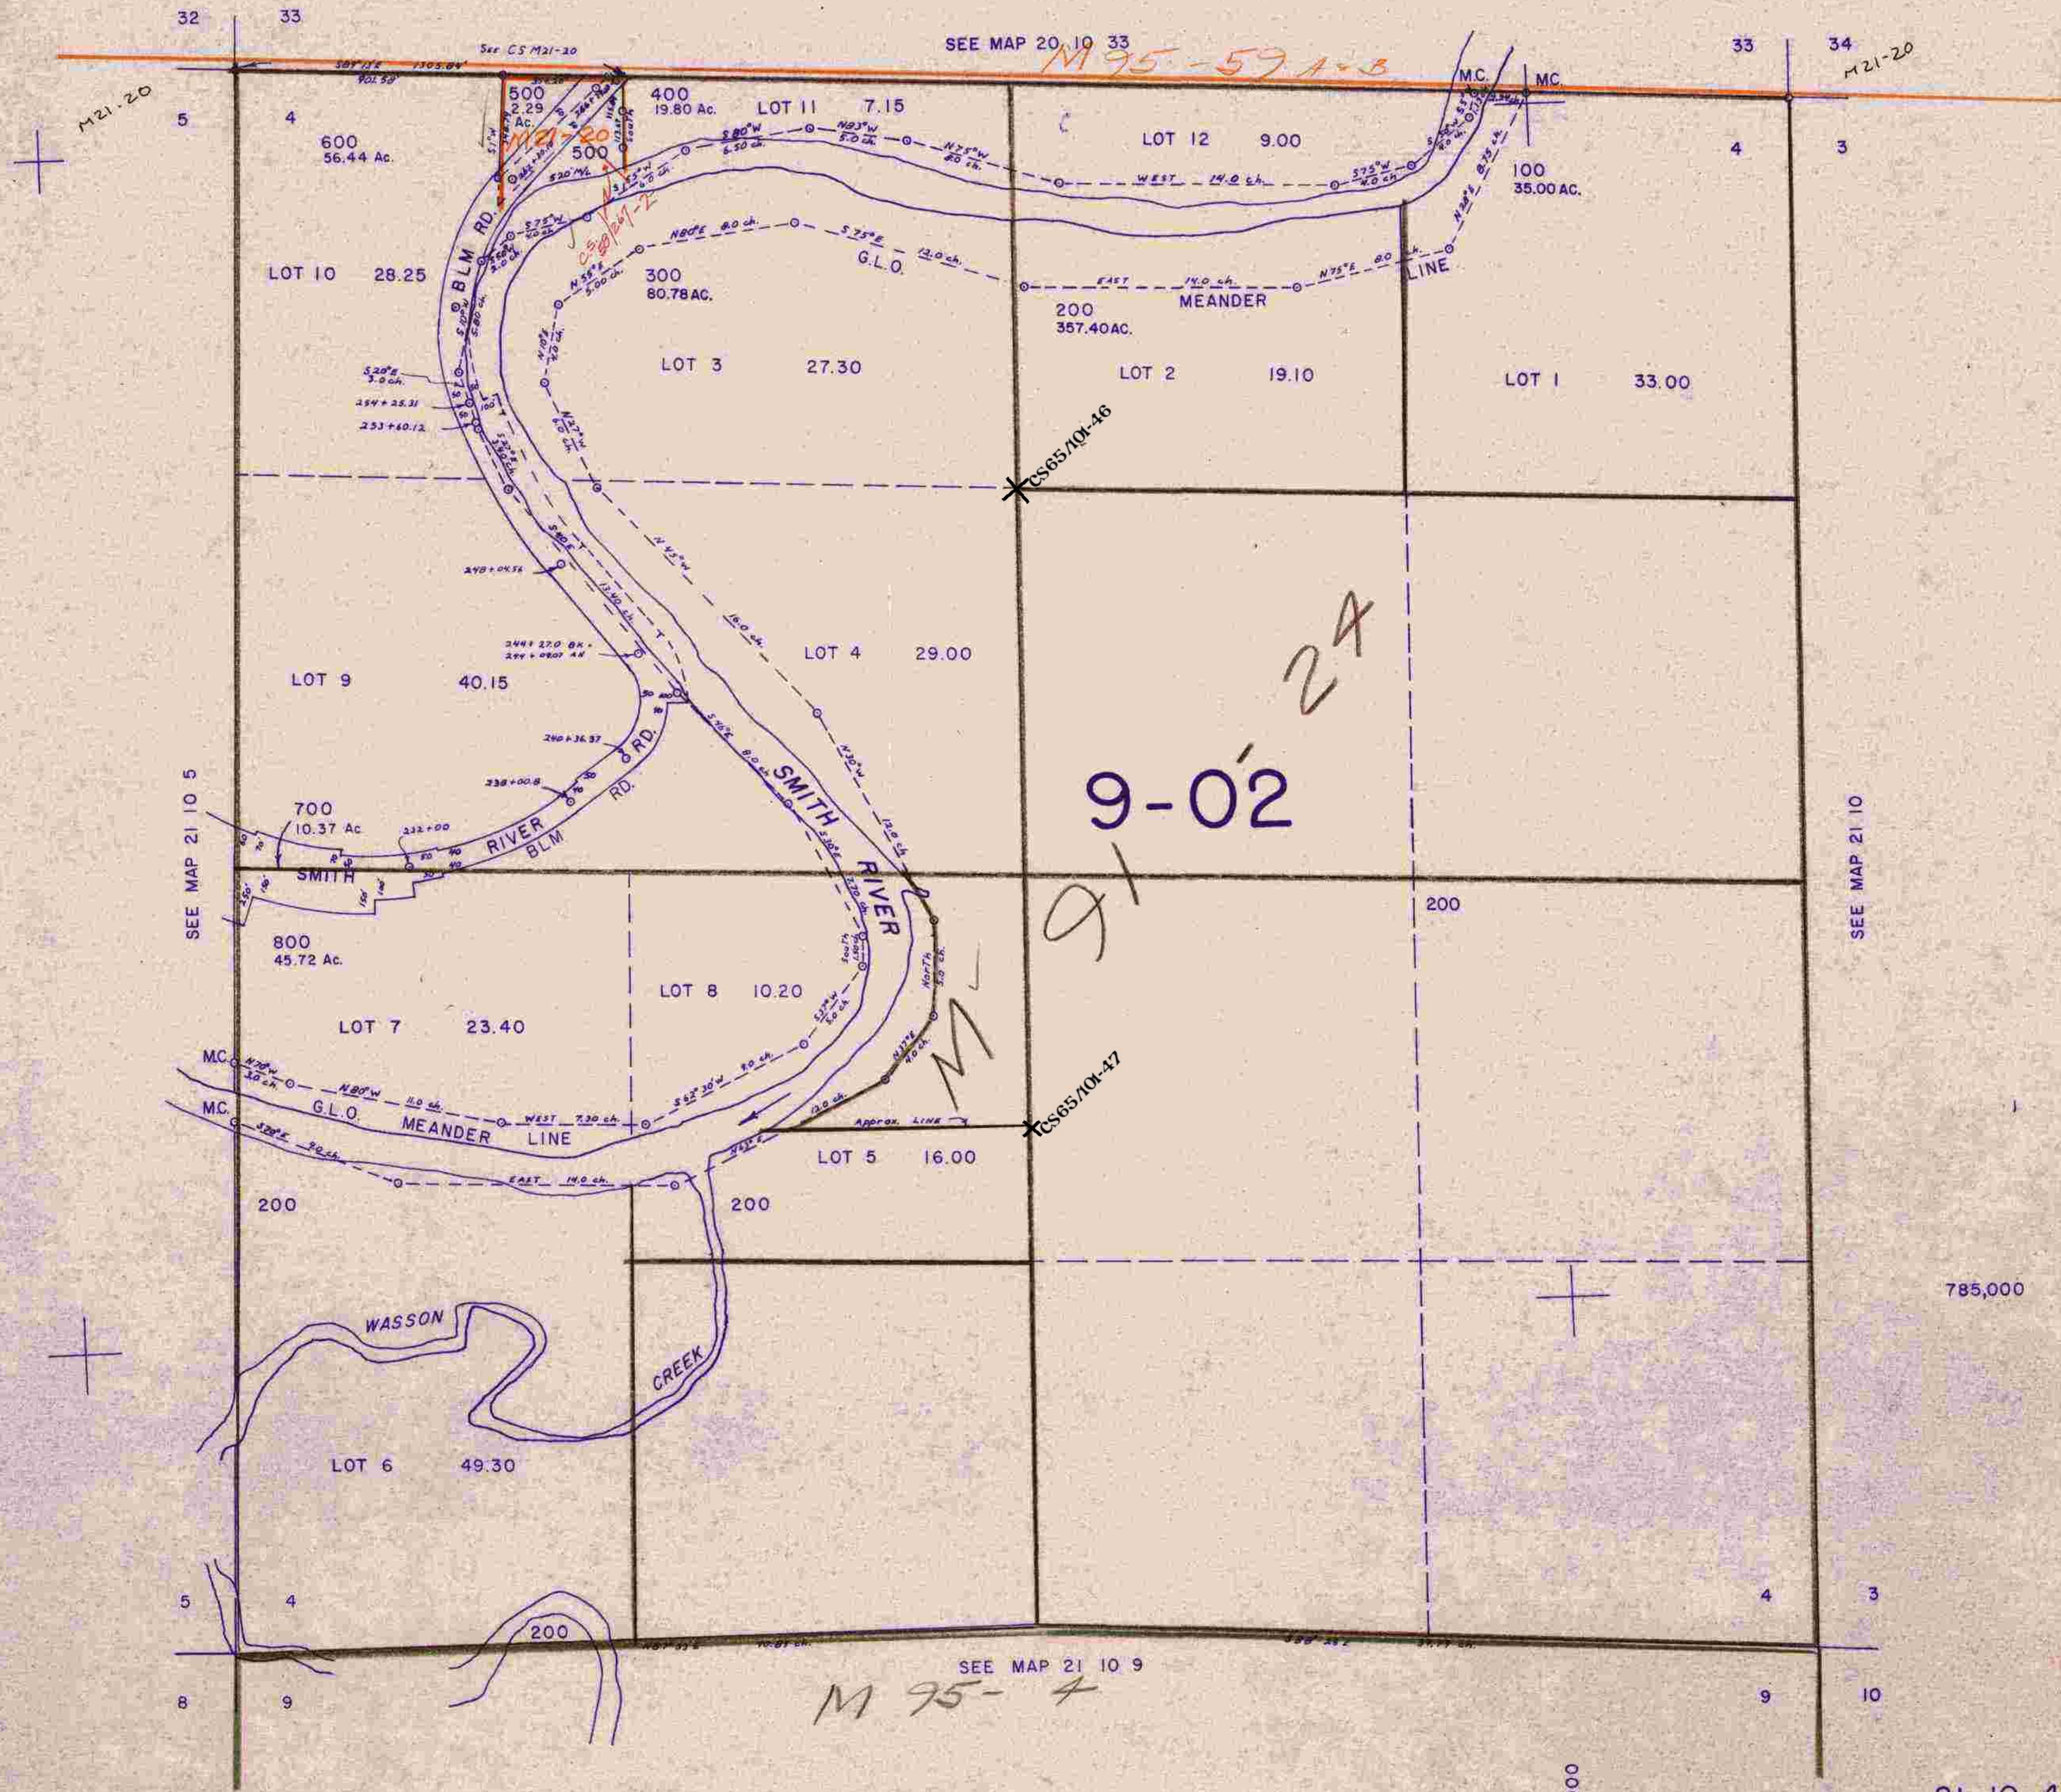

M 95-59A-B

9-02
24

M 95-4

785,000

1,105,000

3/83 JR