


THIS MAP WAS PREPARED FOR ASSESSMENT PURPOSE ONLY.

SECTION 31 T.21S. R.10W. W.M.
DOUGLAS COUNTY

21 10 31

1" = 400'

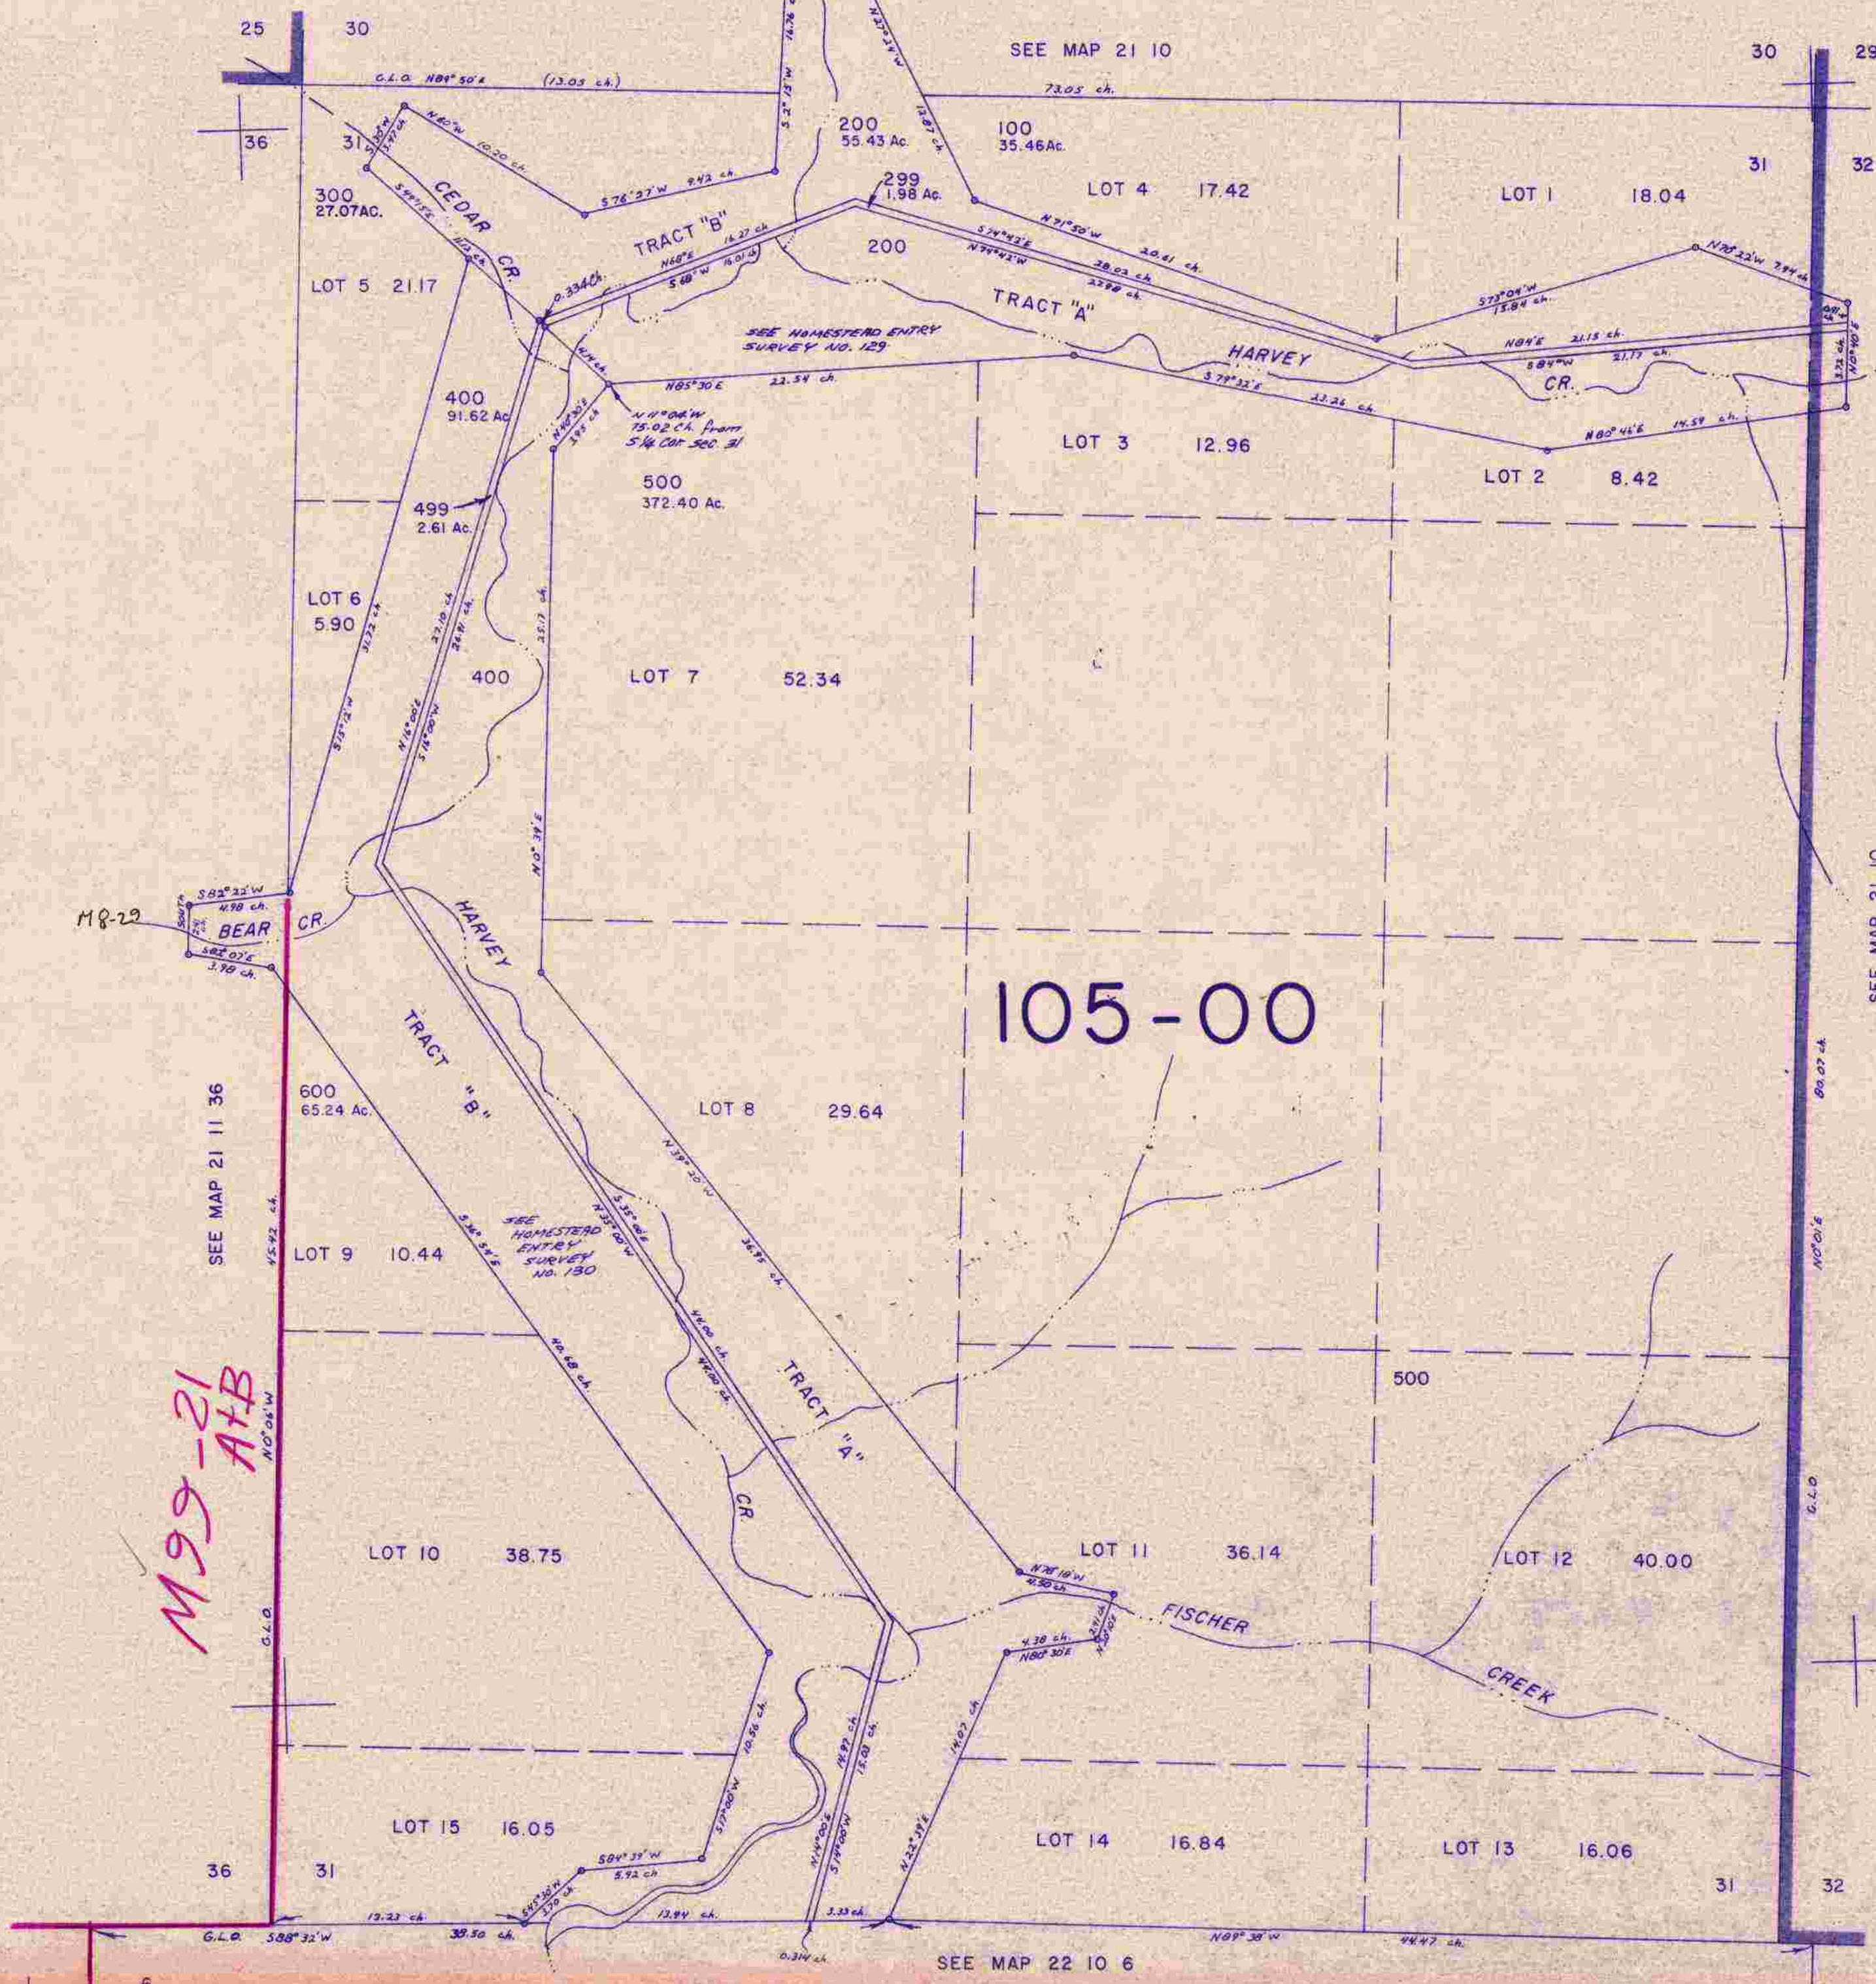

M9-22

M99-21
A+B

105-00

759,000

21 10 31

3/03R