SECTION 17 T.21S. R.11W. W.M.
DOUGLAS COUNTY

1"=400'

REVISED ON
6-14-93

21 11 17
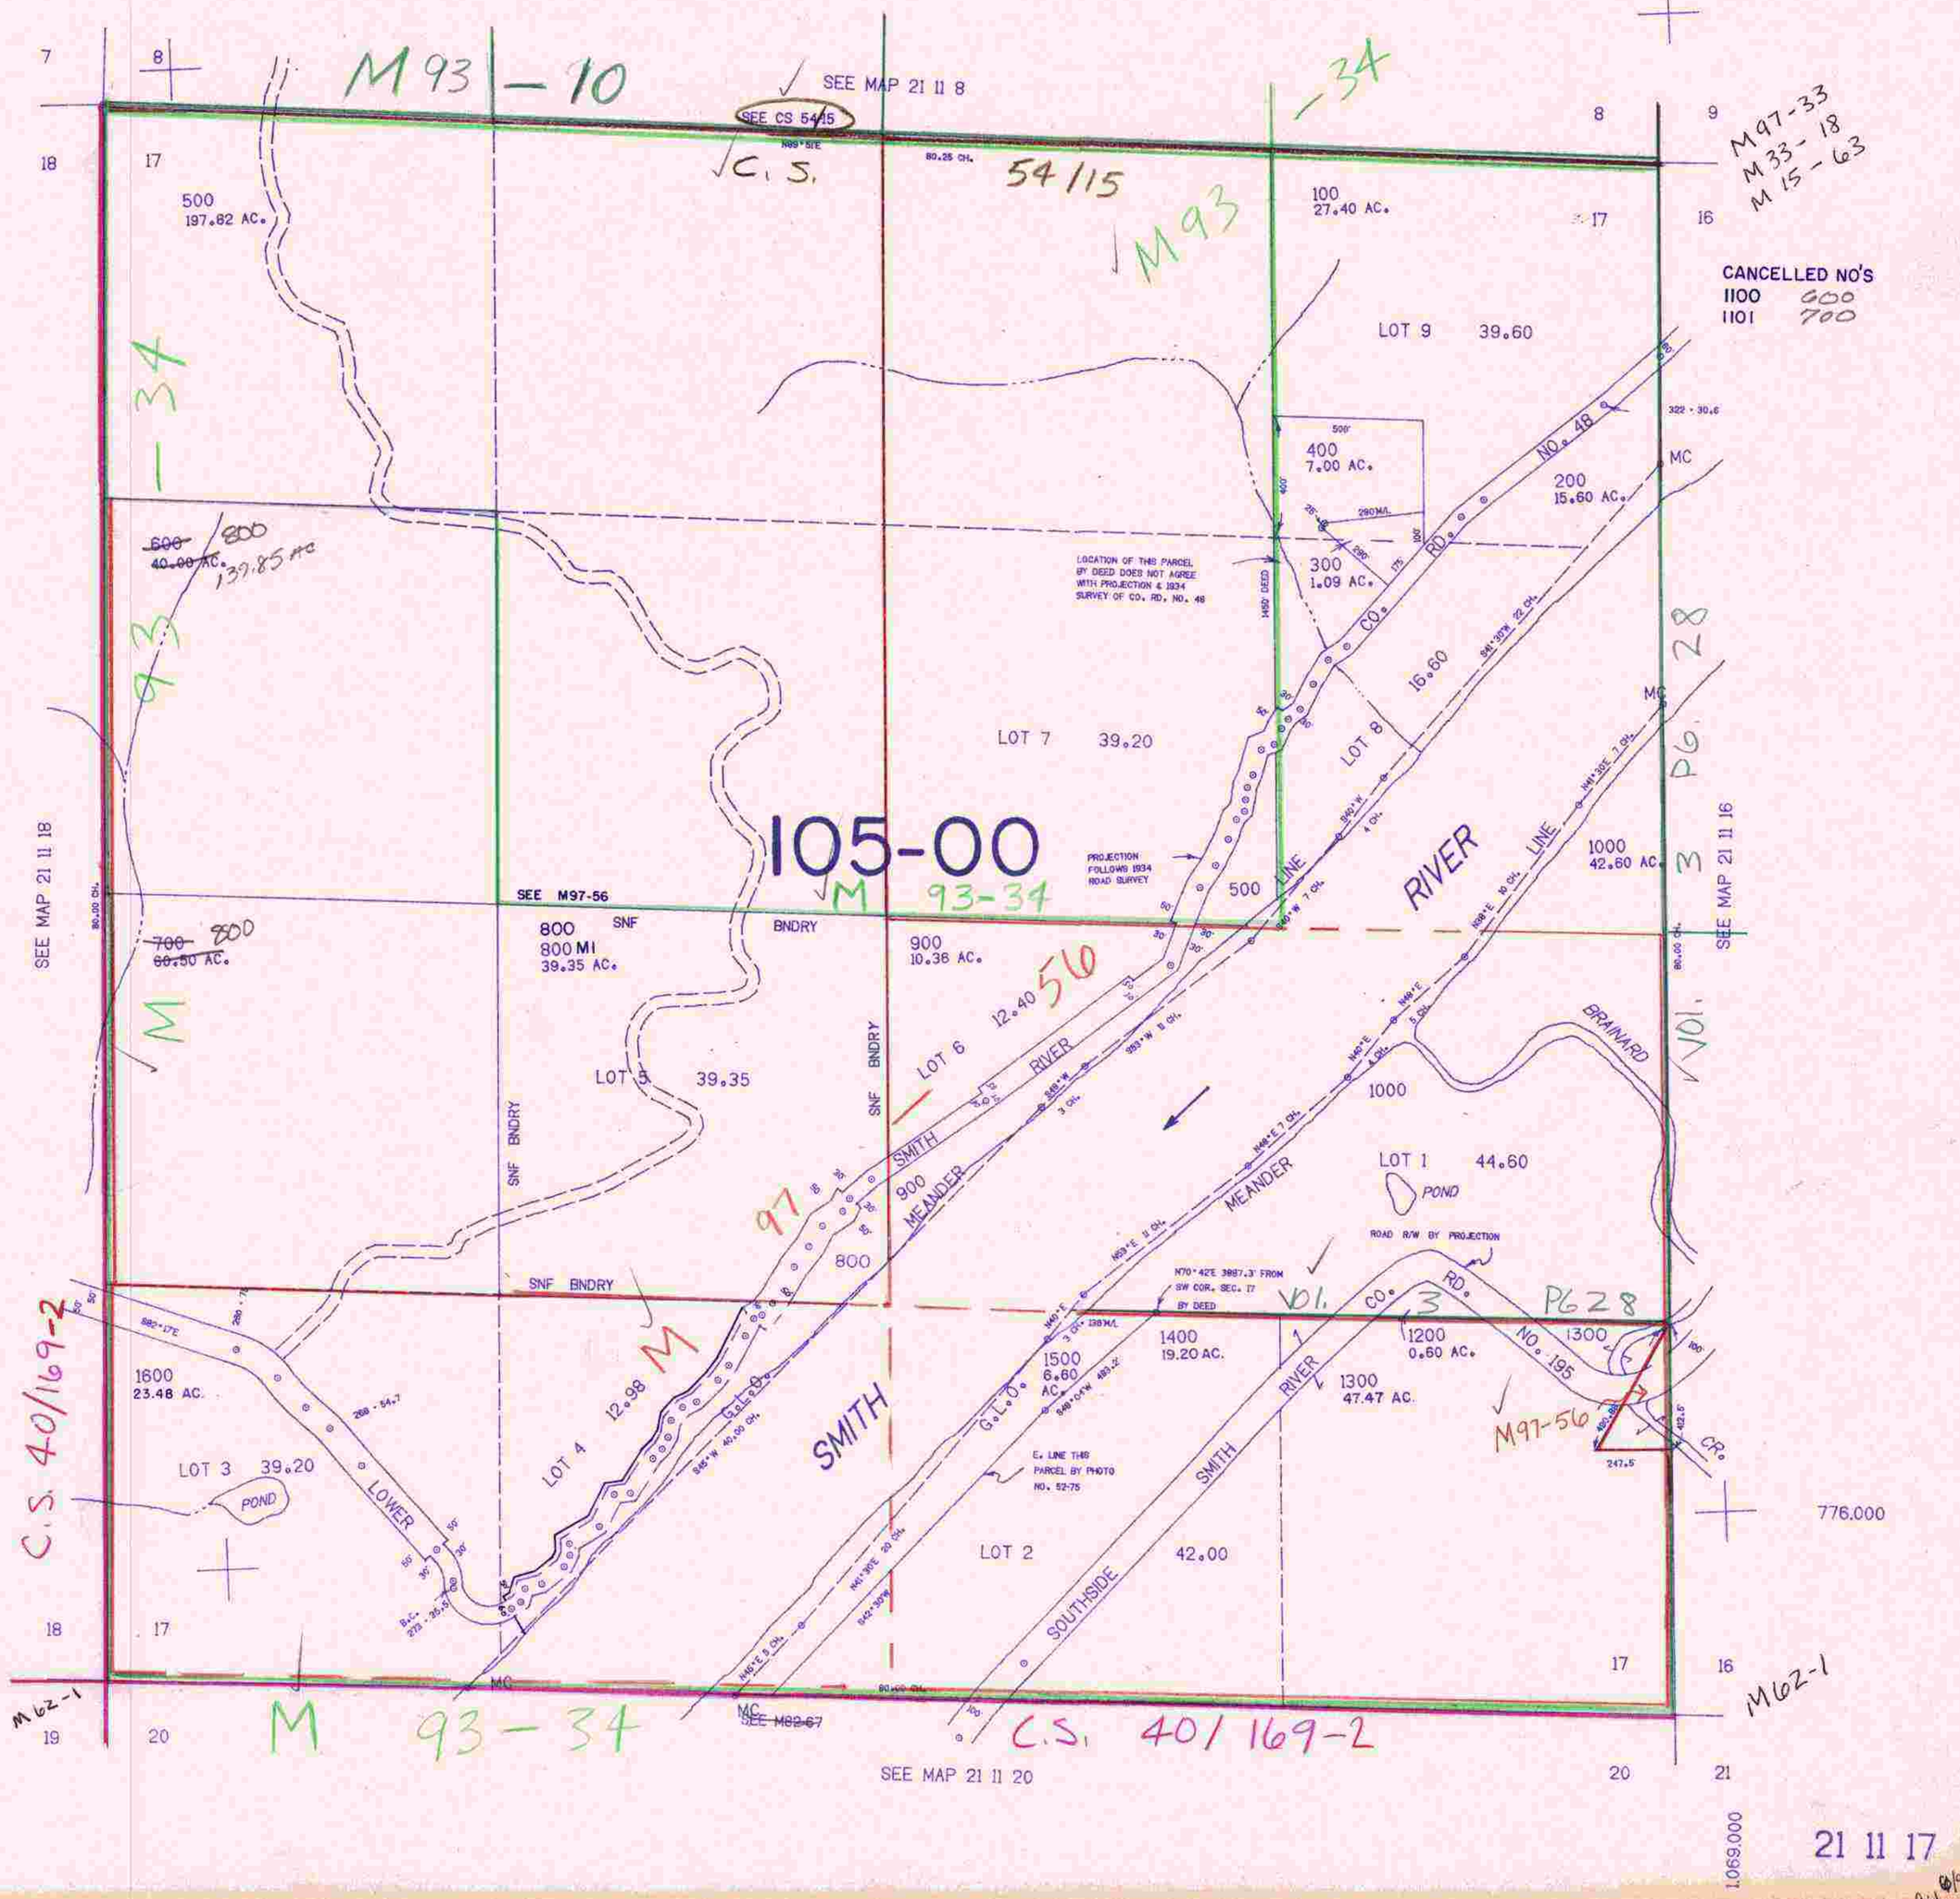
THIS MAP WAS PREPARED FOR ASSESSMENT PURPOSE ONLY.