THIS MAP WAS PREPARED FOR ASSESSMENT PURPOSE ONLY.

SECTION 33 T. 21 S. R. 11 W. W.M.
DOUGLAS COUNTY
1" = 400'

21 11 33
(2 OF 2)

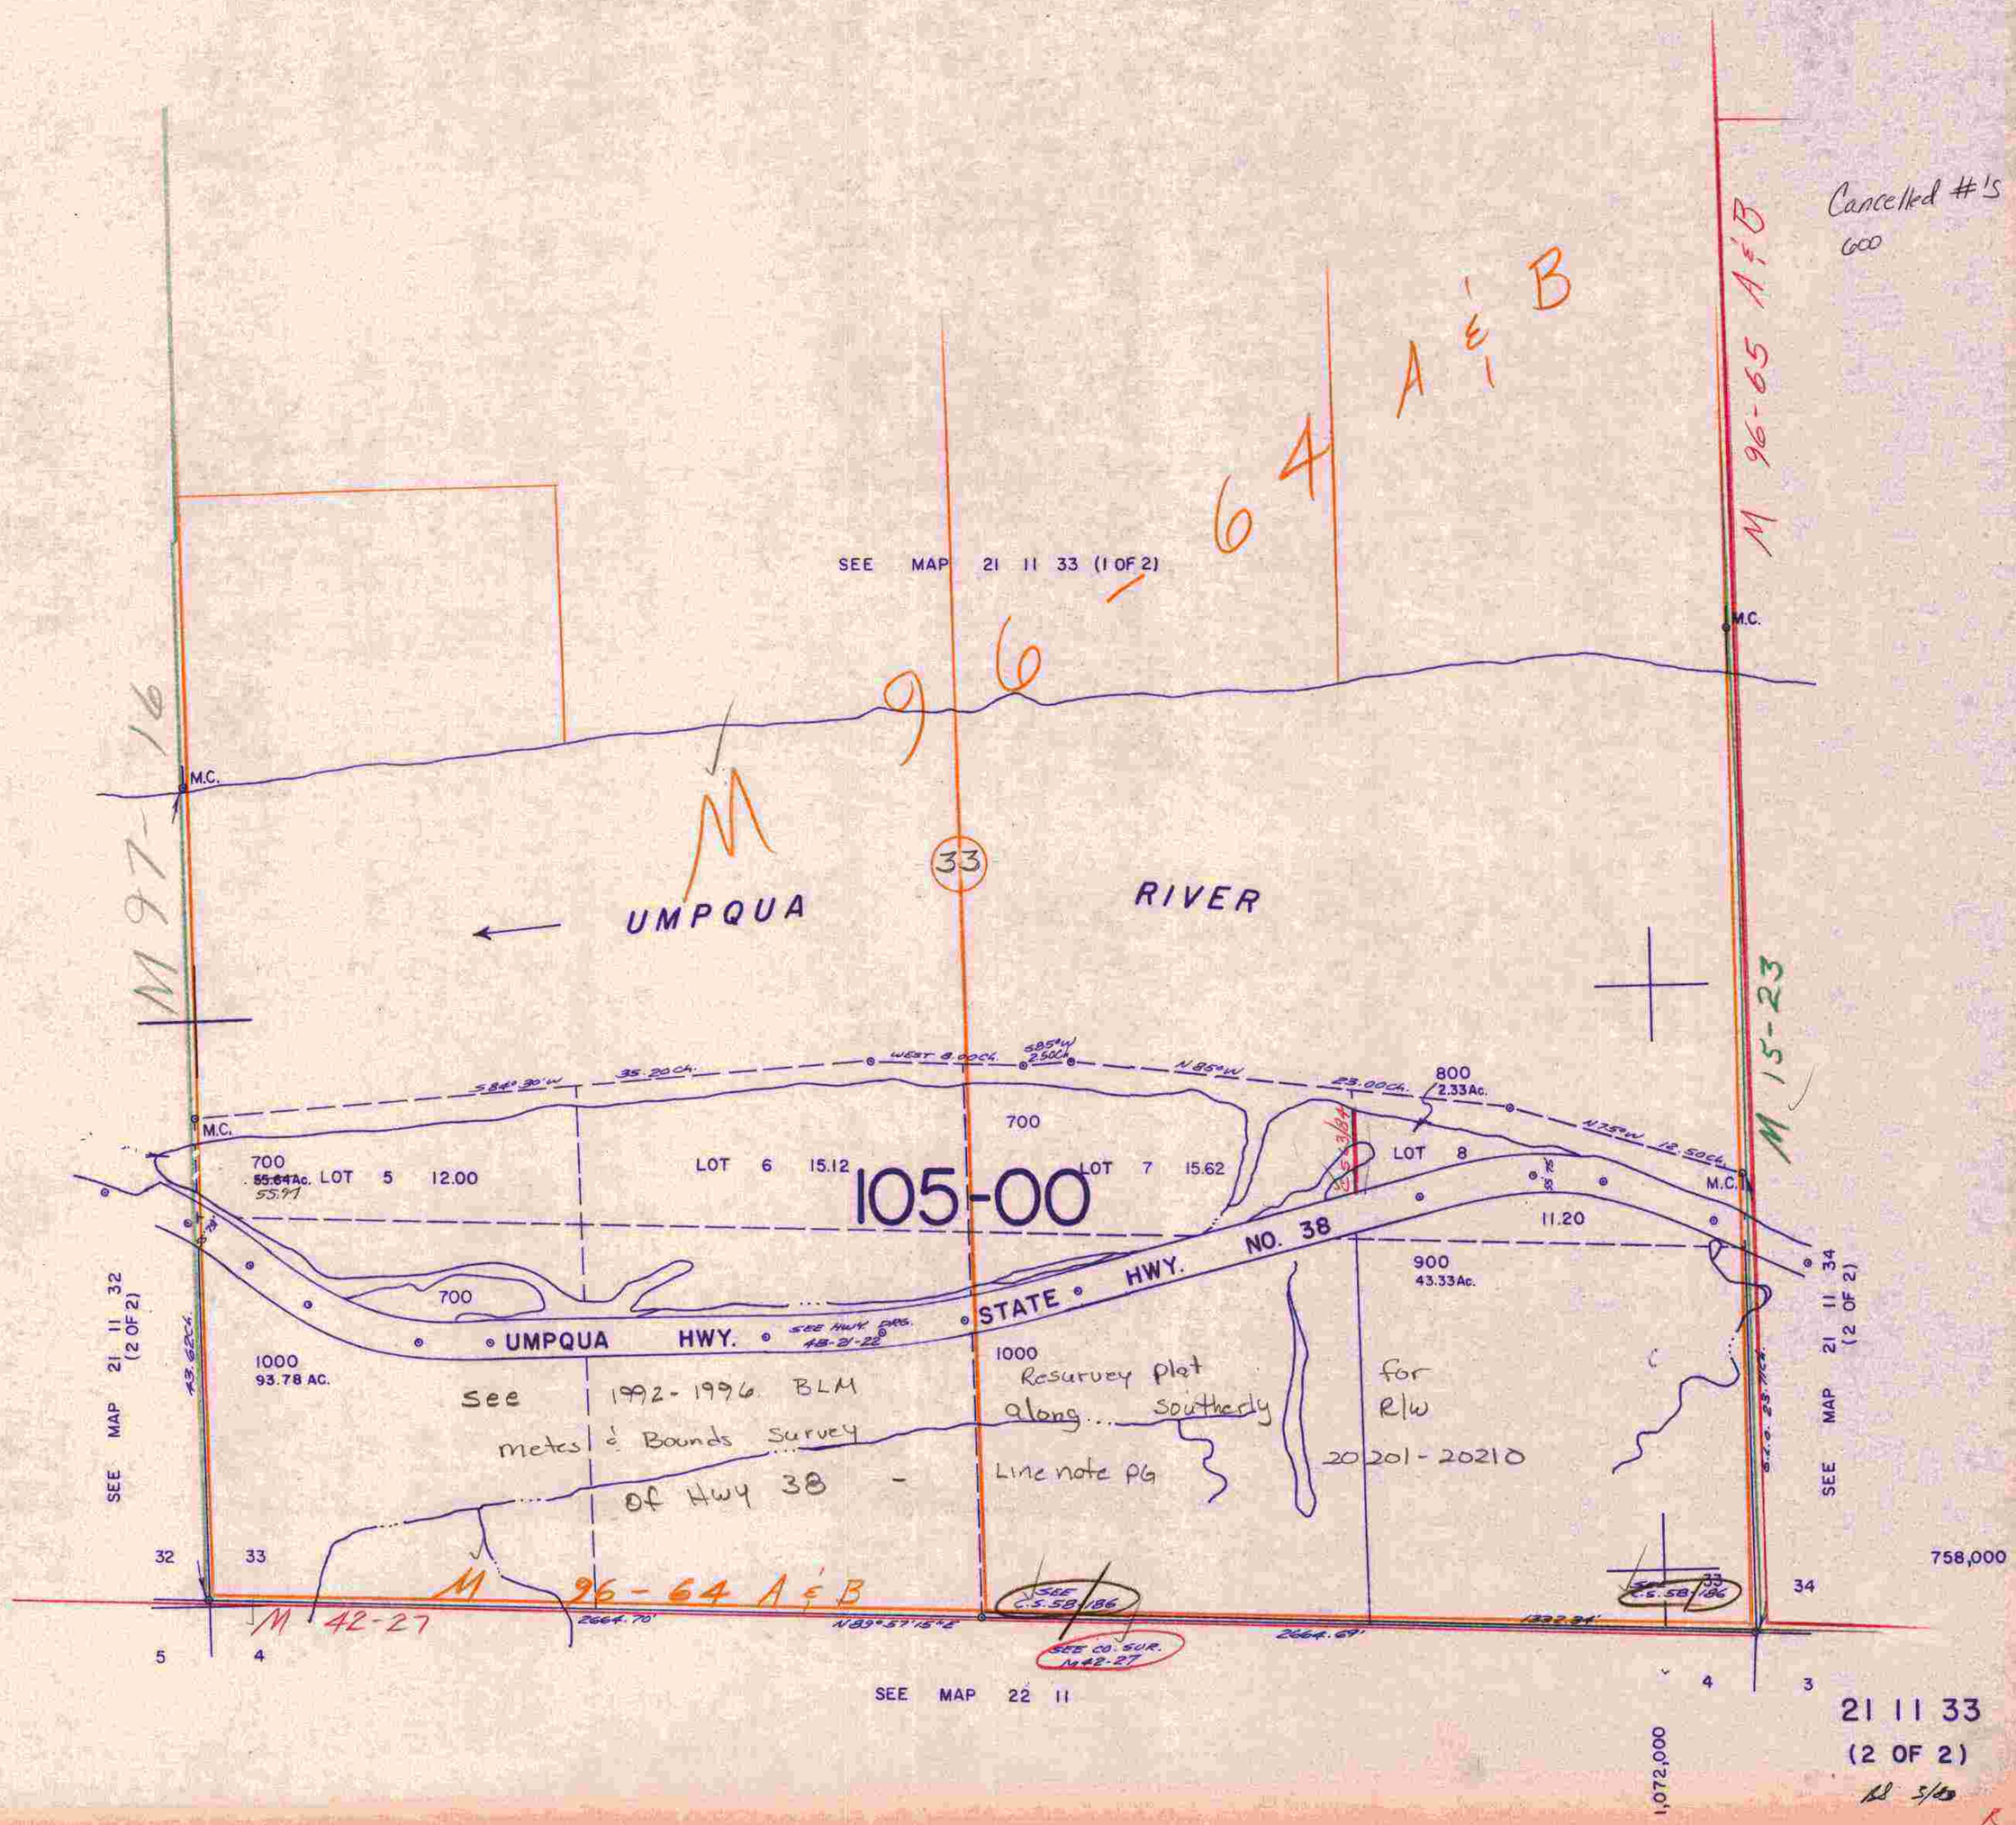

21 11 33
(2 OF 2)