THIS MAP WAS PREPARED FOR ASSESSMENT PURPOSE ONLY.

SECTION 2 T.21S. R.12W. W.M.
DOUGLAS COUNTY

1"=400'
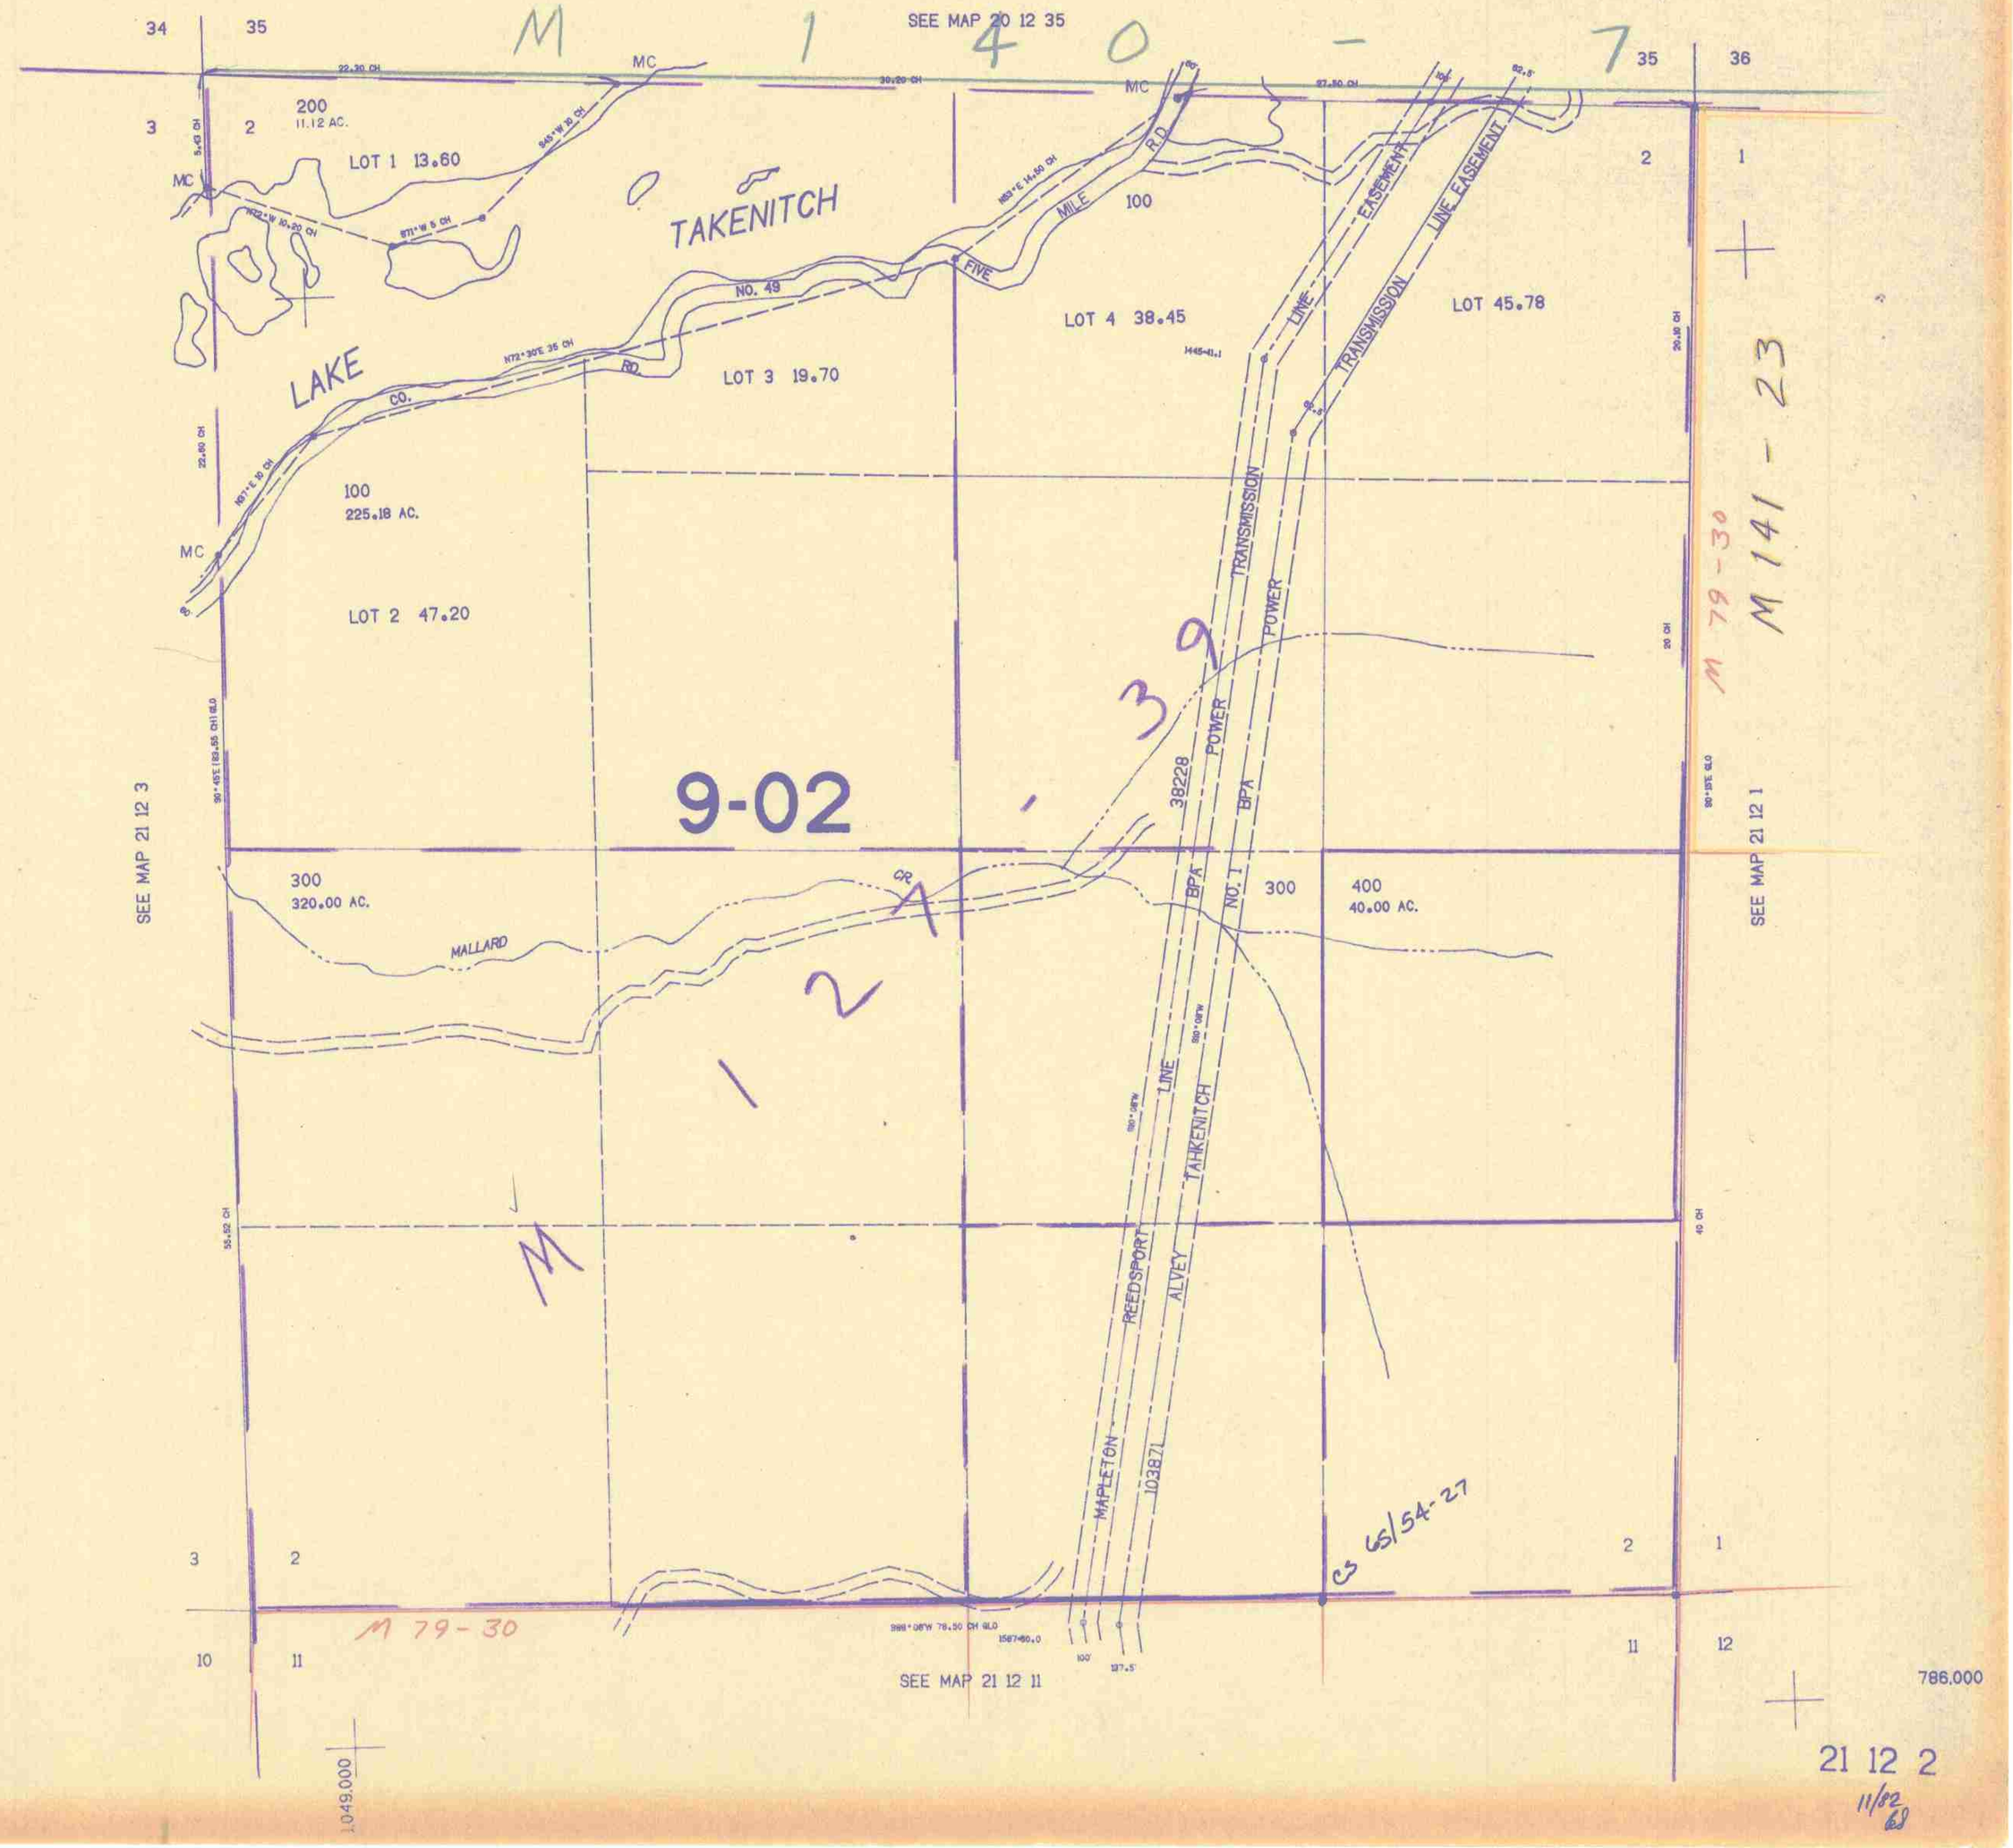
21 12 2