


SECTION 5 T.21S. R.12W. W.M.
DOUGLAS COUNTY

21 12 5

THIS MAP WAS PREPARED FOR
ASSESSMENT PURPOSE ONLY.

1"=400'

SEE MAP 20 12 32

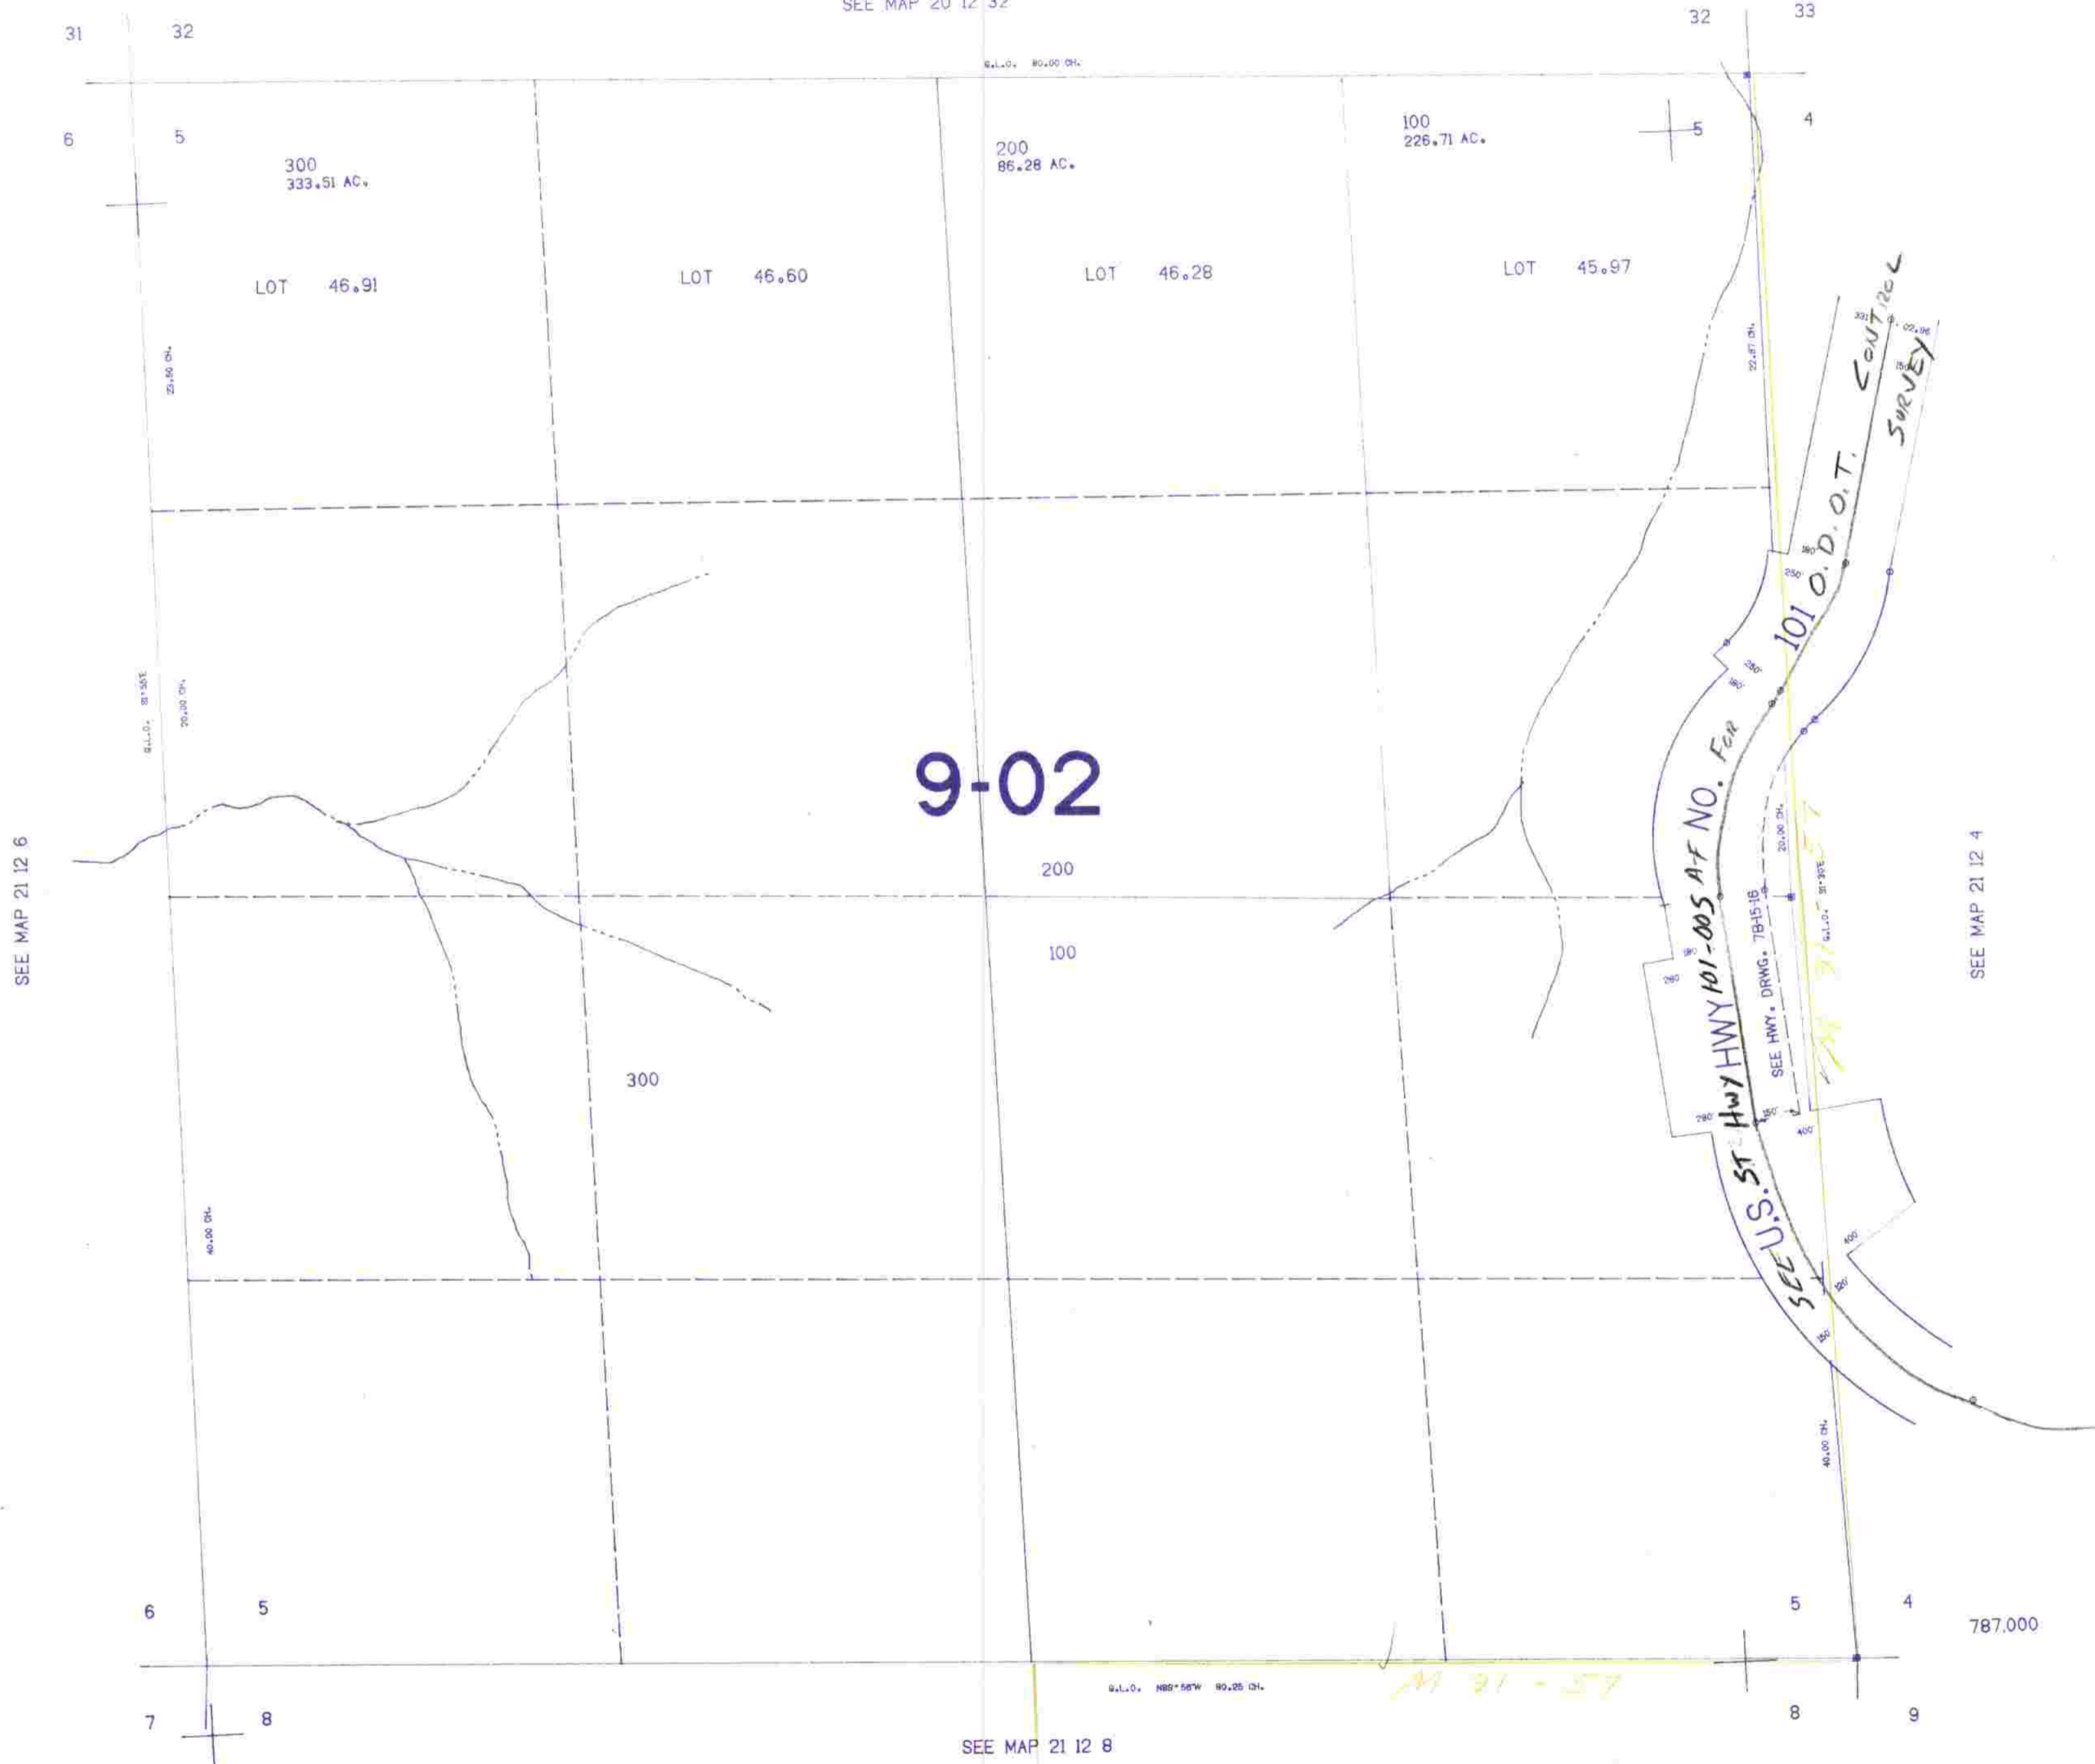

9-02

21 12 5

11/82
PB