SECTION 16 T.21S. R.12W. W.M.
DOUGLAS COUNTY

1"=400'

THIS MAP WAS PREPARED FOR ASSESSMENT PURPOSE ONLY.

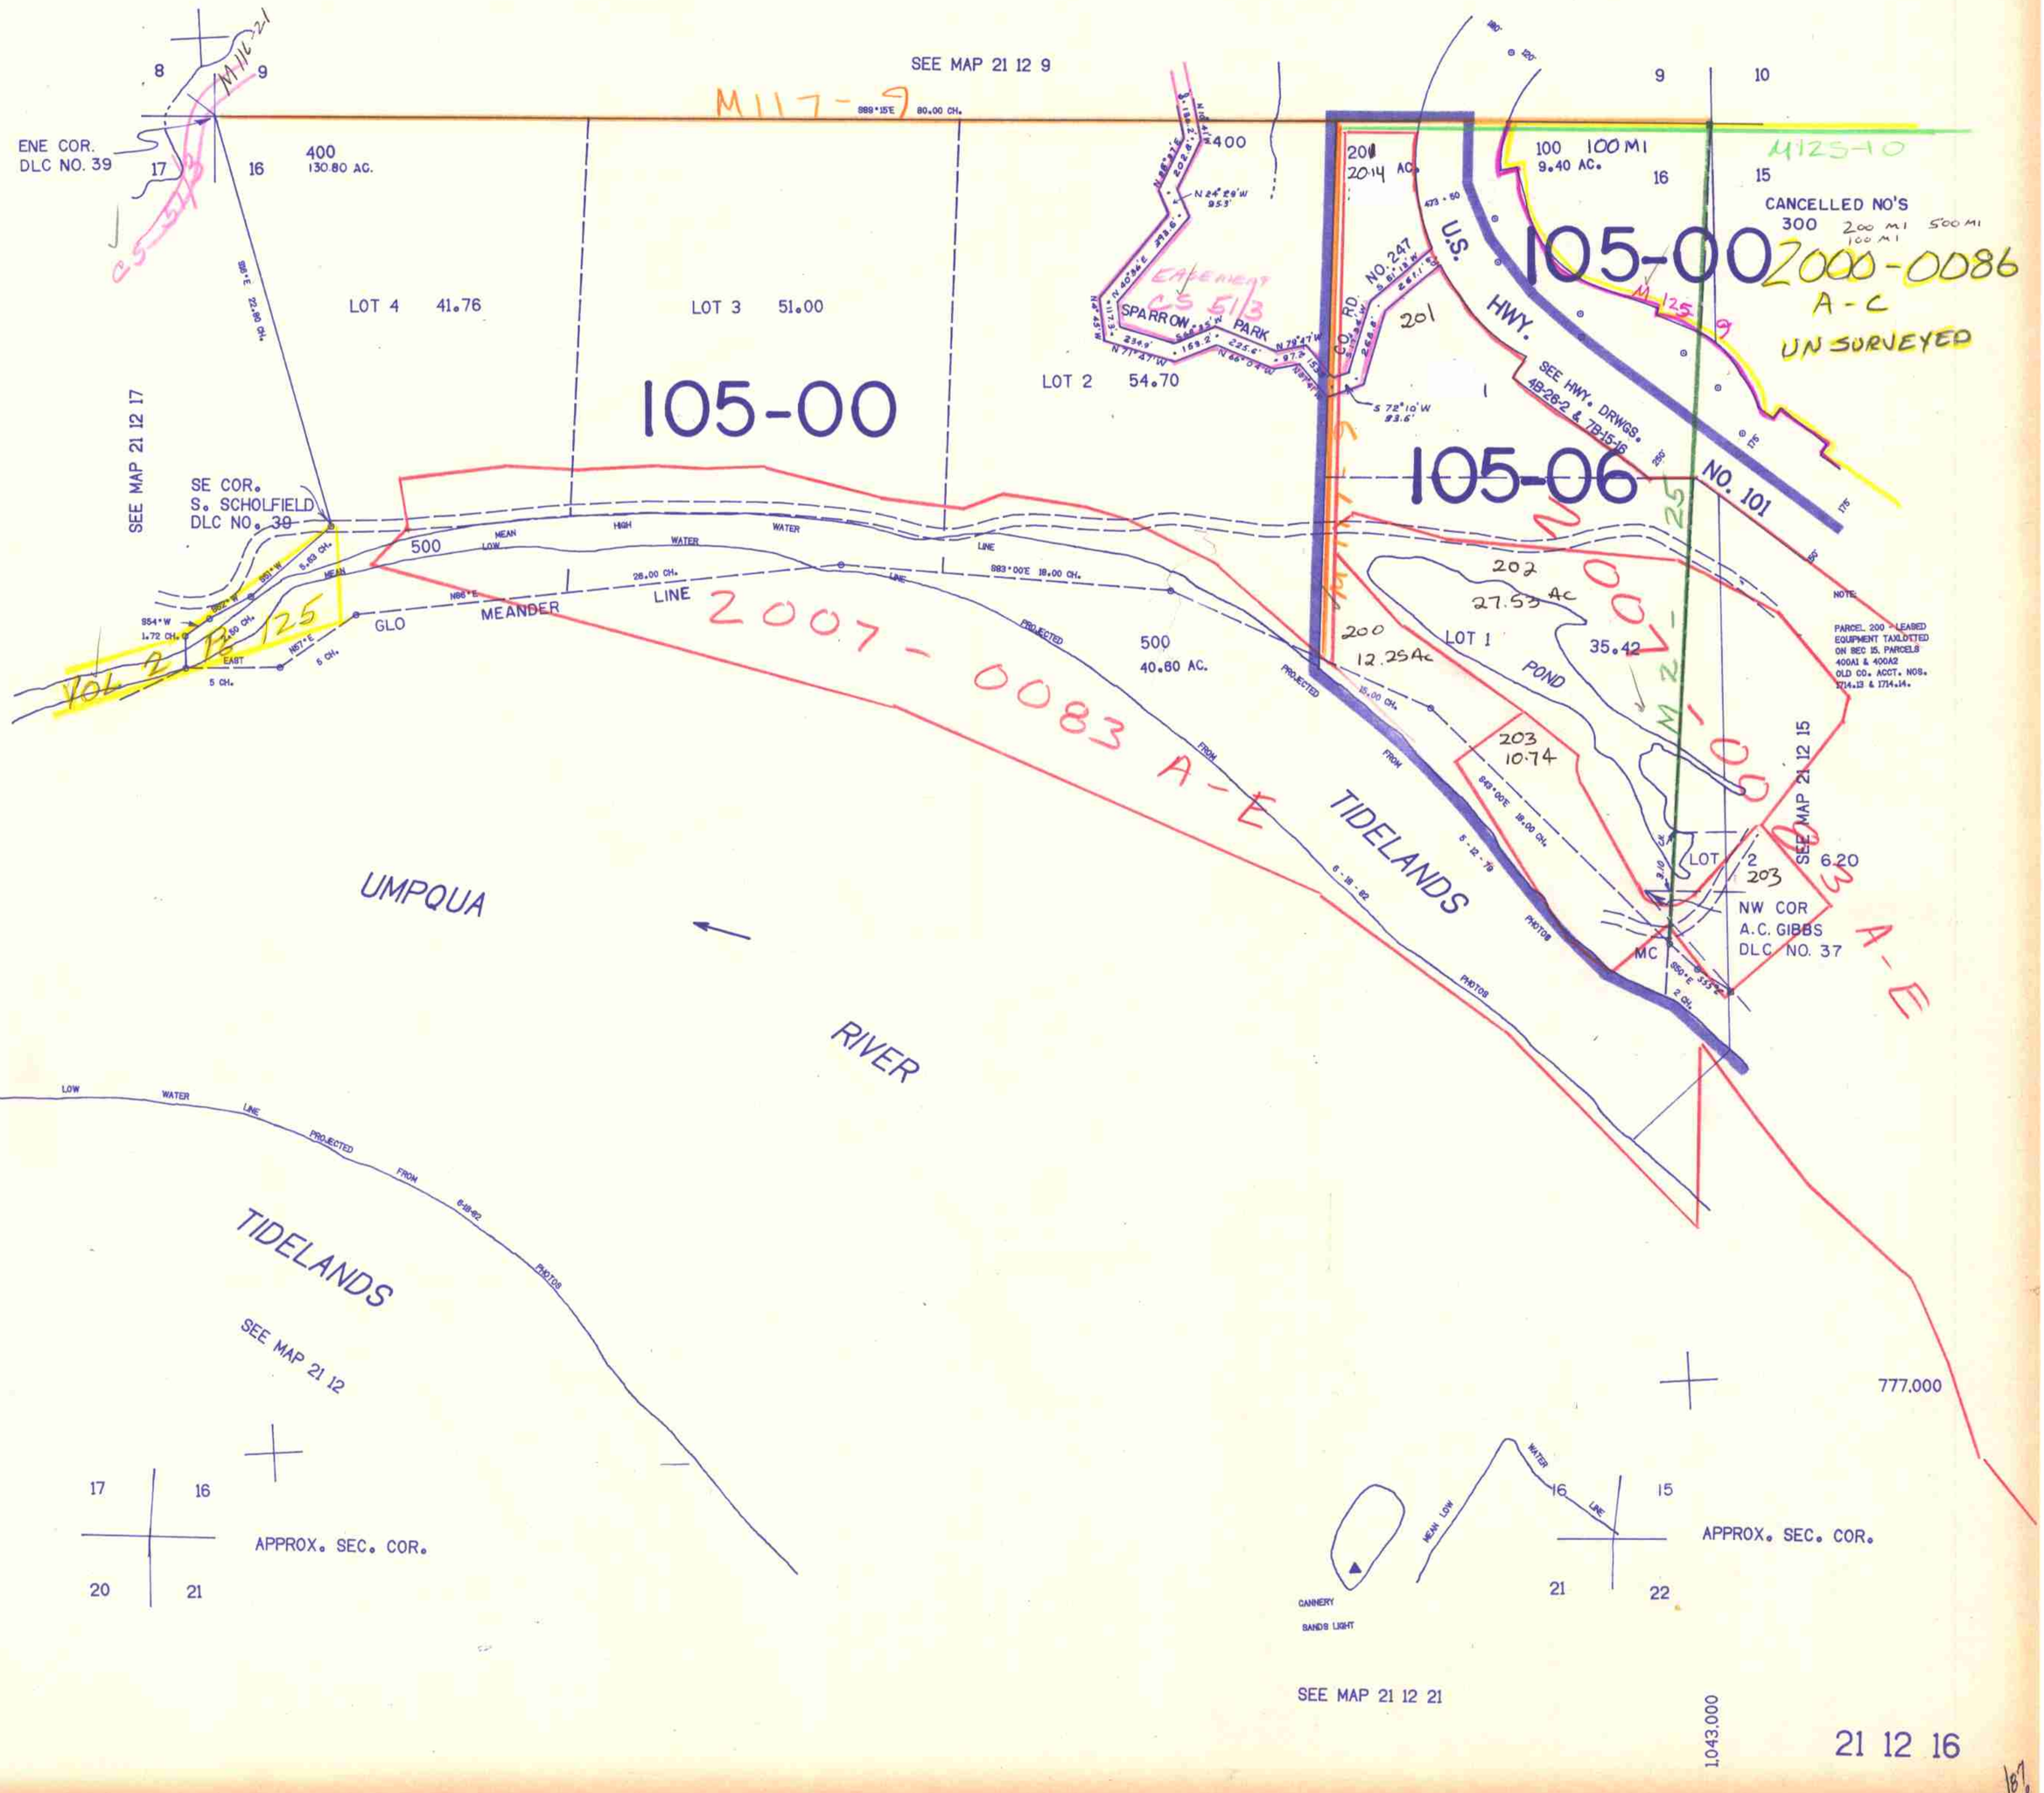

12/87