THIS MAP WAS PREPARED FOR ASSESSMENT PURPOSE ONLY.

NW1/4 SE1/4 SEC. 33 T.21S. R.12W. W.M.
DOUGLAS COUNTY

1"=100'

REVISED ON 11-16-93

21 12 33DB
REEDSPORT

APPROX CEN. SEC.

APPROX 1/16 COR.

CANCELLED NO.S
2701
2701MI
2600 MI
2700 MI
2800 MI
2900 MI
3000 MI
3100 MI
3200 MI
3201 MI
2699 MI
2799 MI
2799
200

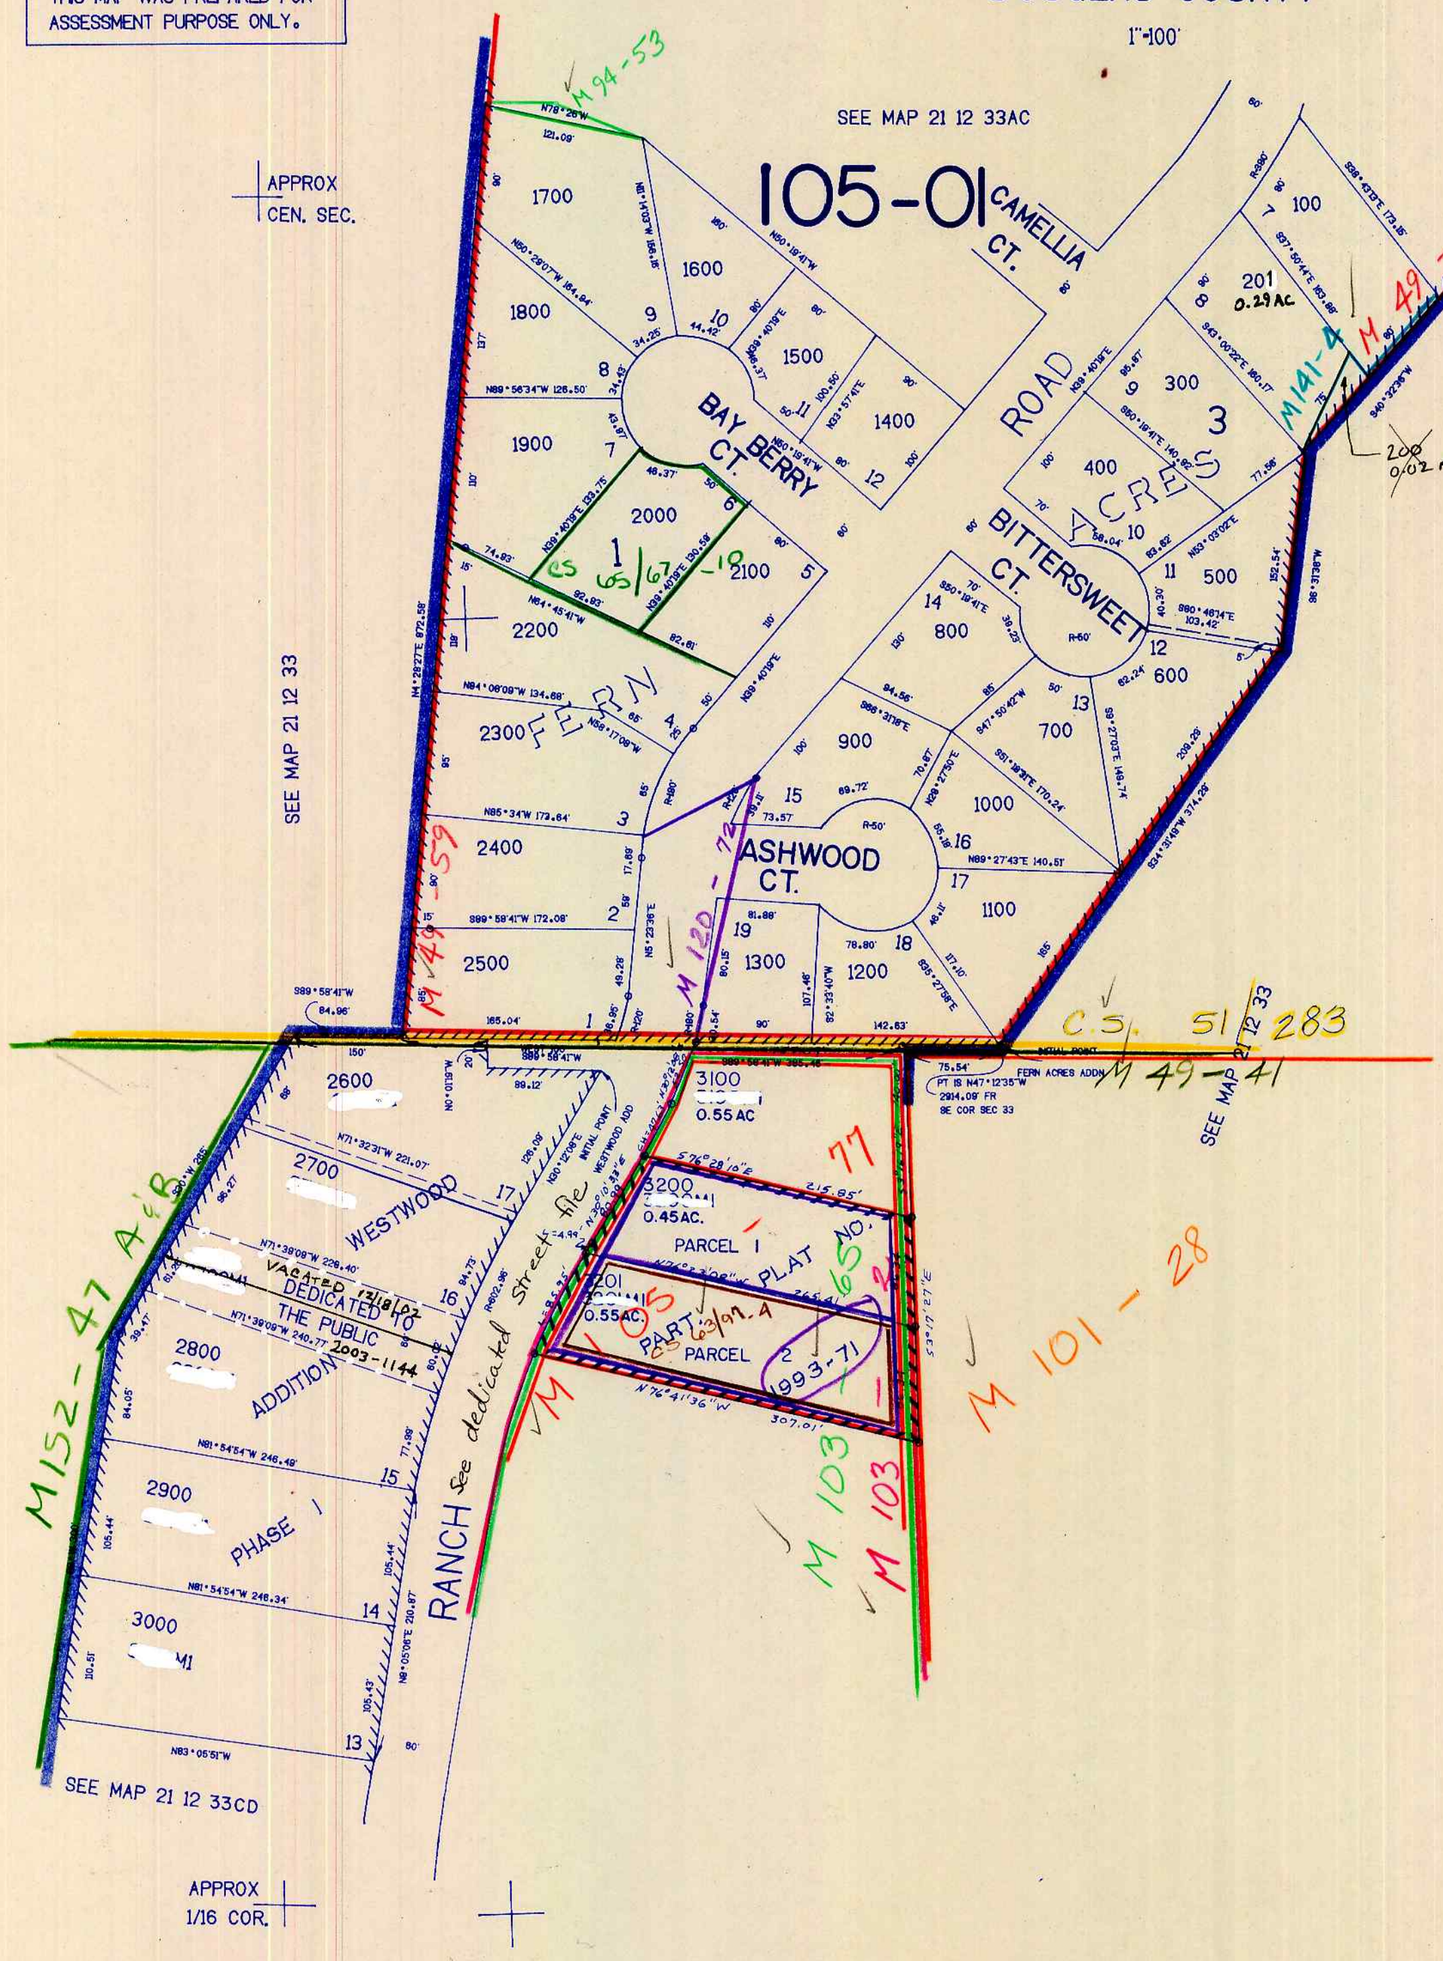

APPROX 1/16 COR.

762.250

APPROX 1/16 COR.

21 12 33DB
REEDSPORT

40.750

JP 12/1/93