SECTION 5 T.22 S. R. 4 W. W.M.
DOUGLAS COUNTY

1" = 400'

SEE MAP 21 4 32

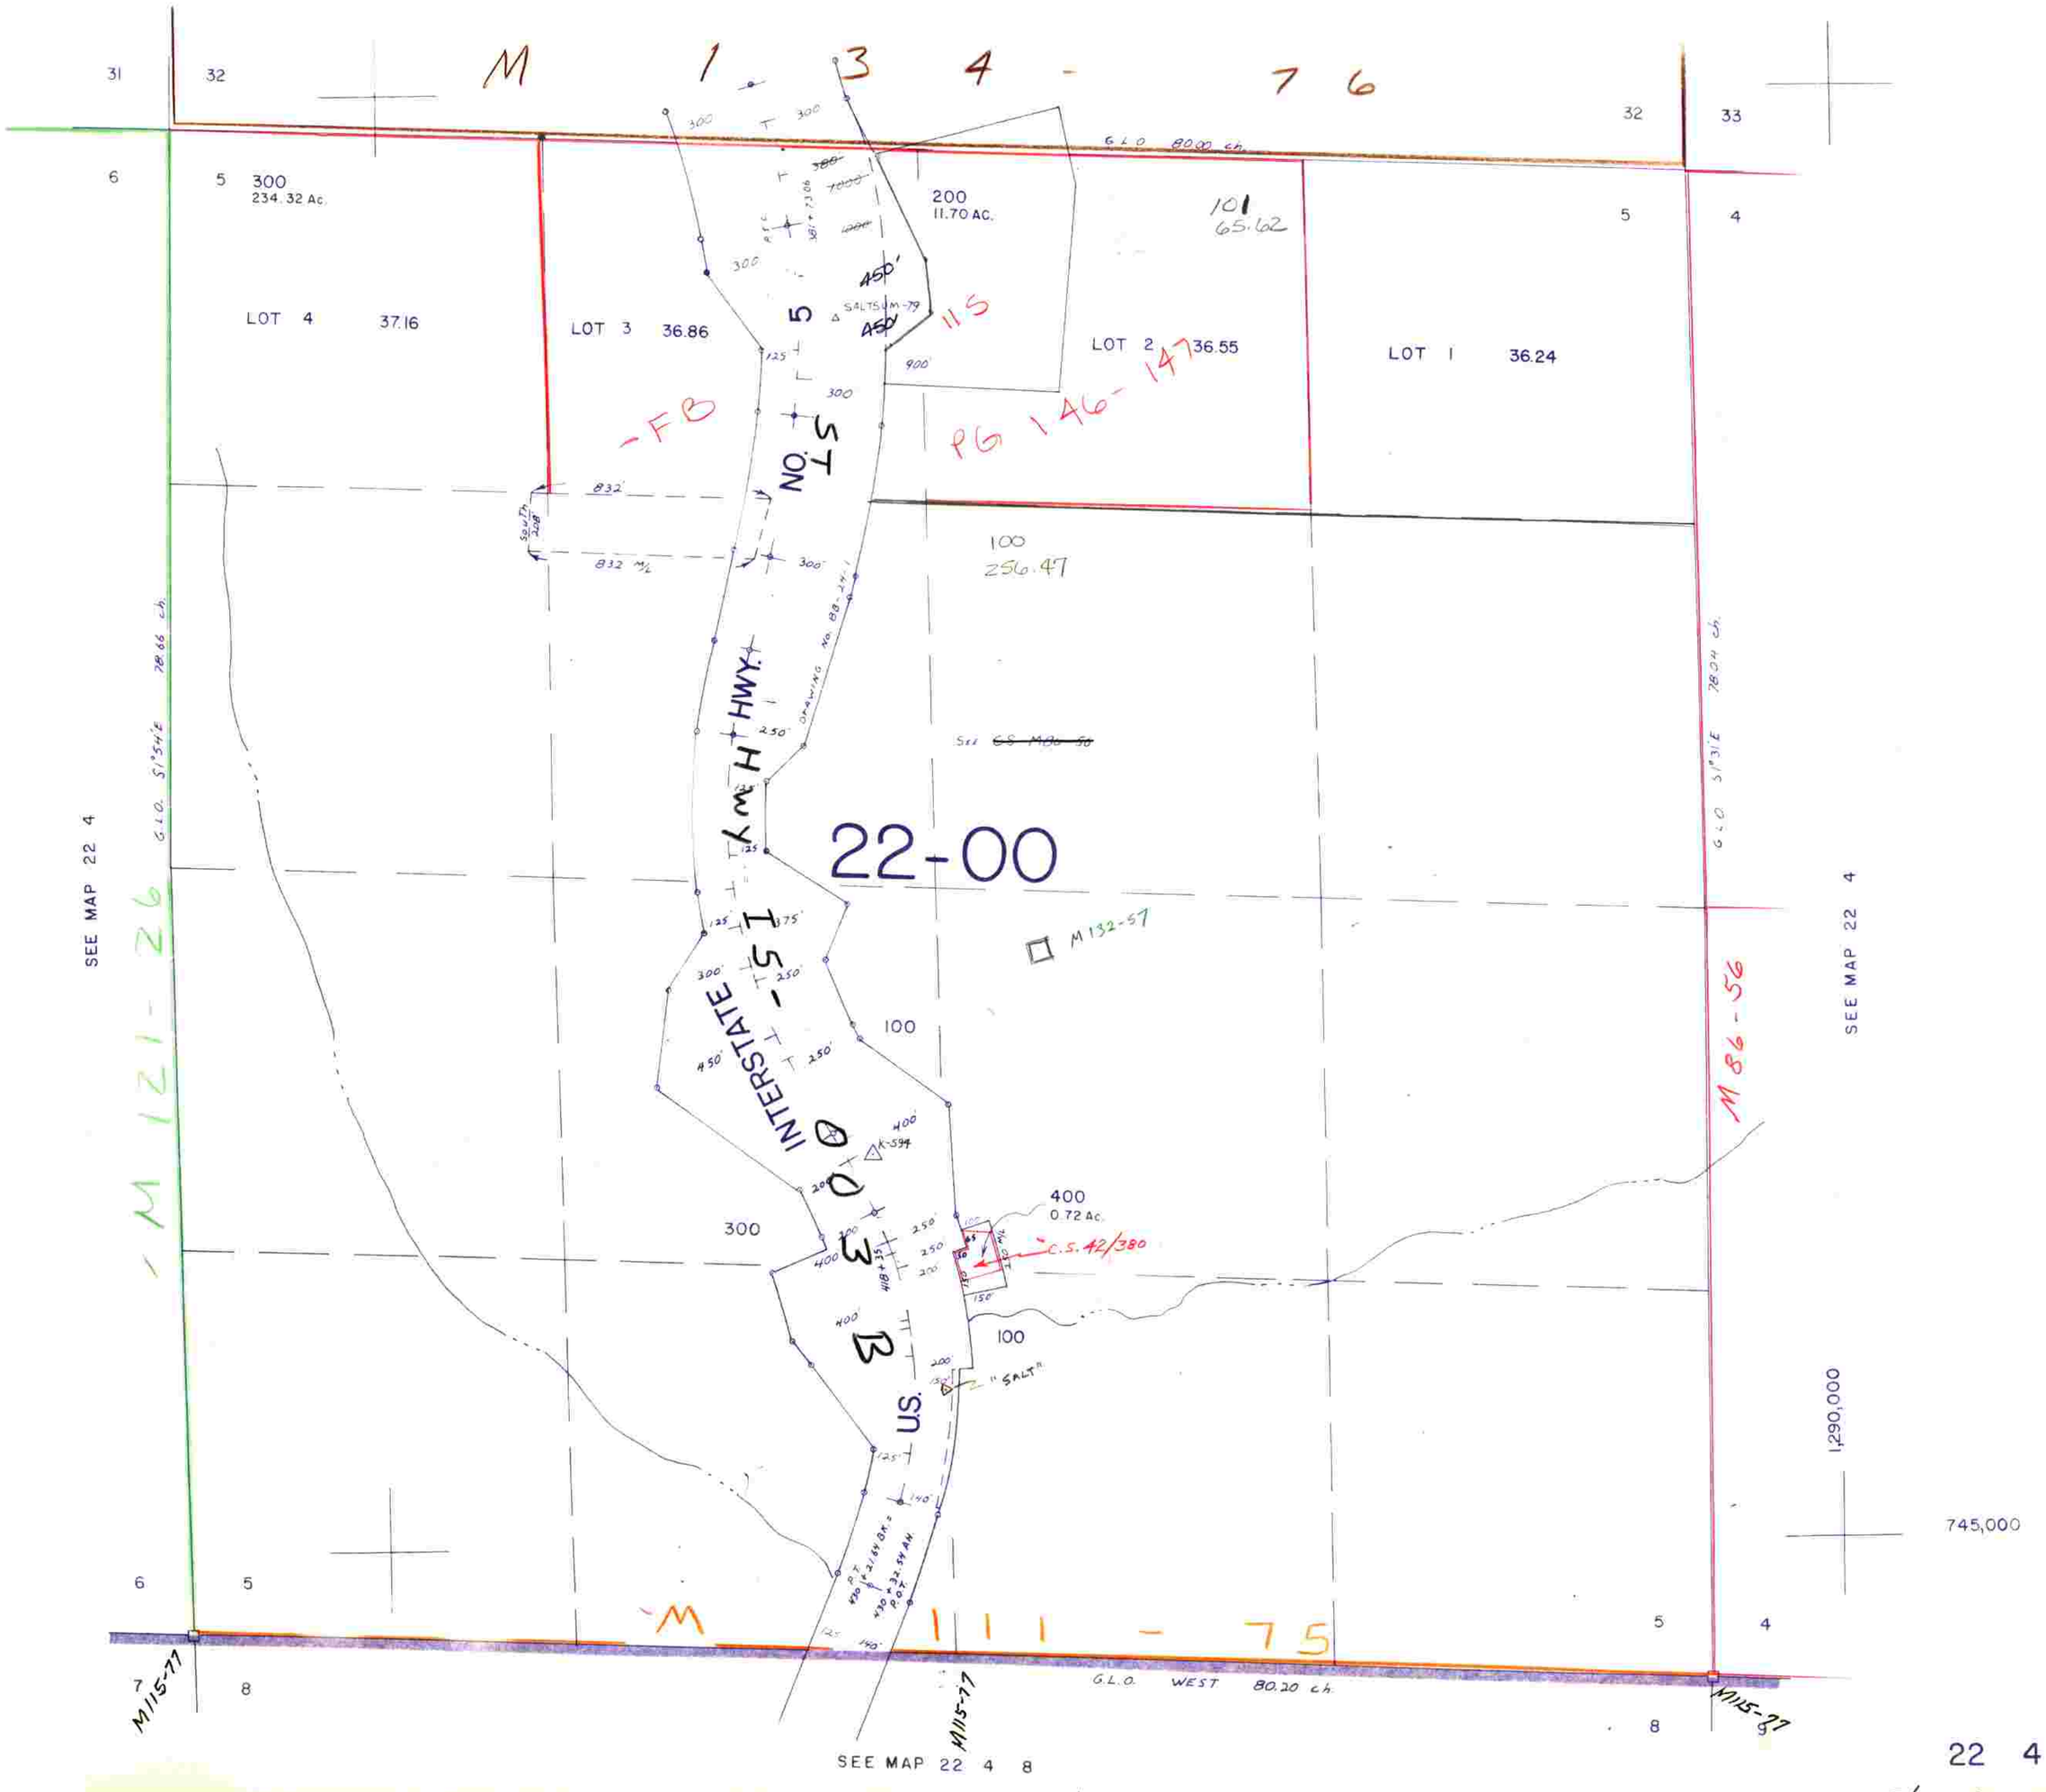

7/83 BB