


SECTION 7 T.22 S. R. 4 W. W.M.
DOUGLAS COUNTY

22 4 7

1" = 400'

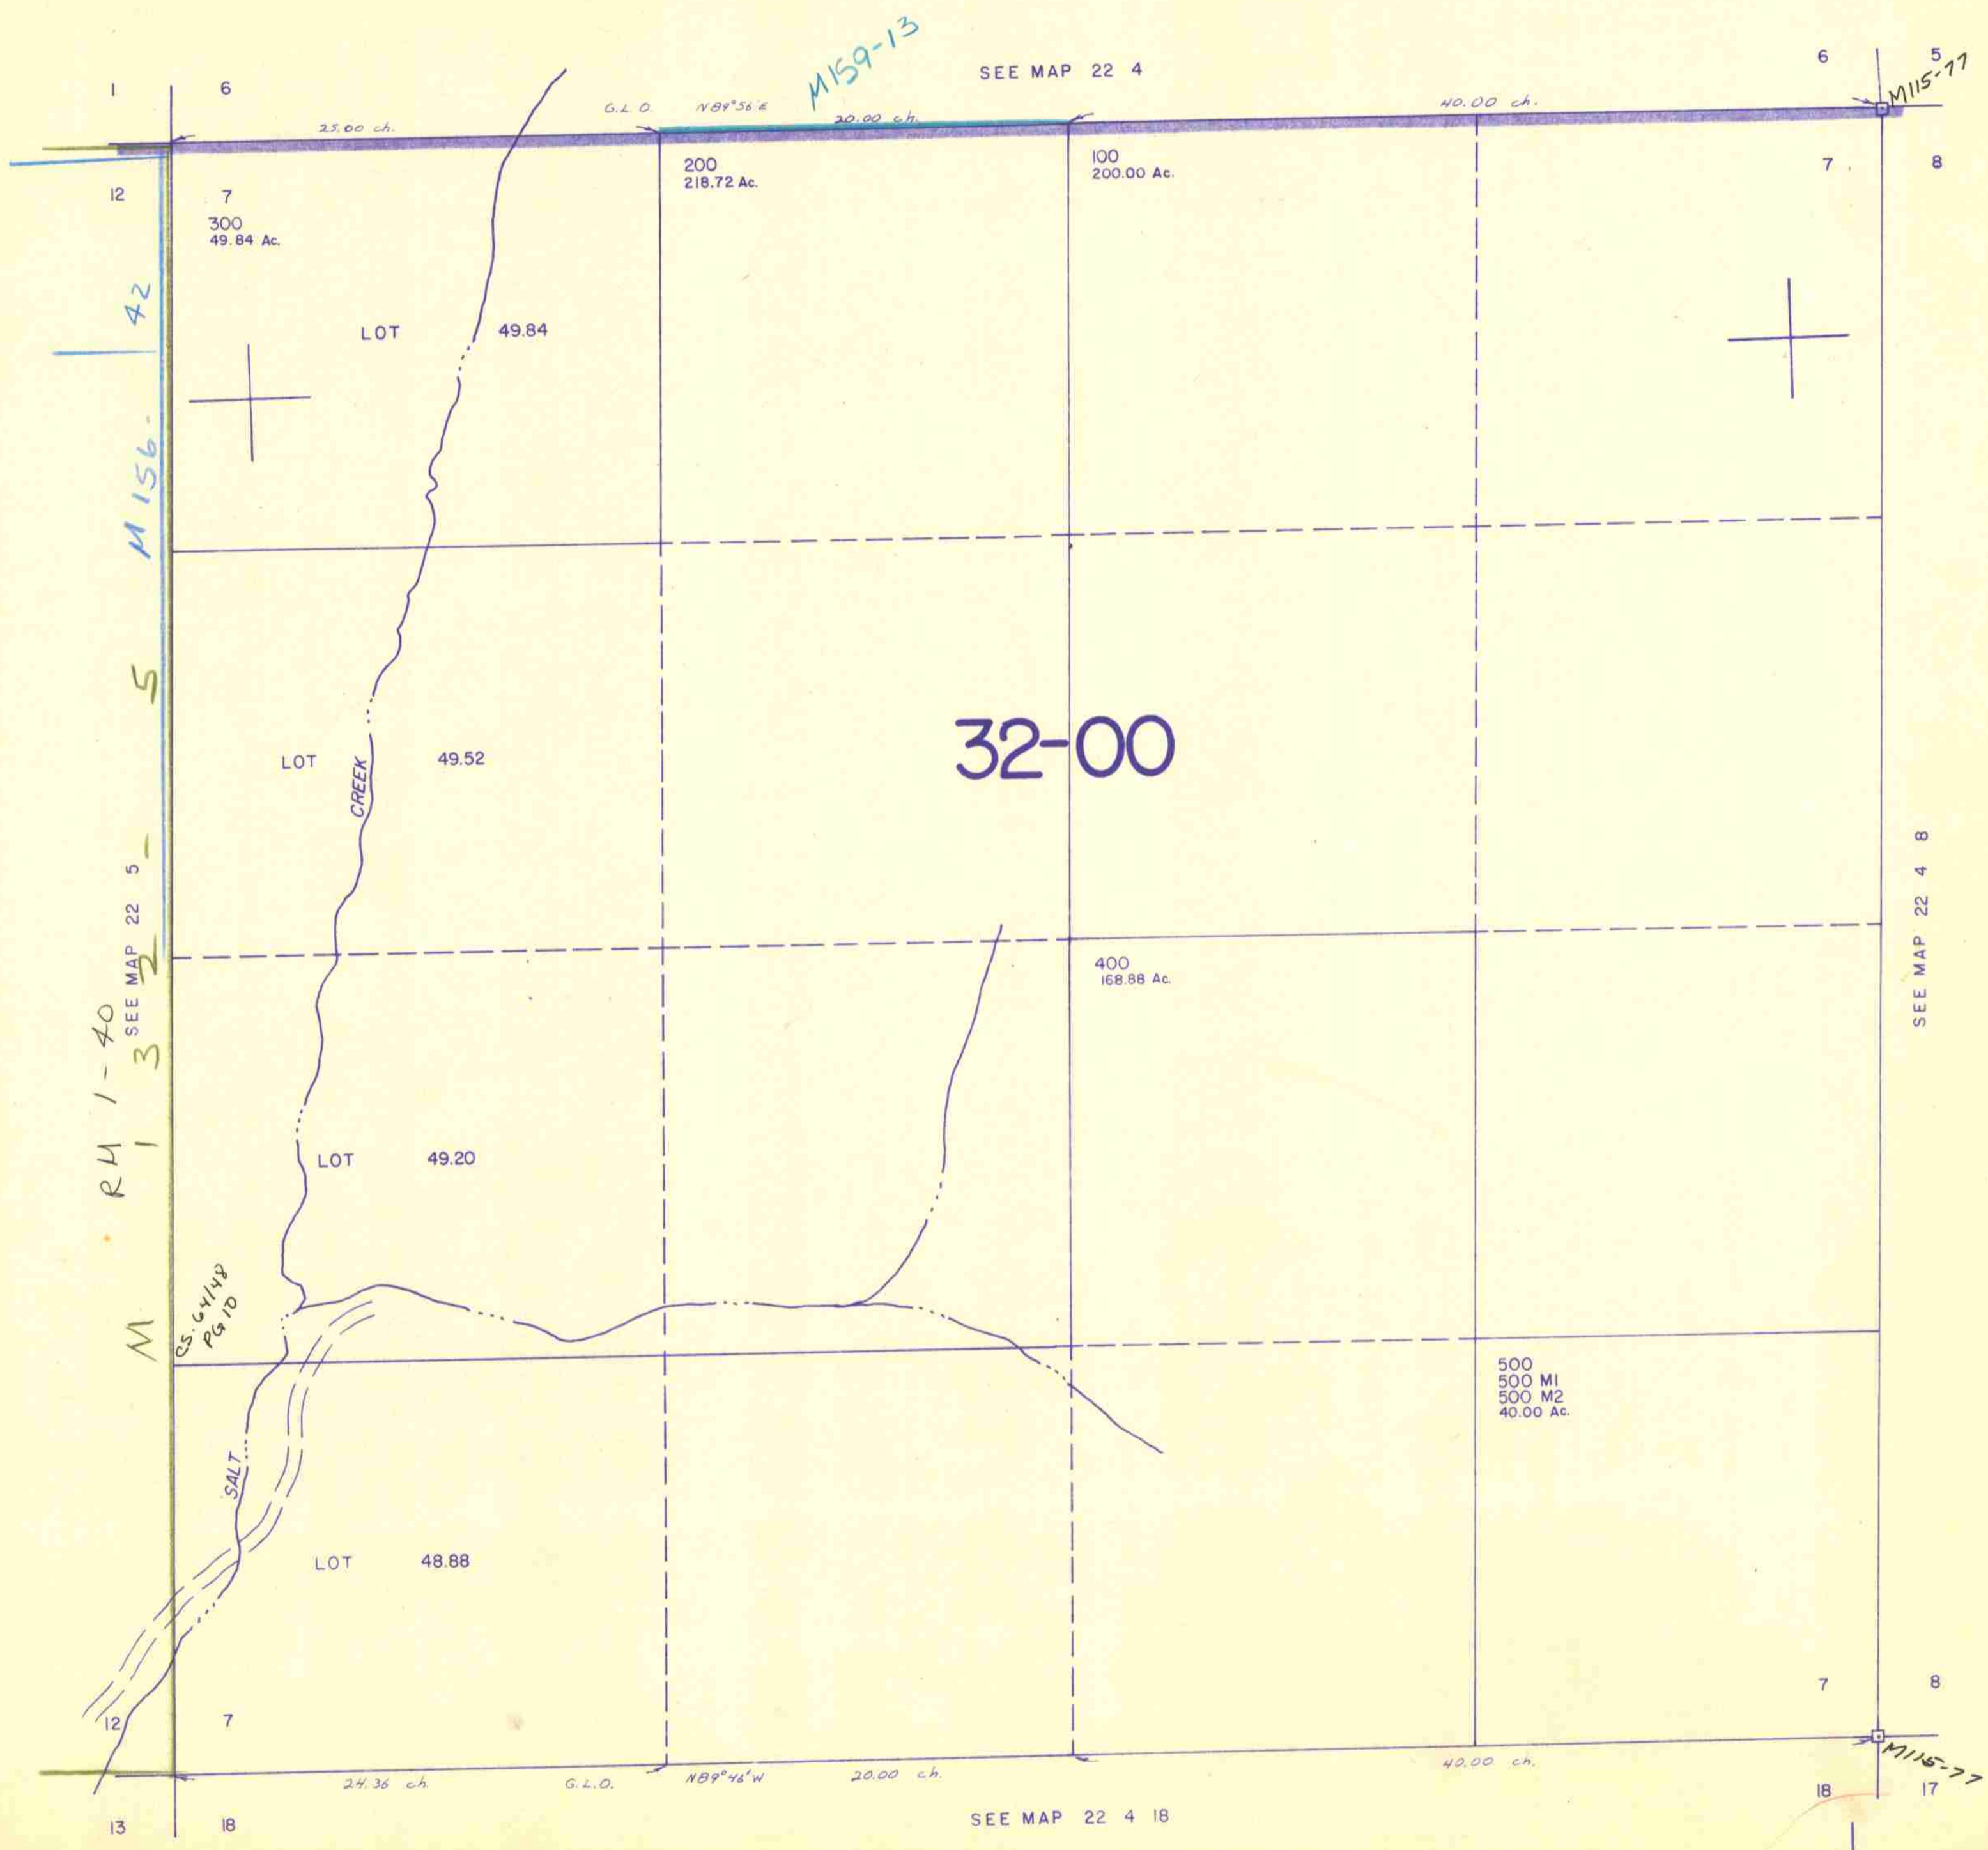

284,000
1/83 BS
7390
22 4 7