SECTION 8 T.22 S. R. 4 W. W.M.
DOUGLAS COUNTY
1" = 400'

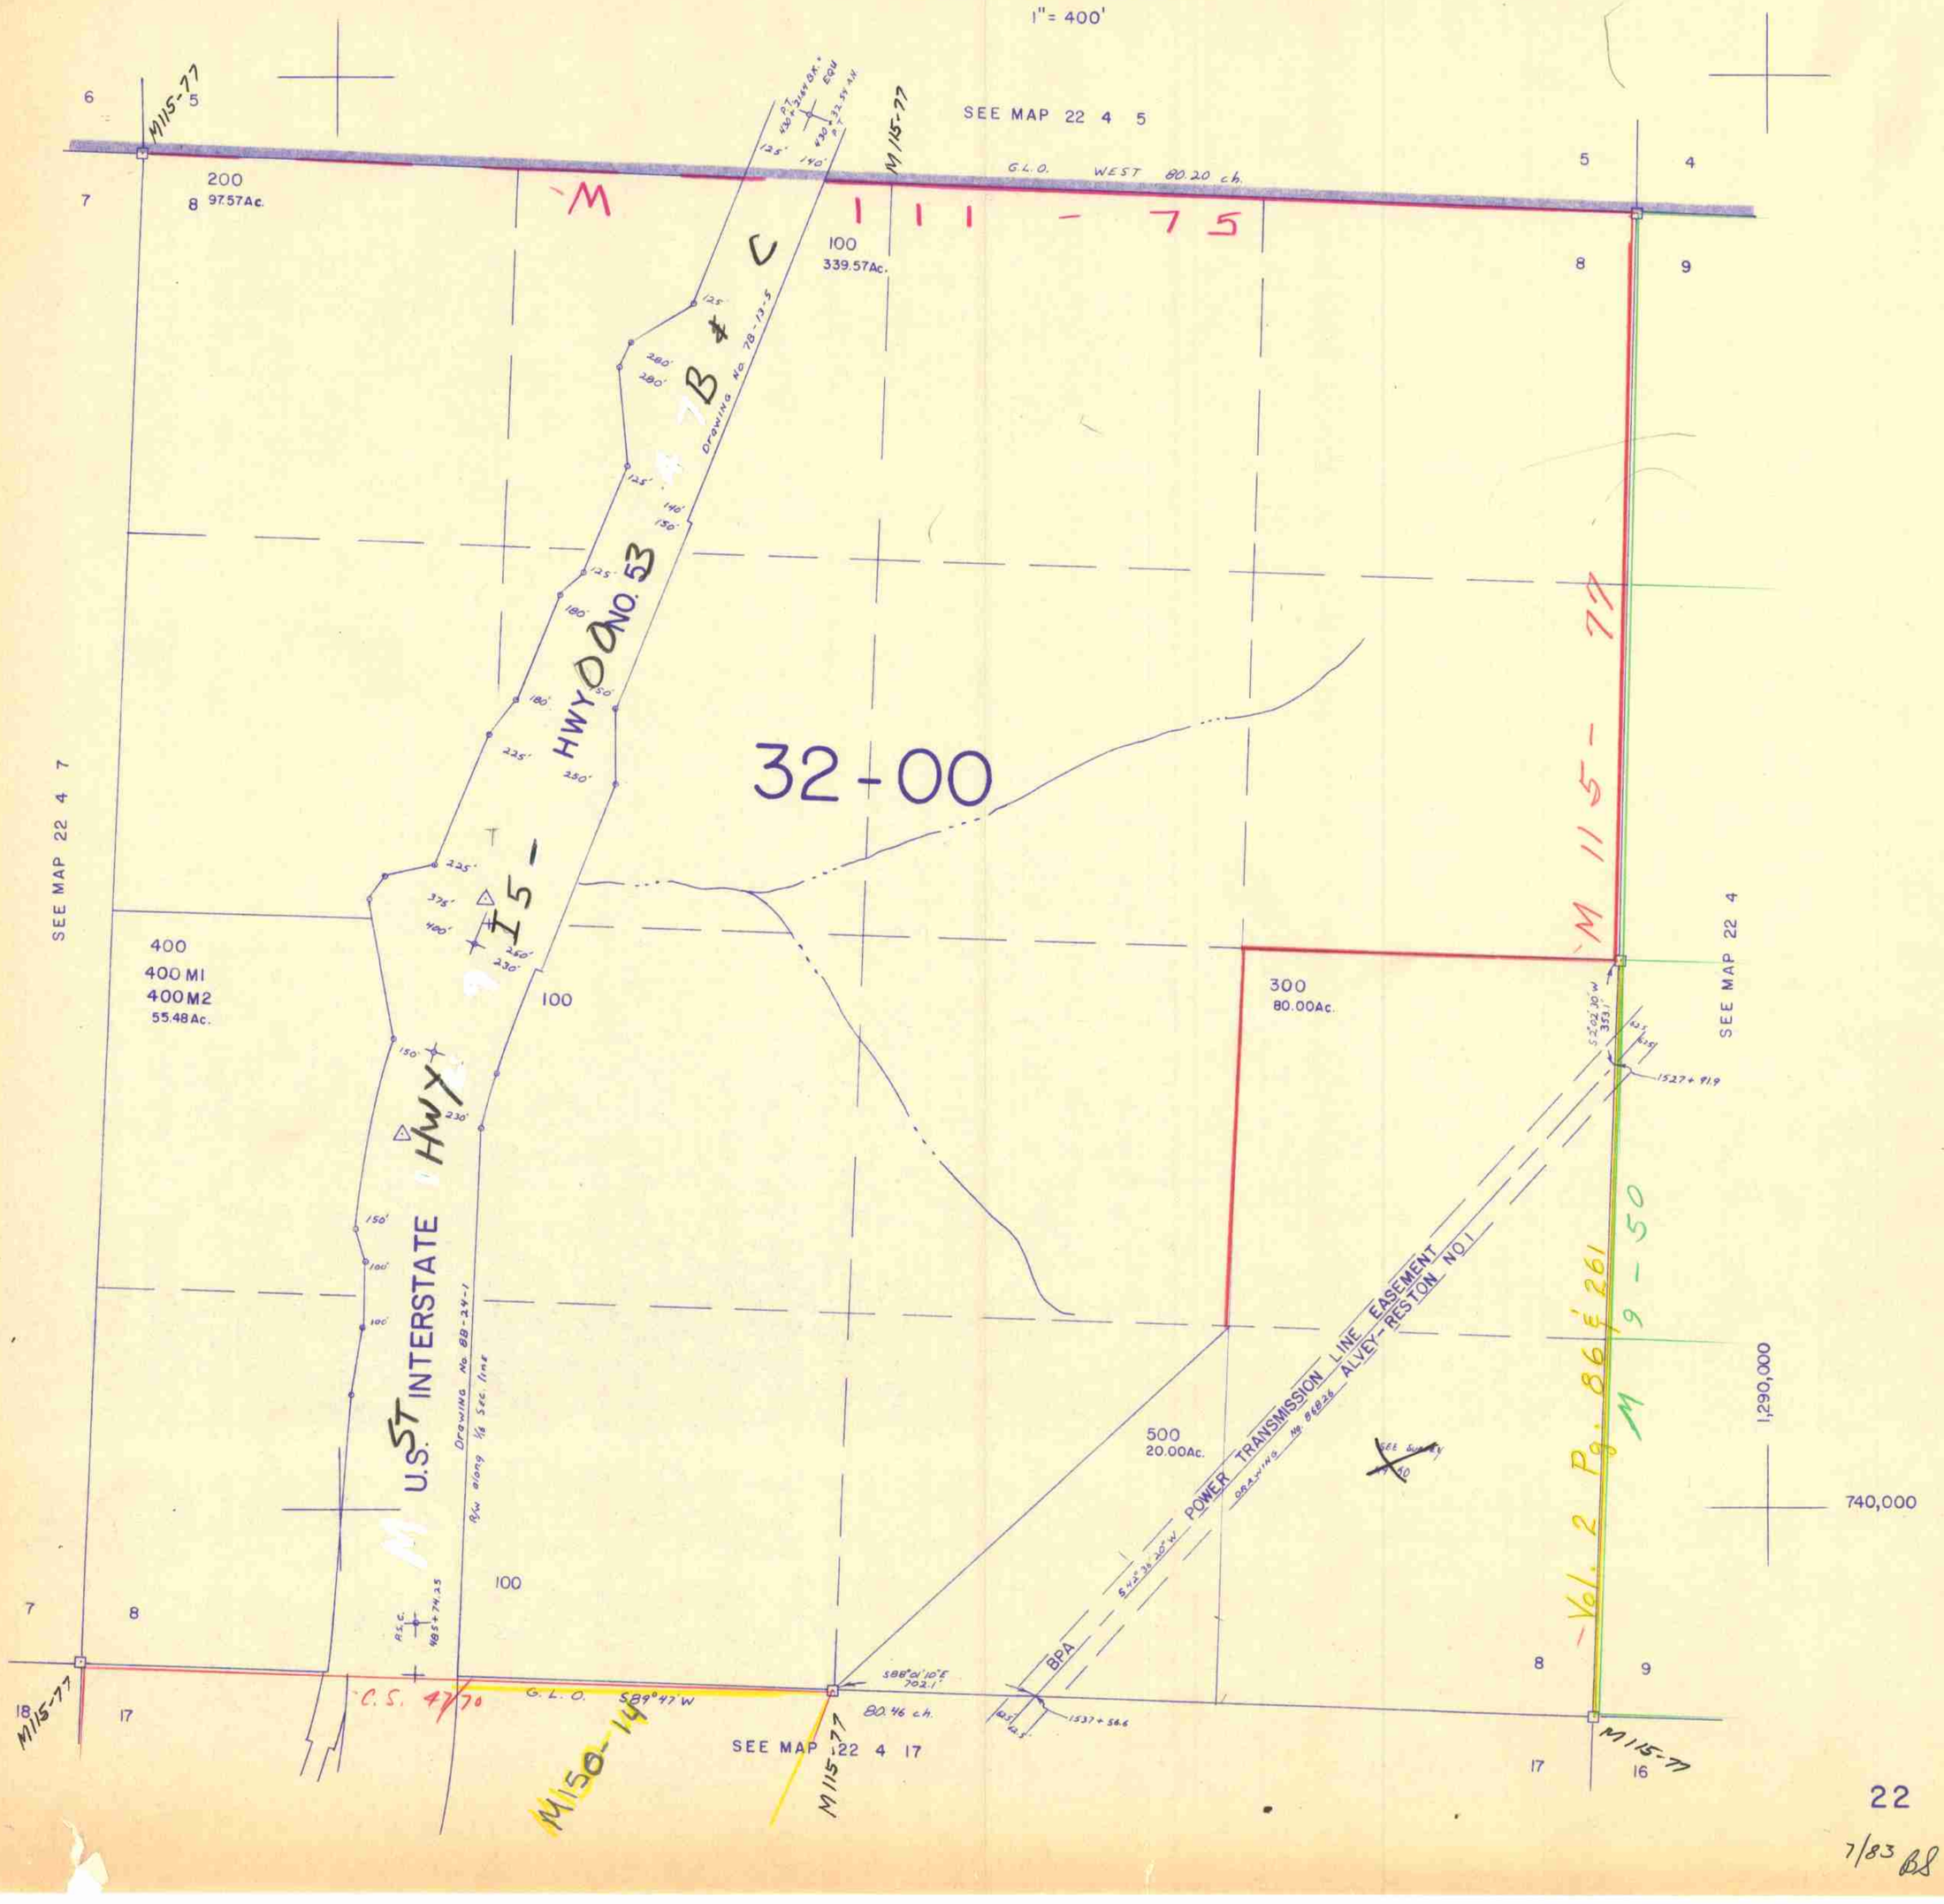

7/83 BS