

THIS MAP WAS PREPARED FOR ASSESSMENT PURPOSE ONLY


SEC. T.22S. R.5 W W.M. DOUGLAS COUNTY

REVISED ON 11-26-02

22 5 00 & INDEX DRAIN

FB 113 Pg 120 CS 58/300-2 CS 44/48-16 Vol 3 Pg 176

SEE MAP 21 5 00 1"=2000'

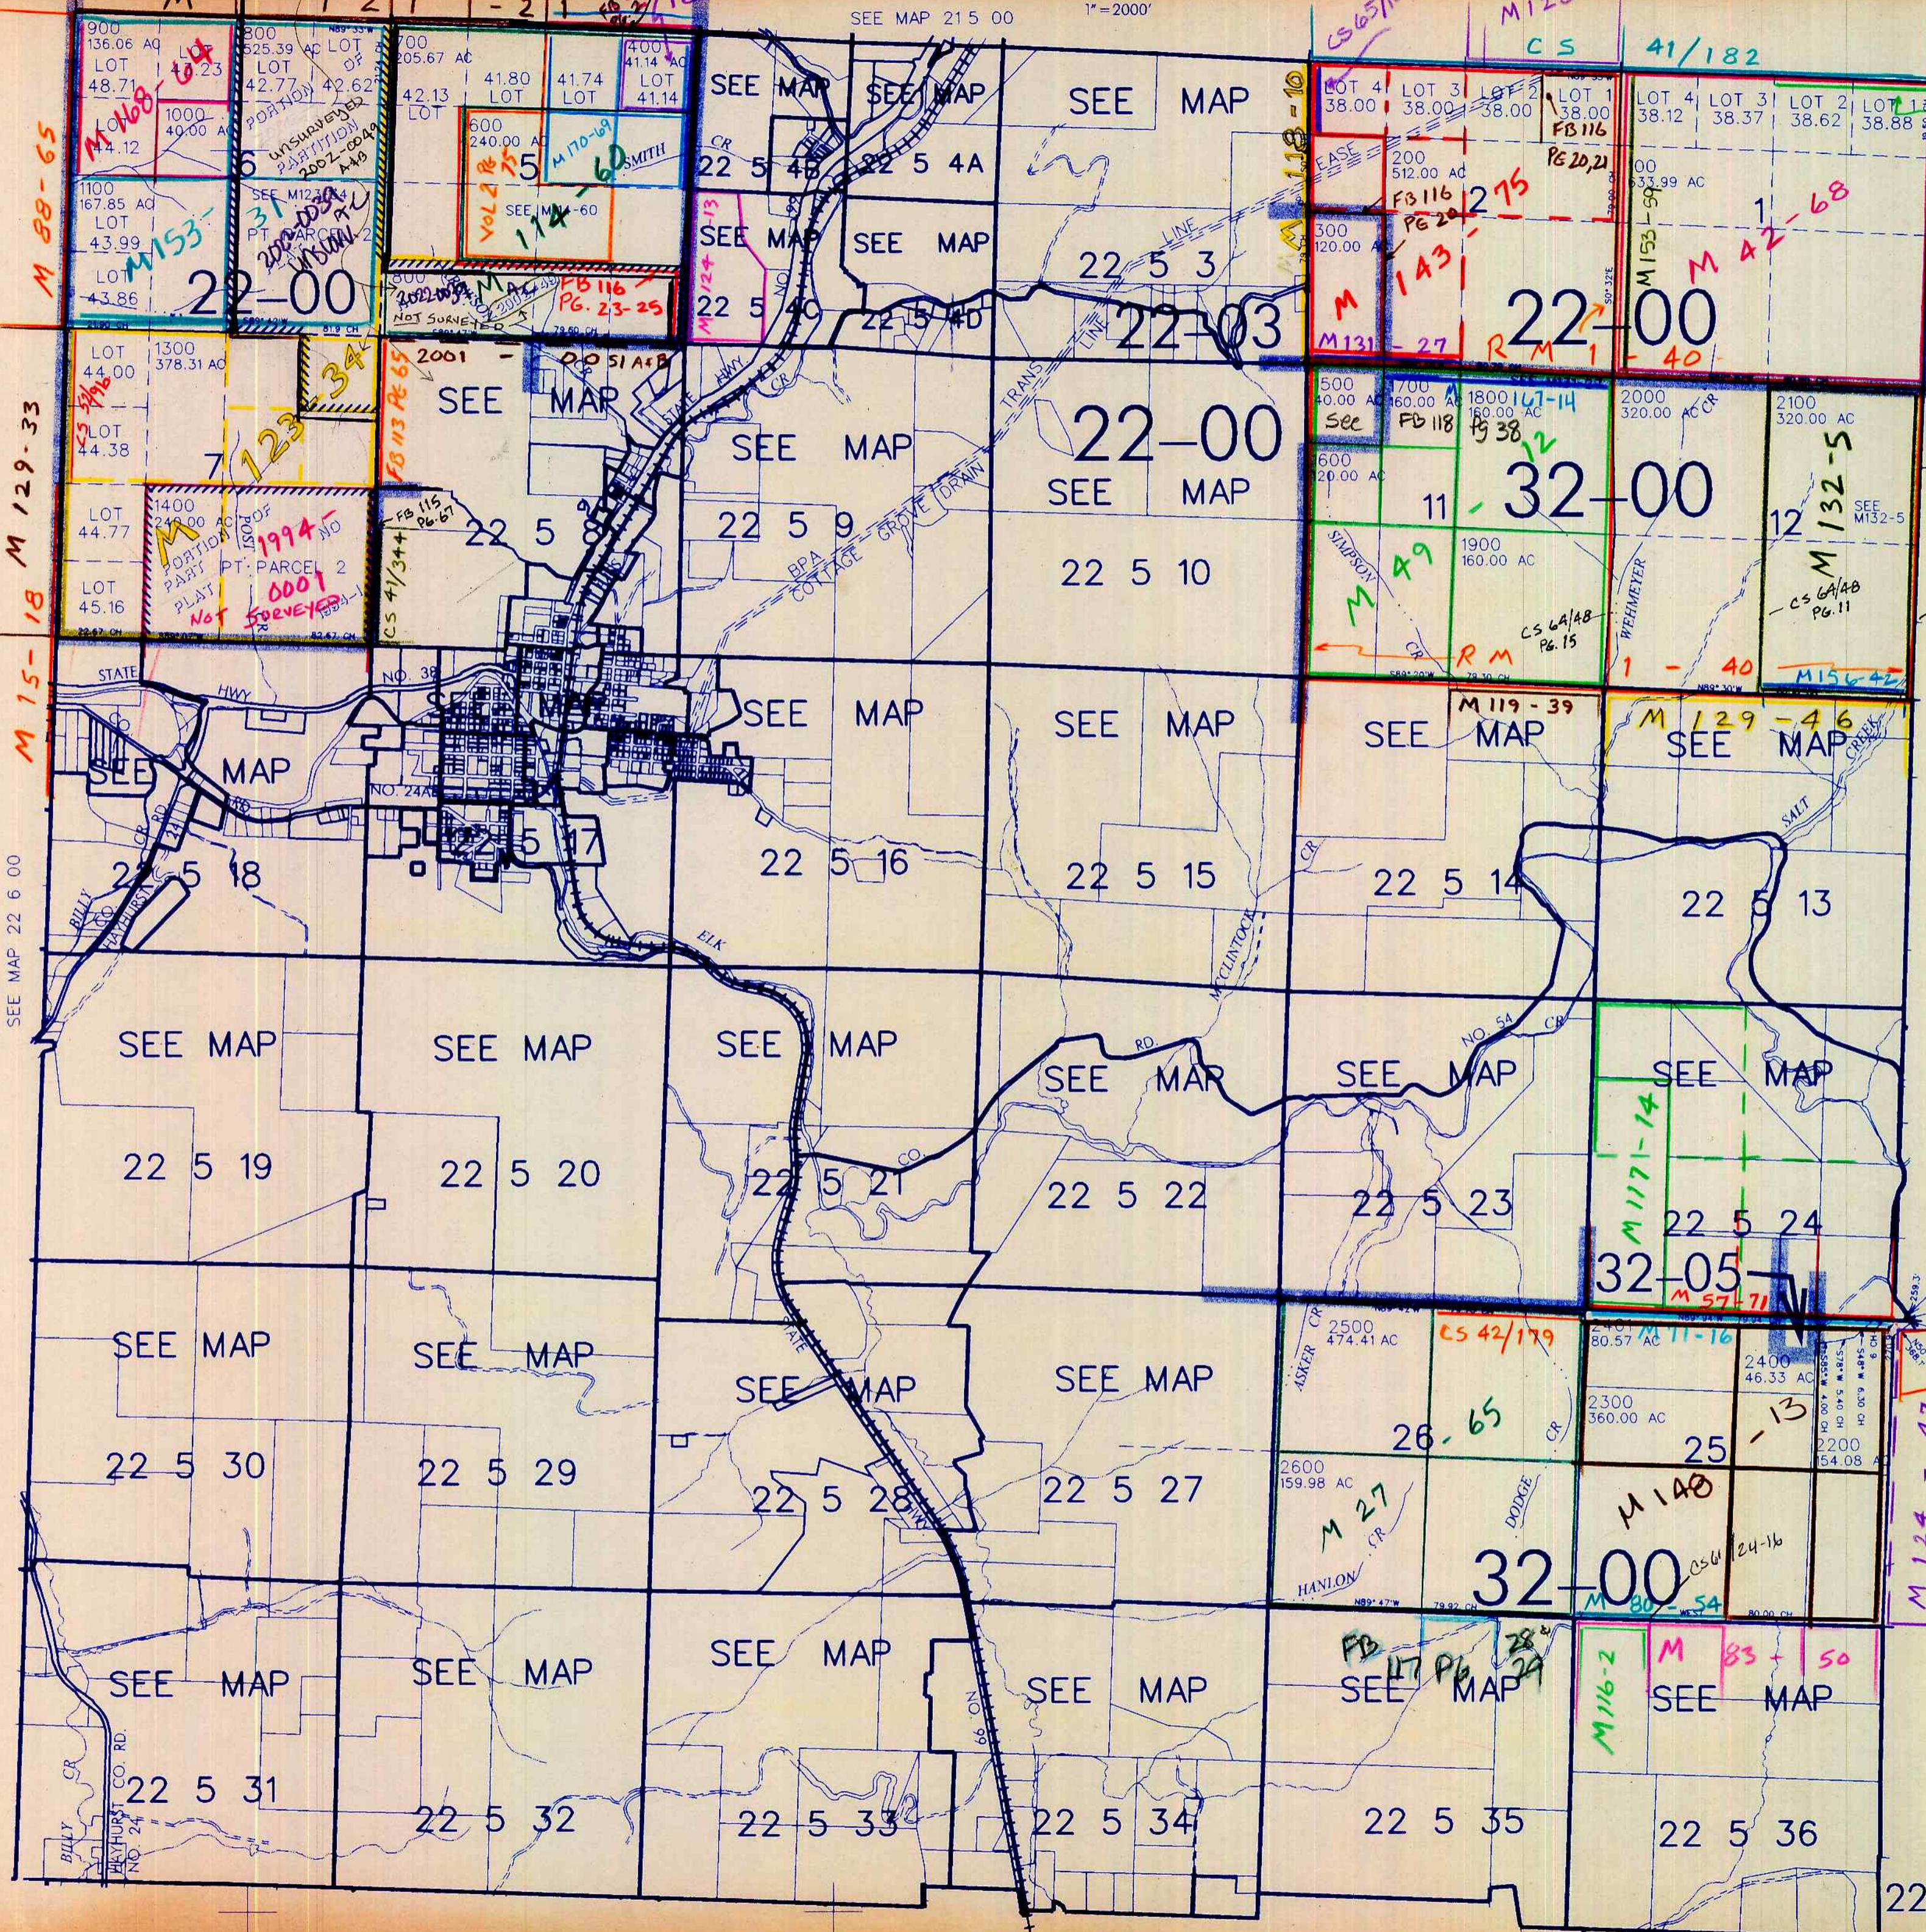

M 129-33 M 15-18 M 88-65

SEE MAP 22 6 00

BILLY CR

SEE MAP 22 6 00

CANCELLED NO'S 1901 500 1200

M 159-12

4

CS 64/48 PG.10

SEE MAP 22 04 00

BOSWELL CO. RD. NO. 54

M 146-44

M 124-47

4,201,000

719,000 & INDEX DRAIN

SEE MAP 23 5 00

12/02 JP