THIS MAP WAS PREPARED FOR ASSESSMENT PURPOSE ONLY.

SE1/4 SEC.4 T.22S. R.5W. W.M.
DOUGLAS COUNTY

1" =200'

REVISED ON
2-24-10

22 5 4D

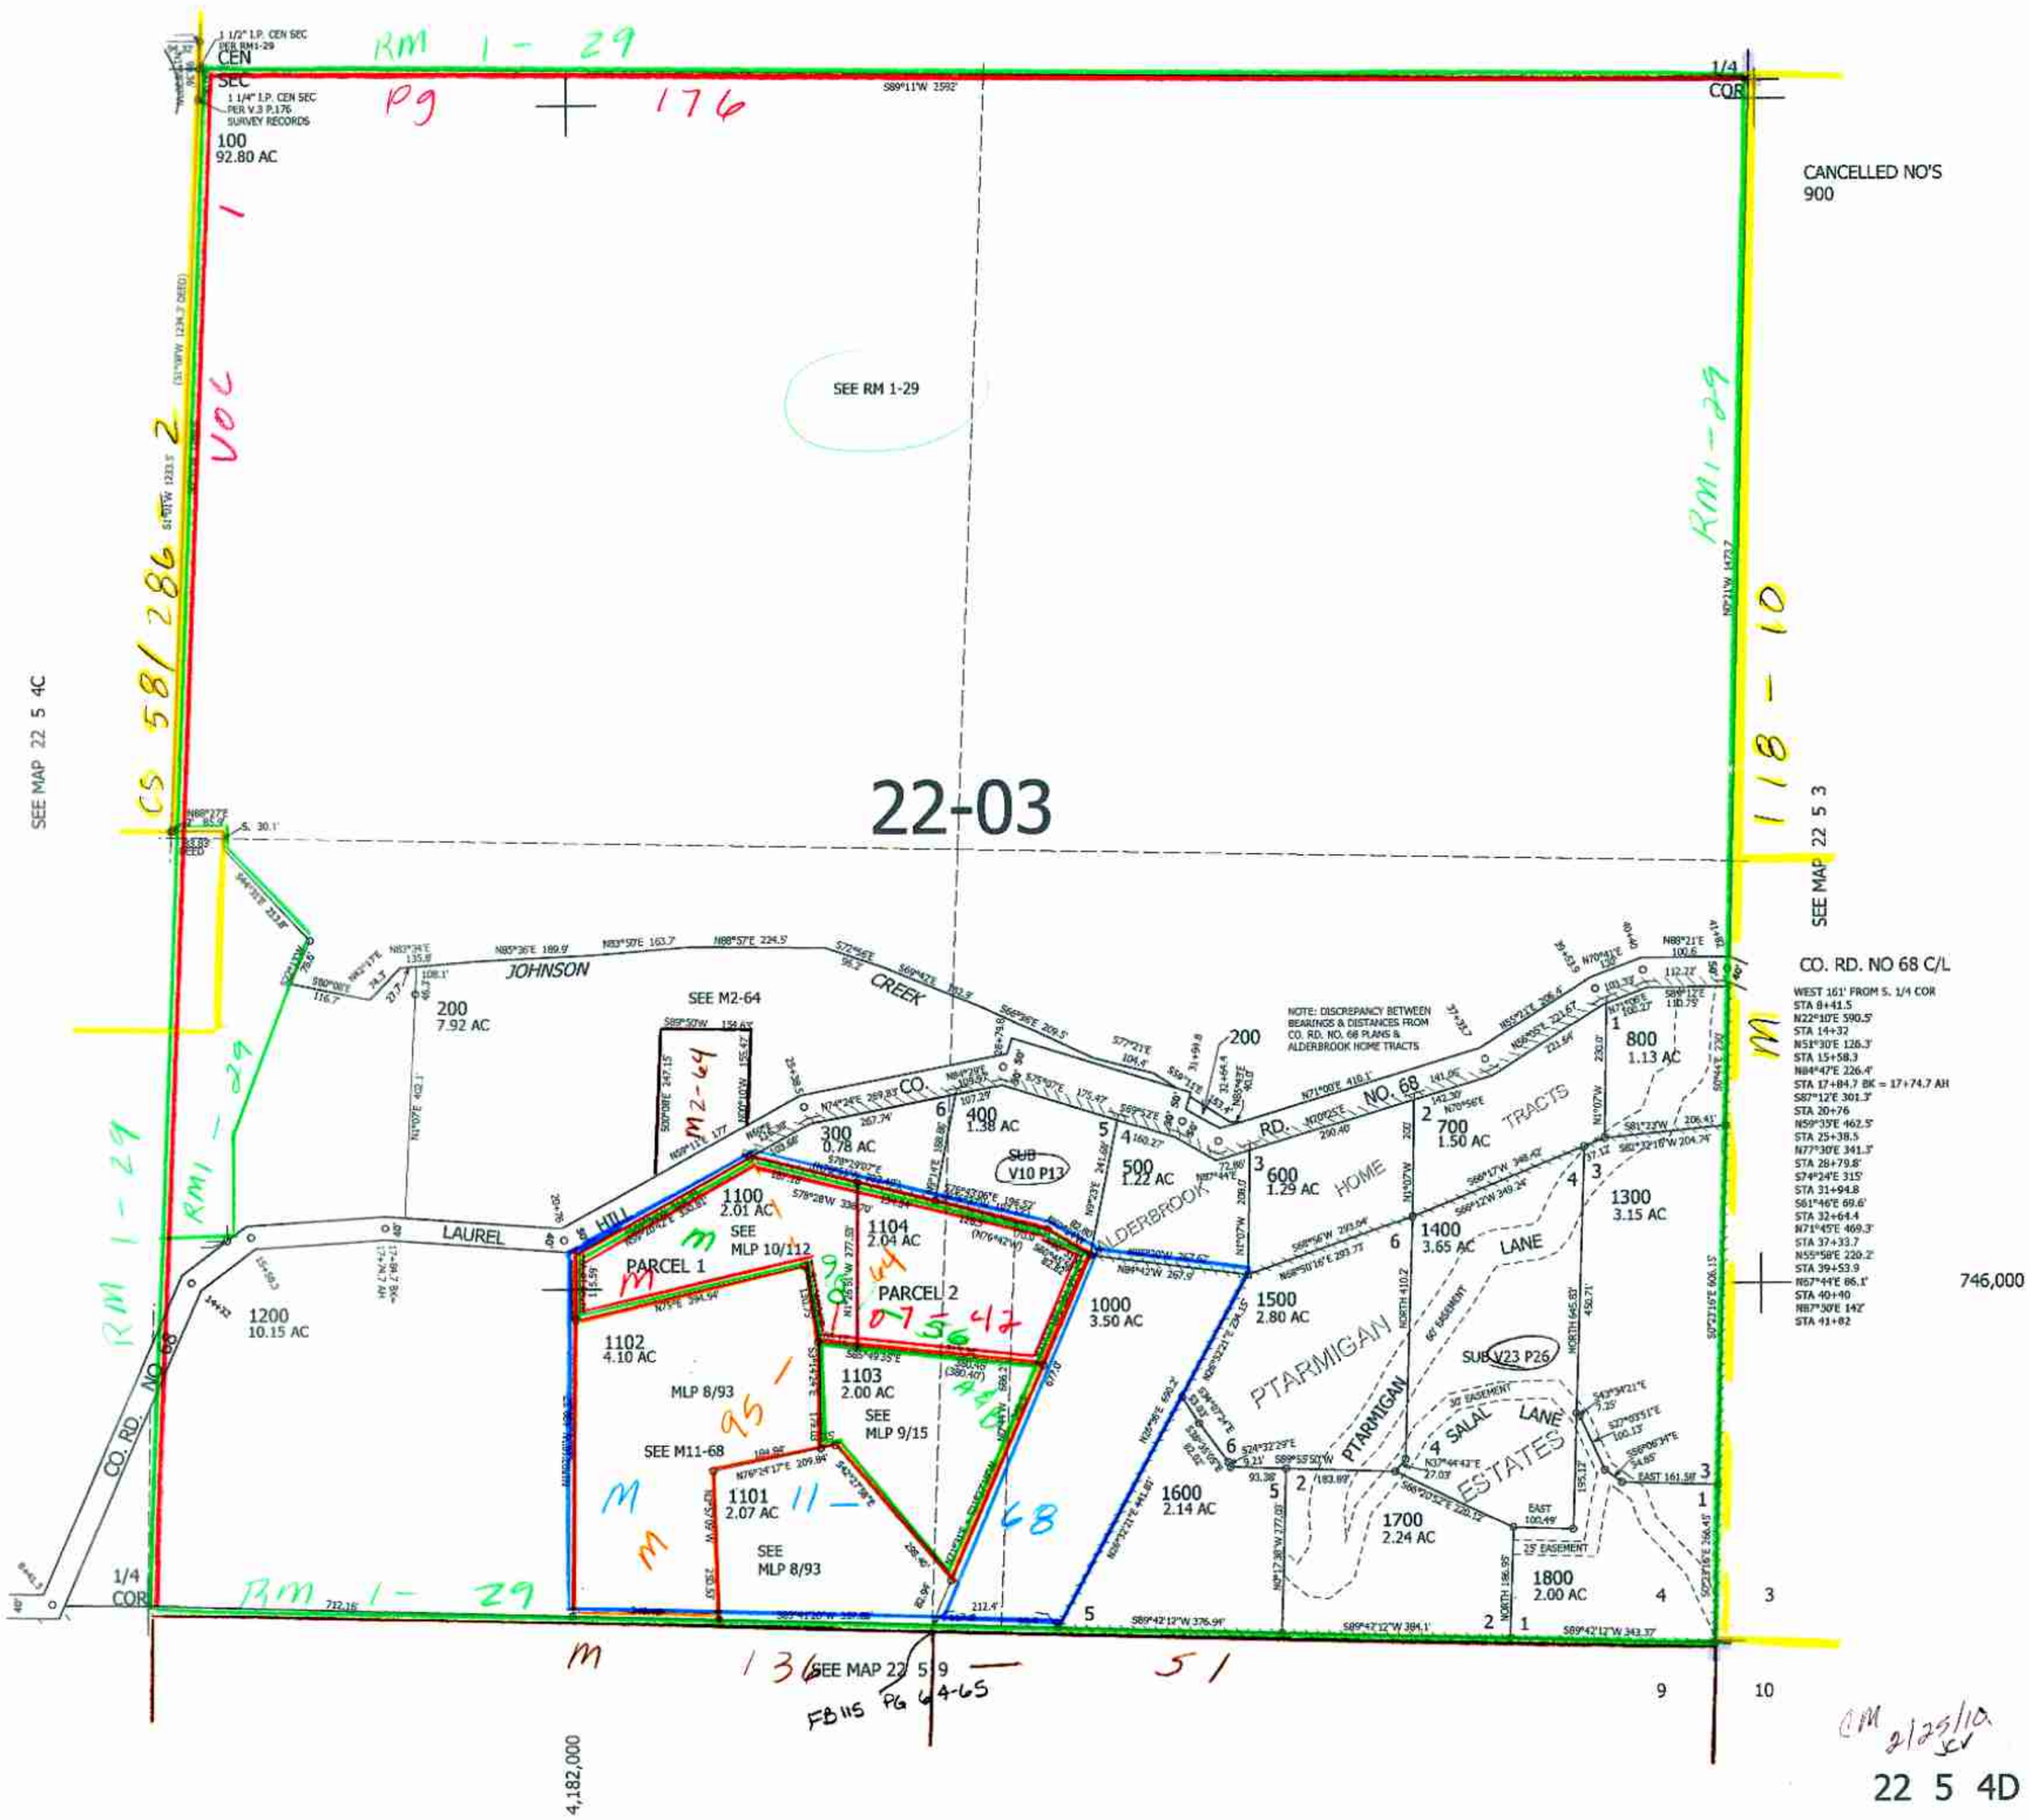

CM 2/25/10 SCV

22 5 4D