THIS MAP WAS PREPARED FOR ASSESSMENT PURPOSE ONLY.

NW1/4 SE1/4 SEC.8 T.22S. R.5W. W.M.
DOUGLAS COUNTY
1" =100'

REVISED ON
3-14-12

22 5 8DB
DRAIN

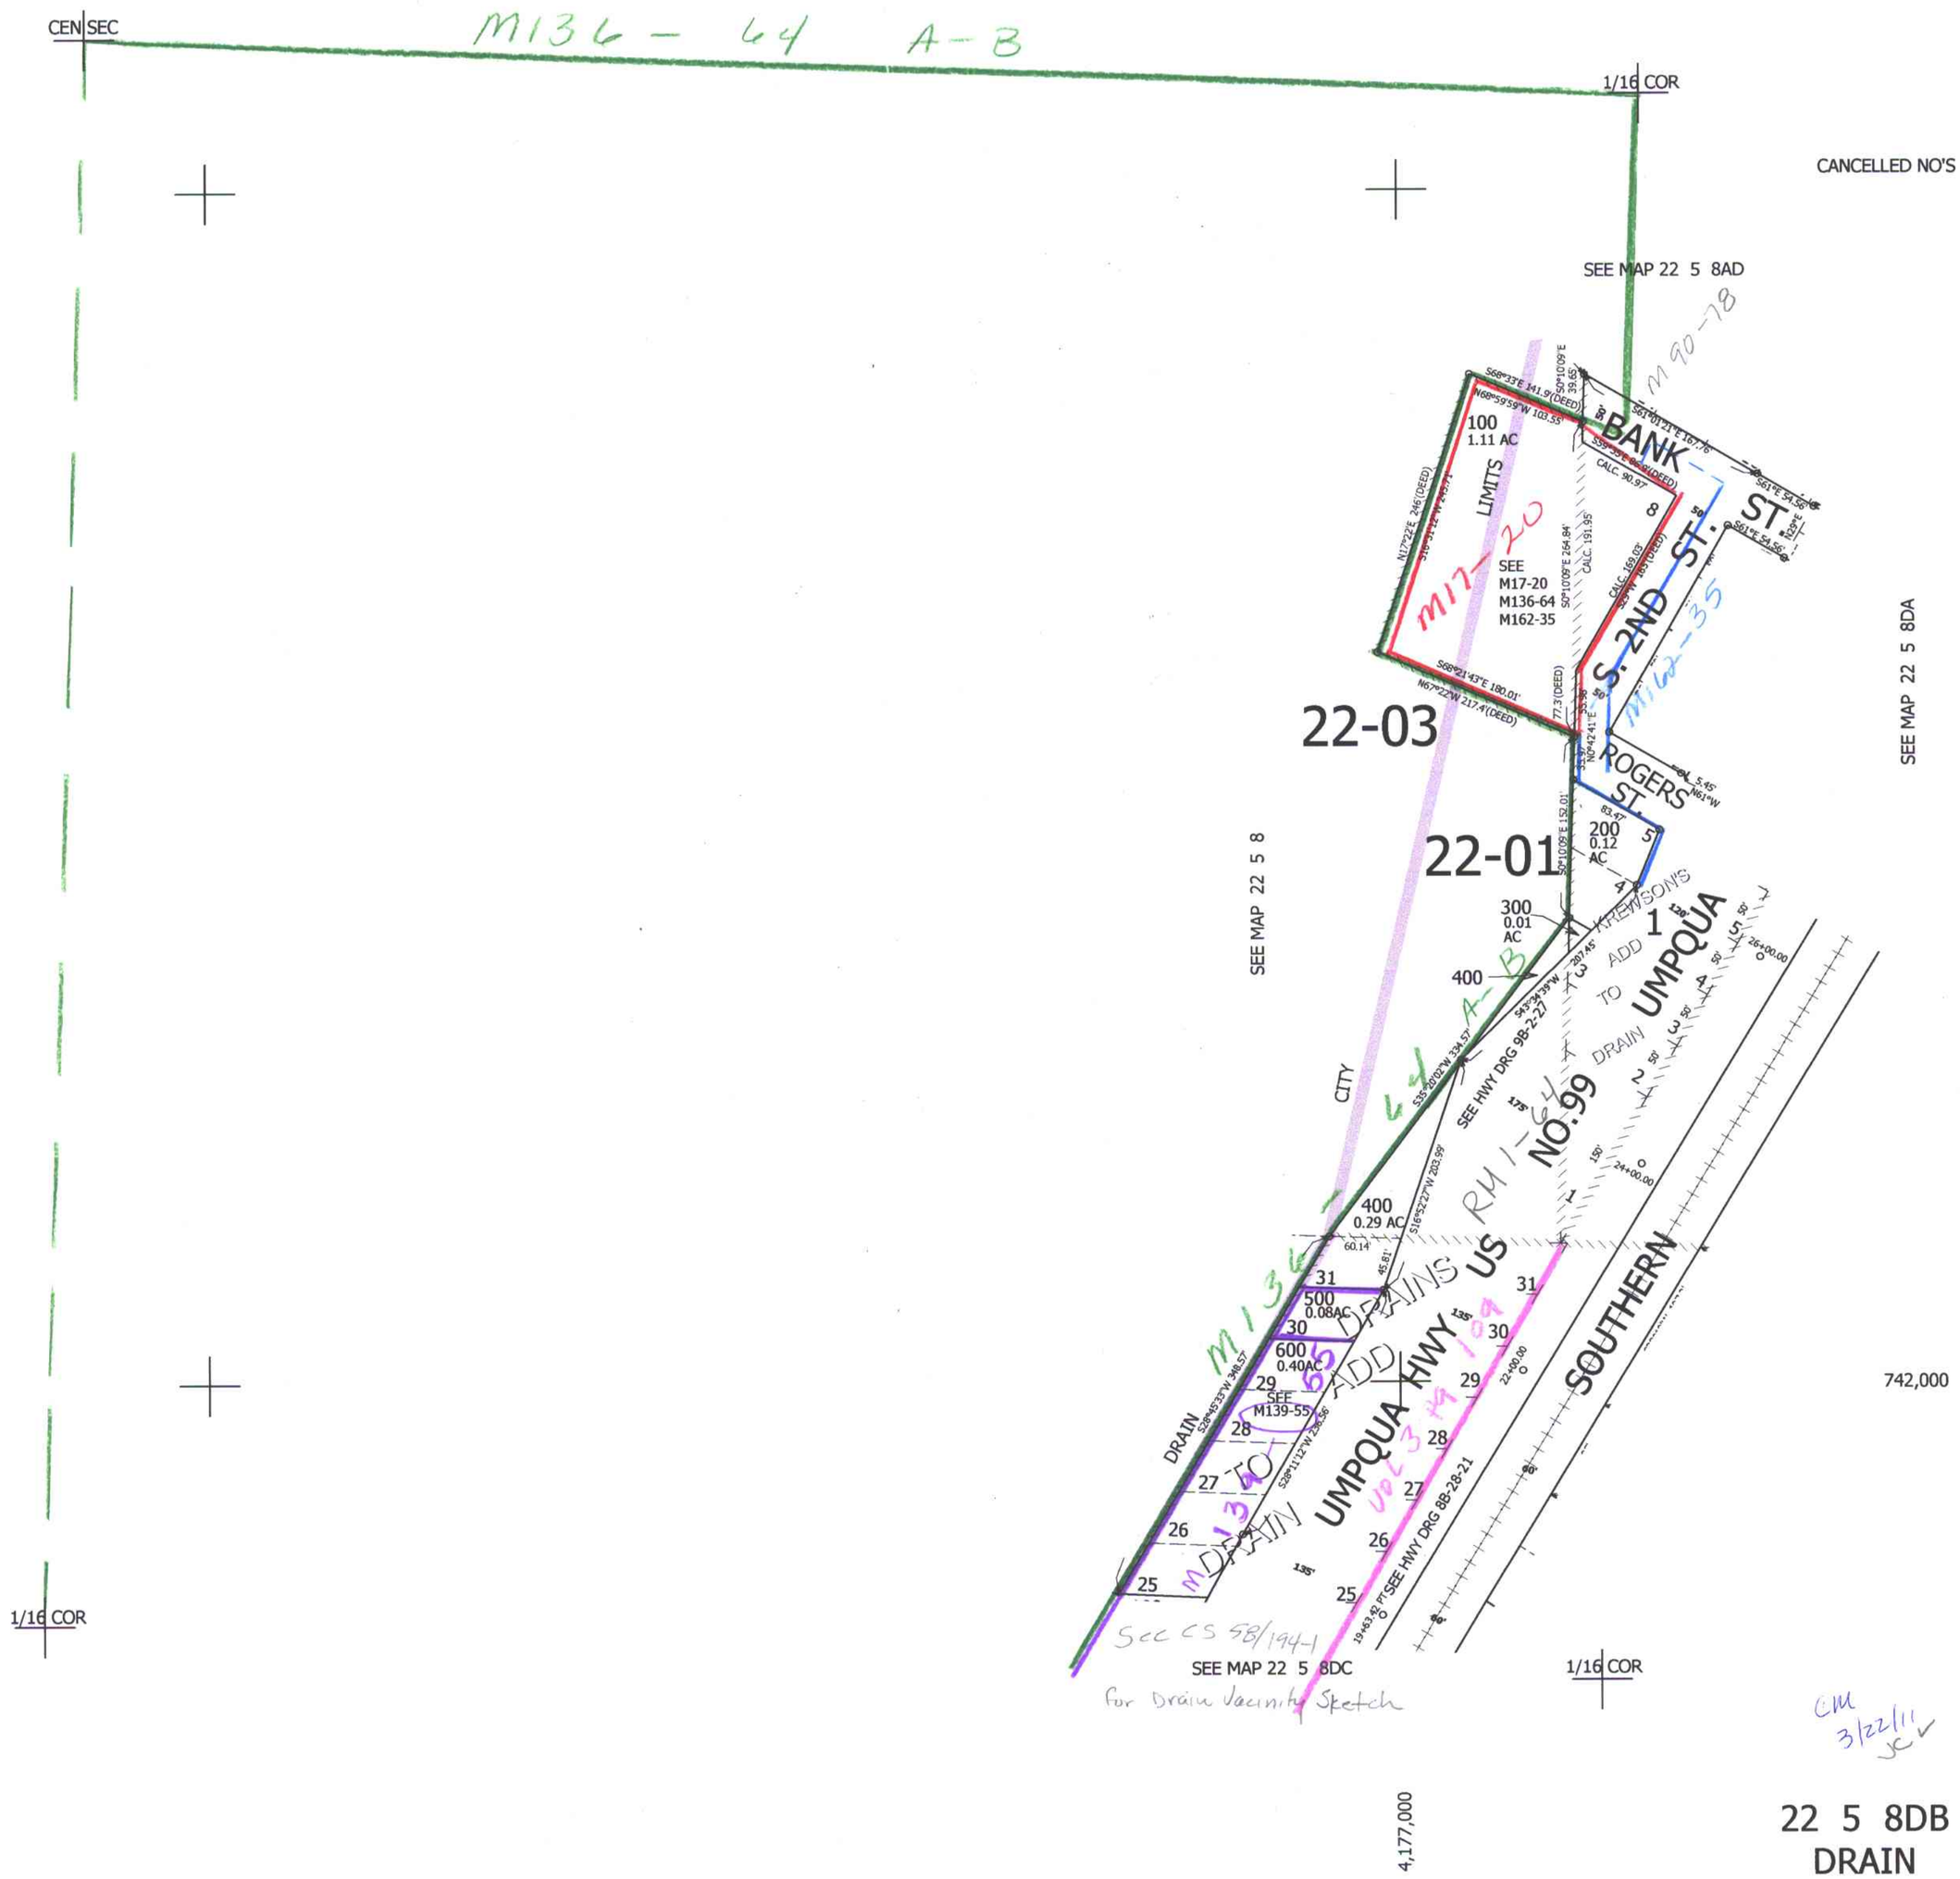

22 5 8DB
DRAIN