NW1/4 SEC. 18 T.22S. R.5W. W.M.
DOUGLAS COUNTY
1"=200'

REVISED ON 12-31-92

THIS MAP WAS PREPARED FOR ASSESSMENT PURPOSE ONLY.

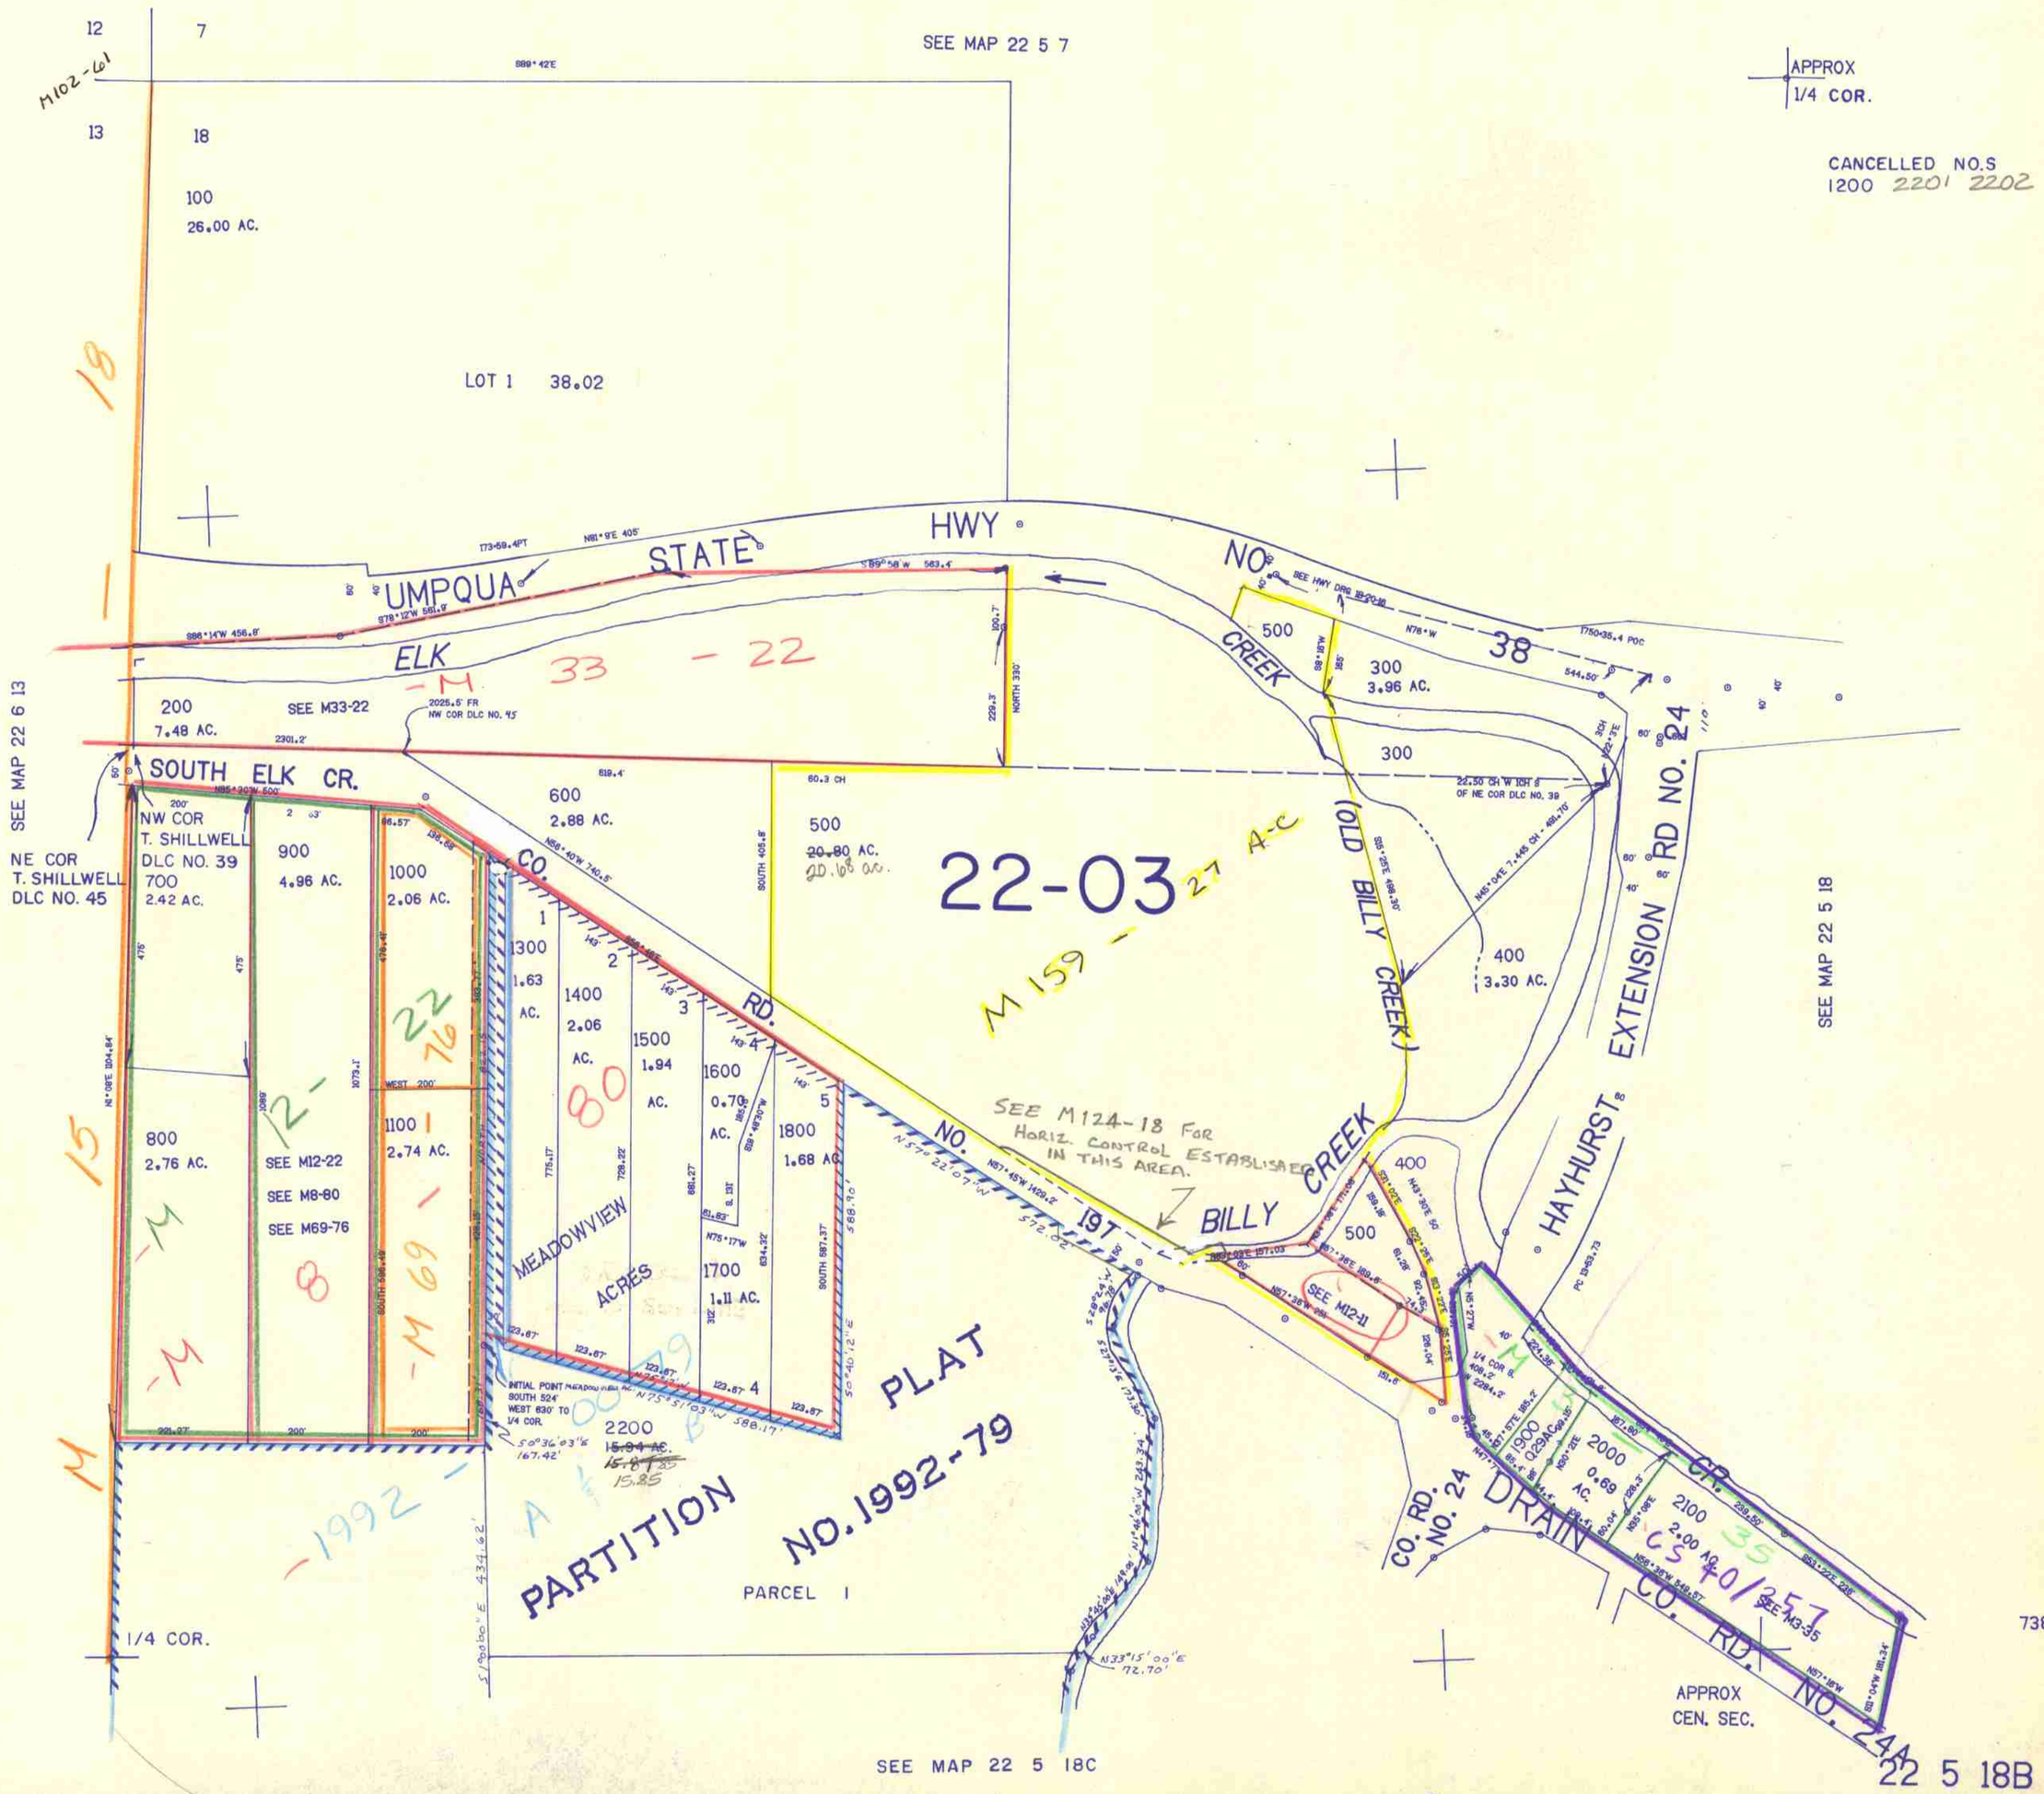

1/93