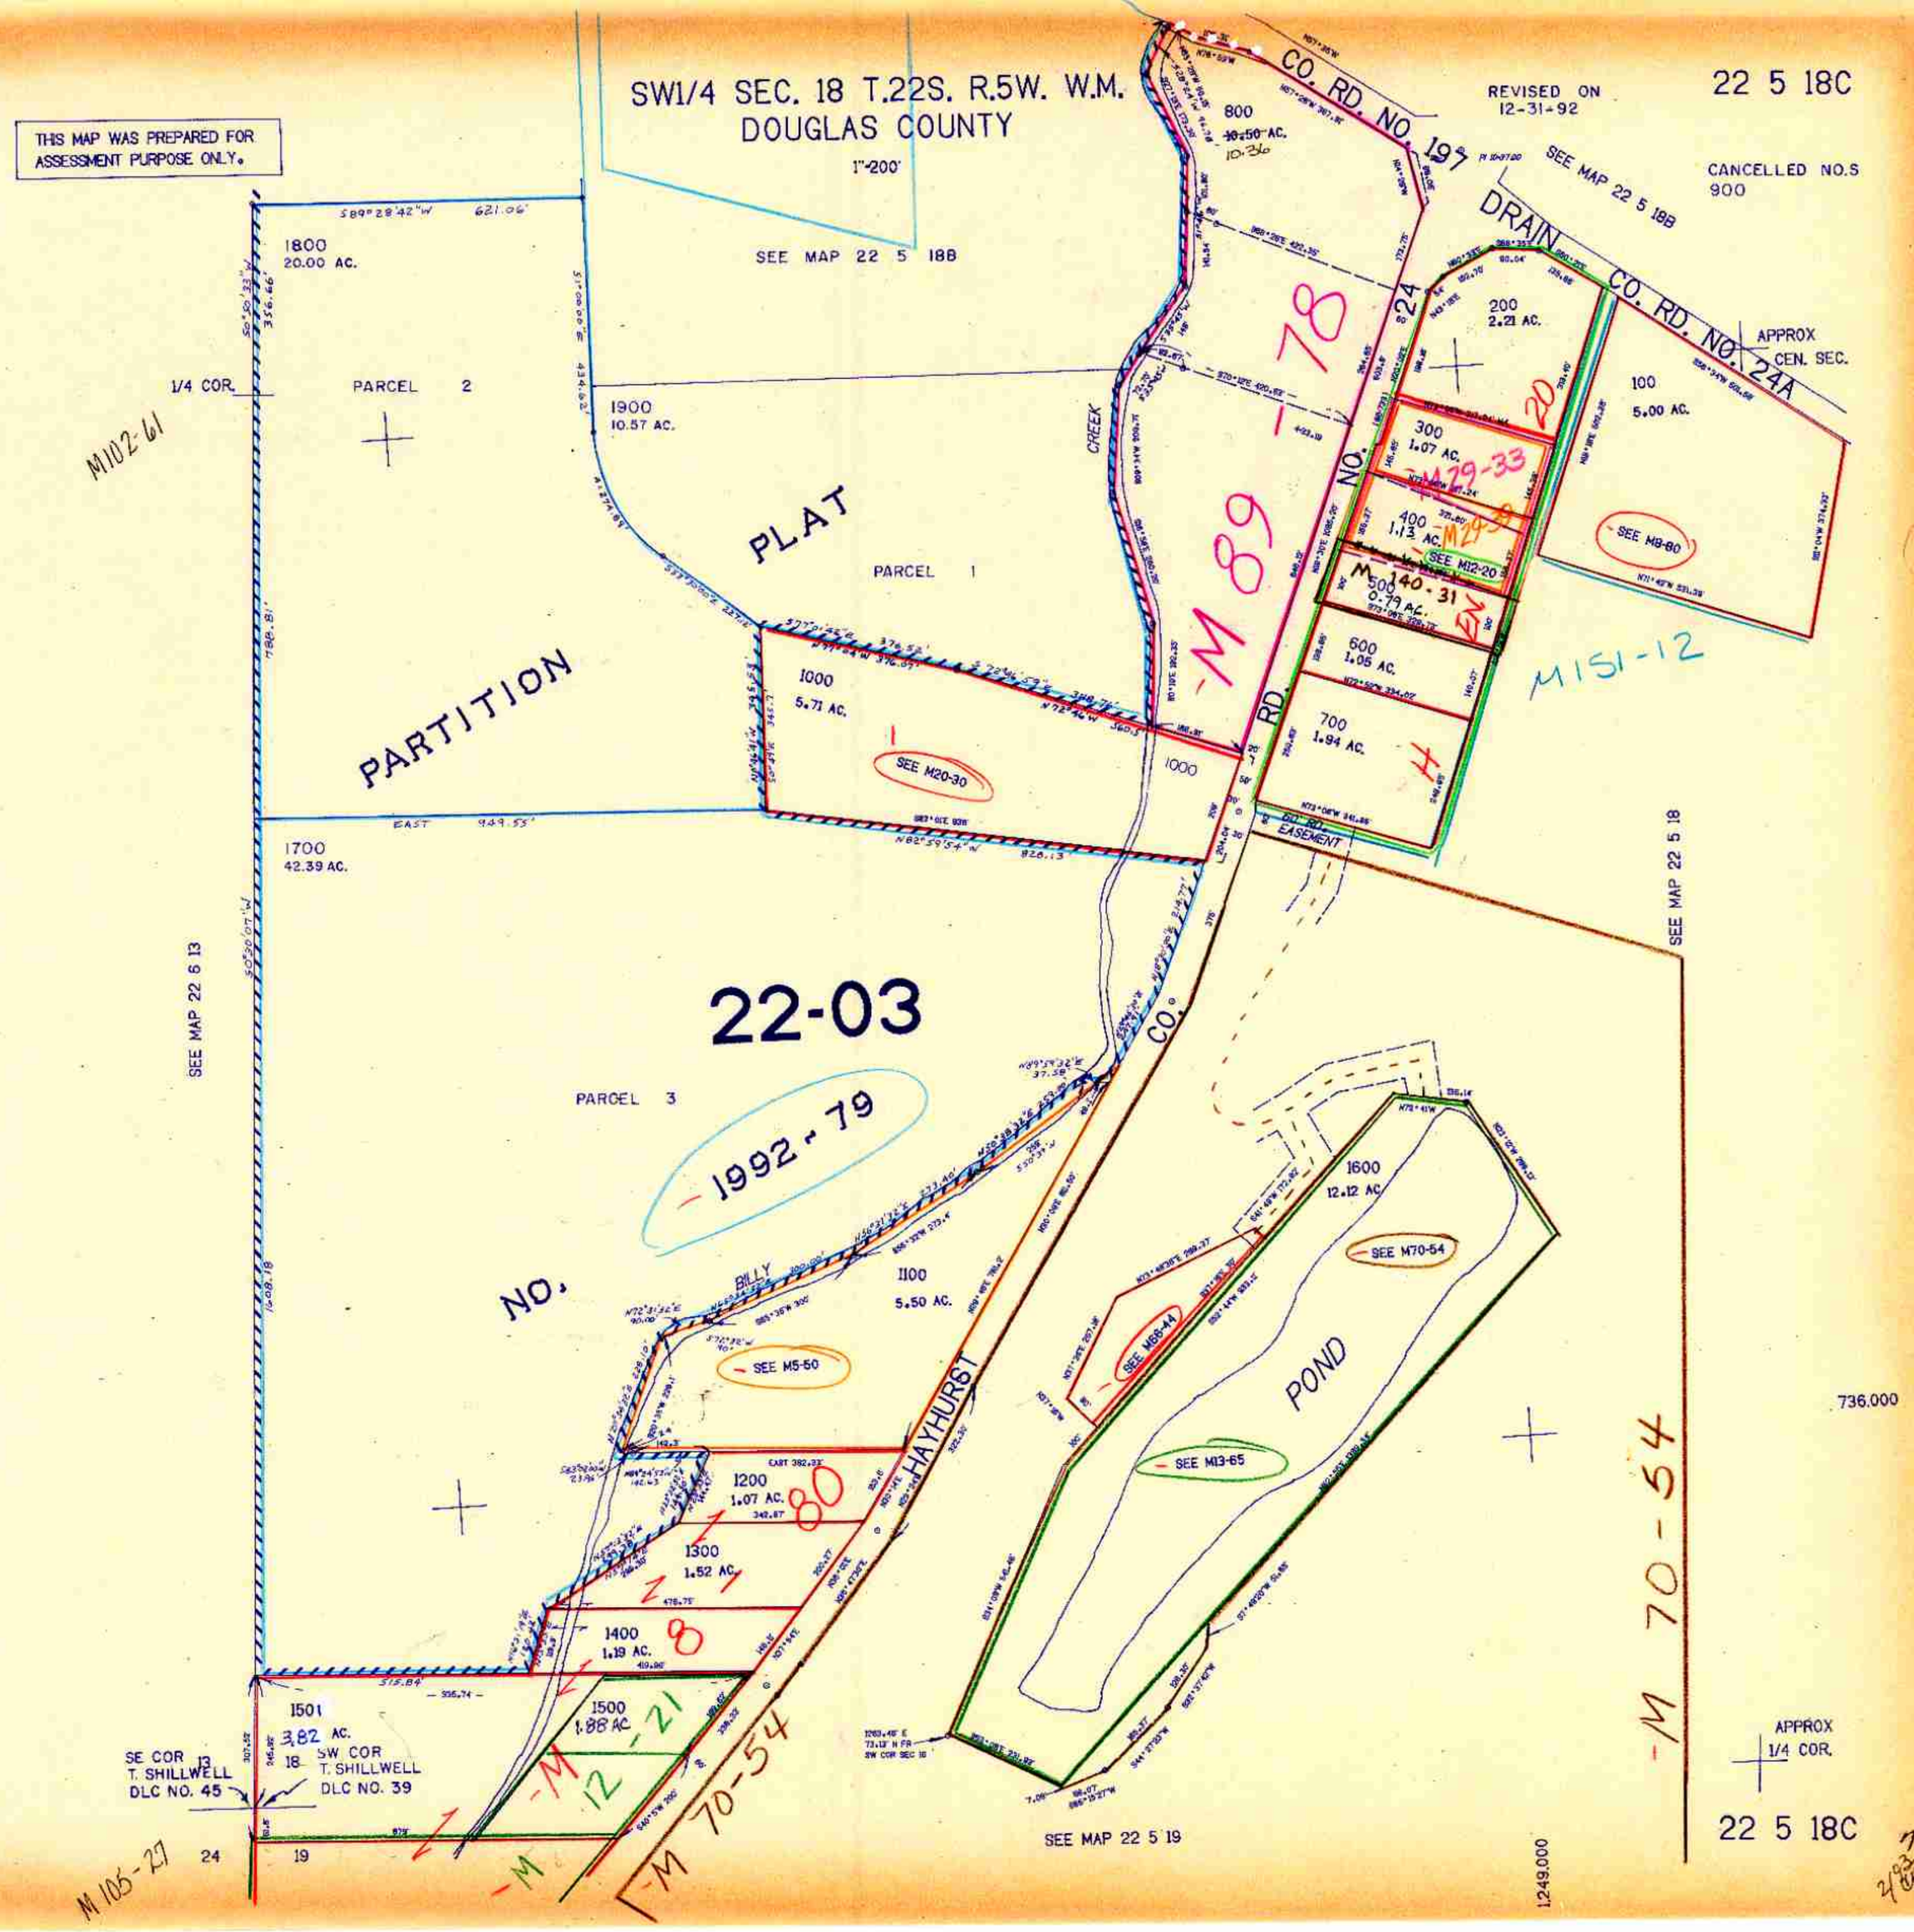
SW1/4 SEC. 18 T.22S. R.5W. W.M.
DOUGLAS COUNTY
1"=200'
THIS MAP WAS PREPARED FOR ASSESSMENT PURPOSE ONLY.
REVISED ON 12-31-92
22 5 18C
CANCELLED NO.S 900
SEE MAP 22 5 18B
CO. RD. NO. 197
DRAIN
CO. RD. NO. 24A
APPROX CEN. SEC.
1/4 COR.
PARCEL 2
PARCEL 1
PARCEL 3
PLAT
PARTITION
CREEK
CO. RD. NO. 24
HAYHURST
BILLY
POND
CO. RD. EASEMENT
SEE MAP 22 6 13
SEE MAP 22 5 18
SEE MAP 22 5 19
22-03
1800 20.00 AC.
1900 10.57 AC.
1000 5.71 AC.
1700 42.39 AC.
800 10.36 AC.
200 2.21 AC.
100 5.00 AC.
300 1.07 AC.
400 1.13 AC.
500 0.79 AC.
600 1.05 AC.
700 1.94 AC.
1600 12.12 AC.
1100 5.50 AC.
1200 1.07 AC.
1300 1.52 AC.
1400 1.19 AC.
1500 1.88 AC.
1501 3.82 AC.
SEE M20-30
SEE M12-20
SEE M8-80
SEE M70-54
SEE M66-44
SEE M13-65
SEE M5-50
SE COR 13 T. SHILLWELL DLC NO. 45
SW COR 18 T. SHILLWELL DLC NO. 39
APPROX 1/4 COR.
736.000
1249.000
M102-61
M 89-78
M29-33
M29-39
M 140-31
M151-12
M 70-54
M 12-21
M 105-27
1992-79