SECTION 19 T.22S. R.5W. W.M.

DOUGLAS COUNTY

1"=400'

22 5 19

THIS MAP WAS PREPARED FOR ASSESSMENT PURPOSE ONLY.

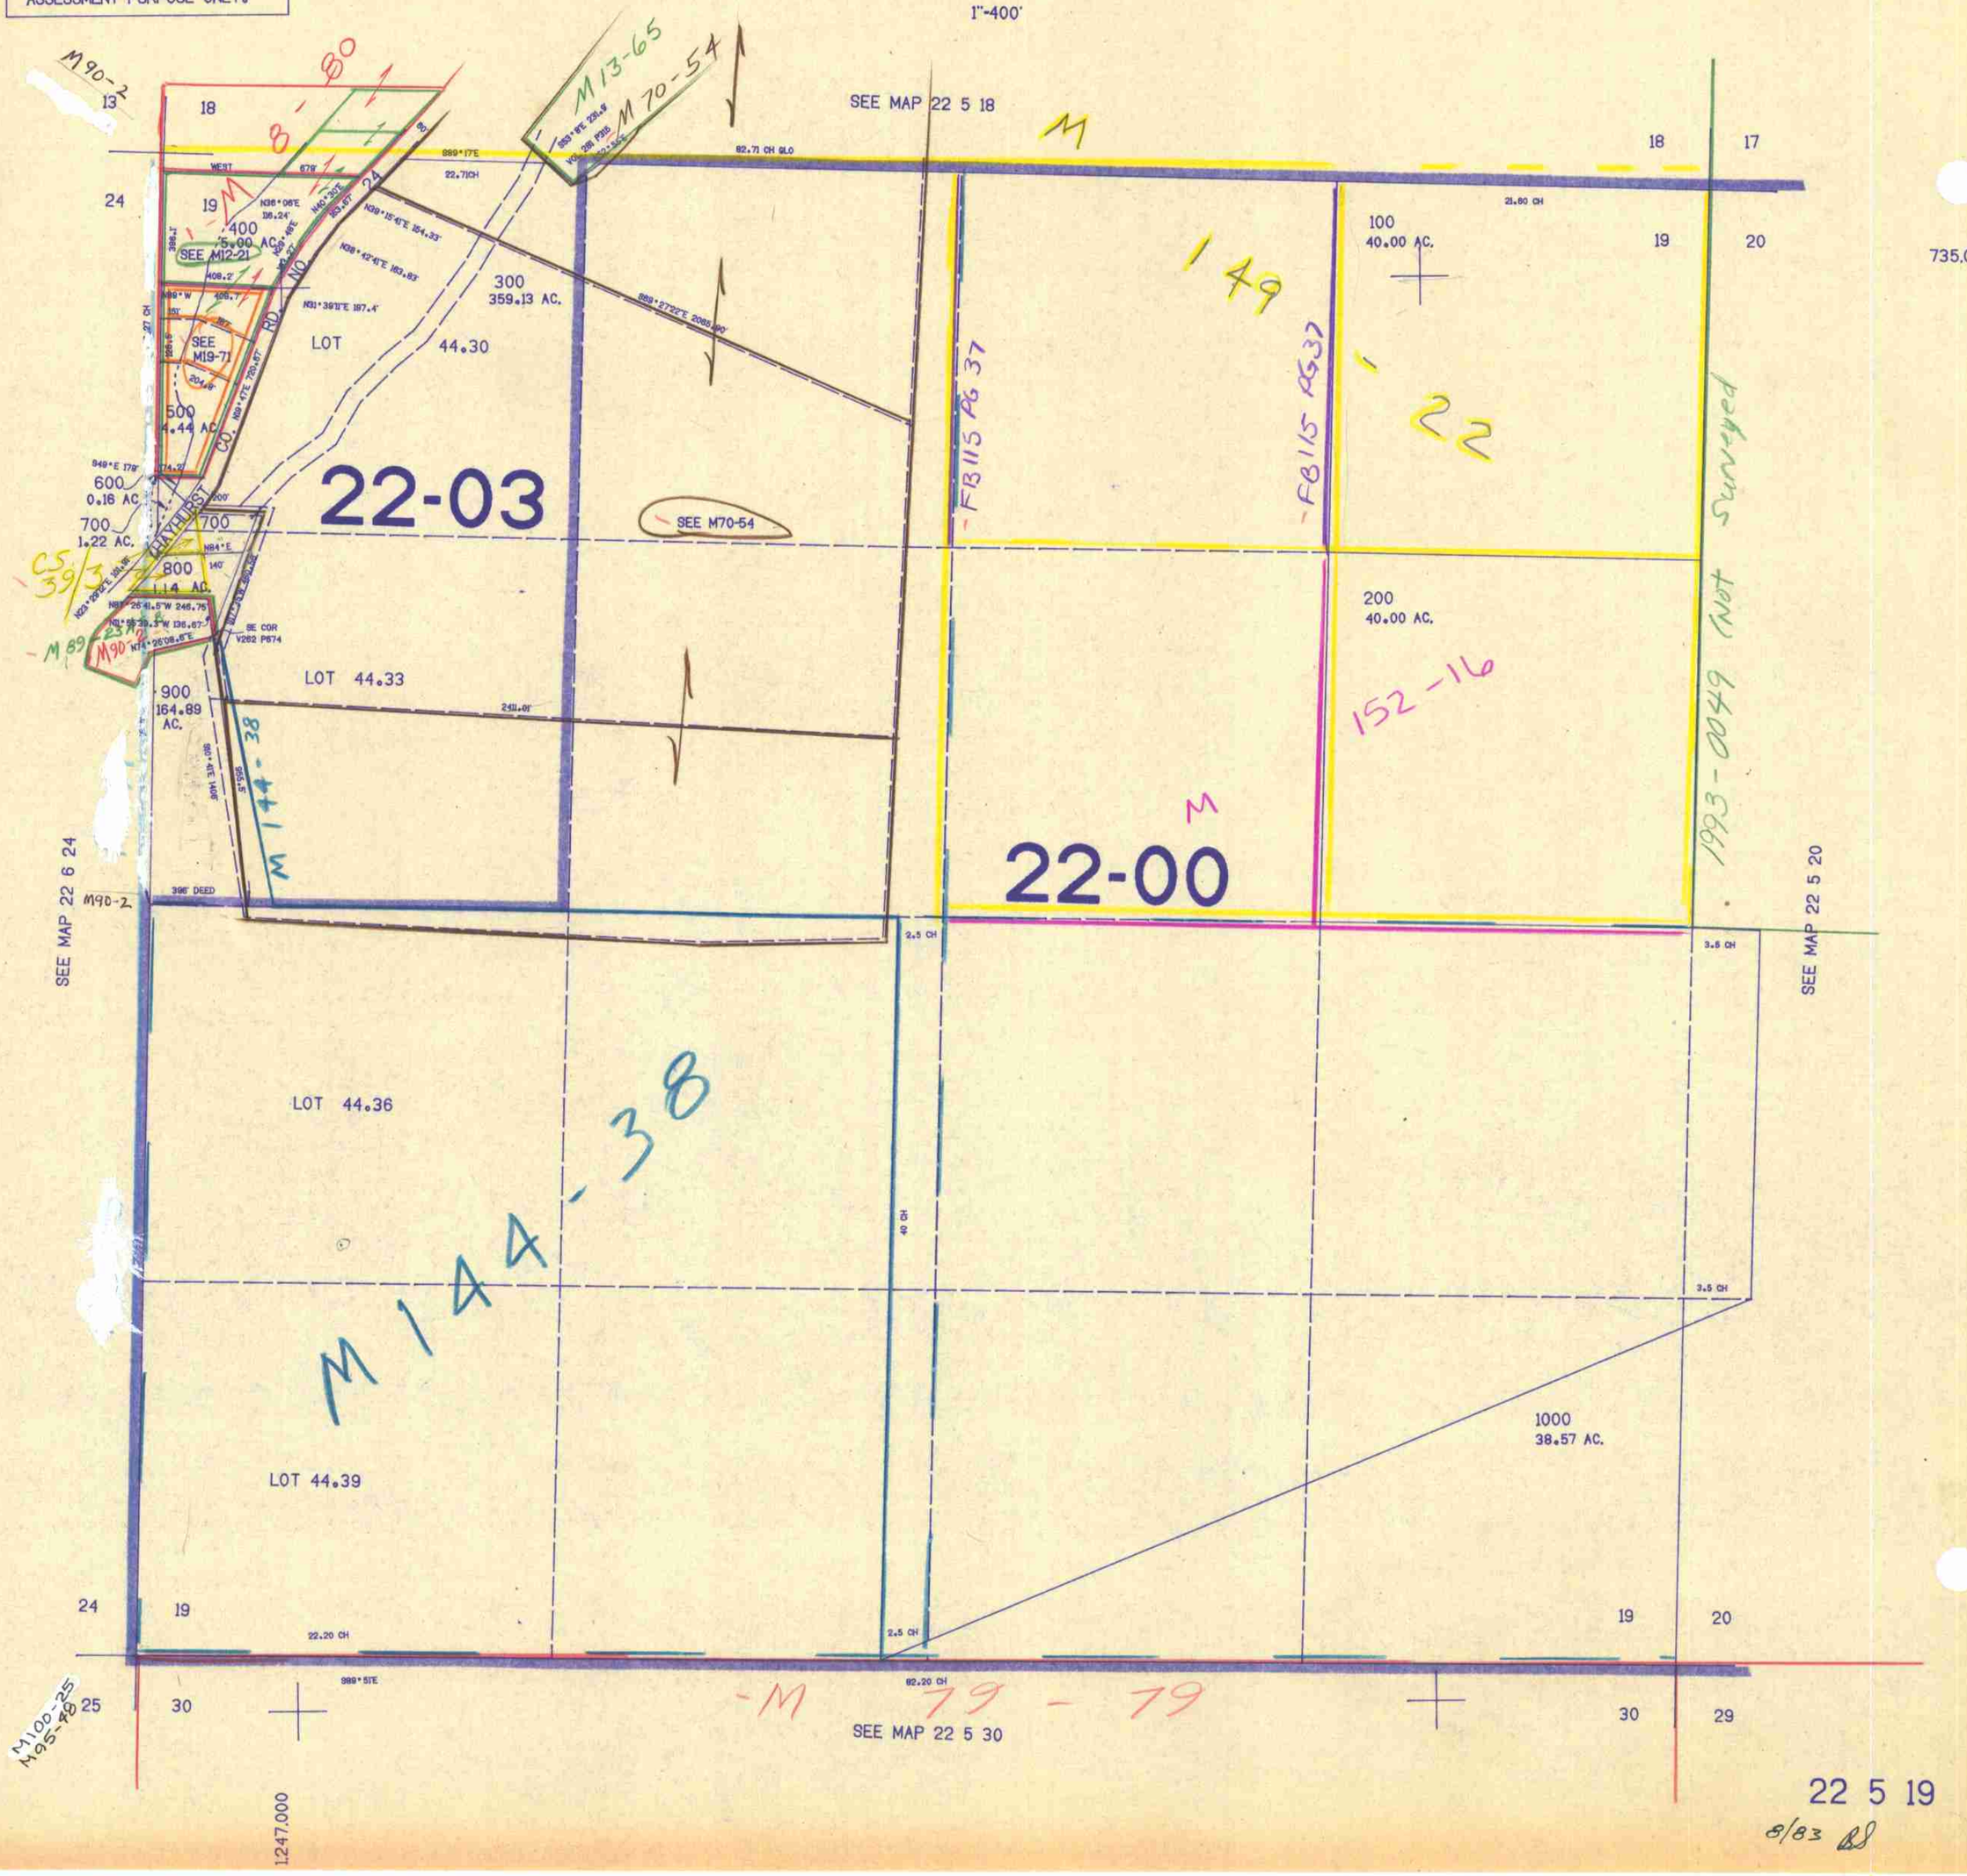

22 5 19

8/83