


SECTION 29 T.22S. R.5W. W.M.
DOUGLAS COUNTY

22 5 29

THIS MAP WAS PREPARED FOR
ASSESSMENT PURPOSE ONLY.

1"=400'

REVISED ON
4-19-91

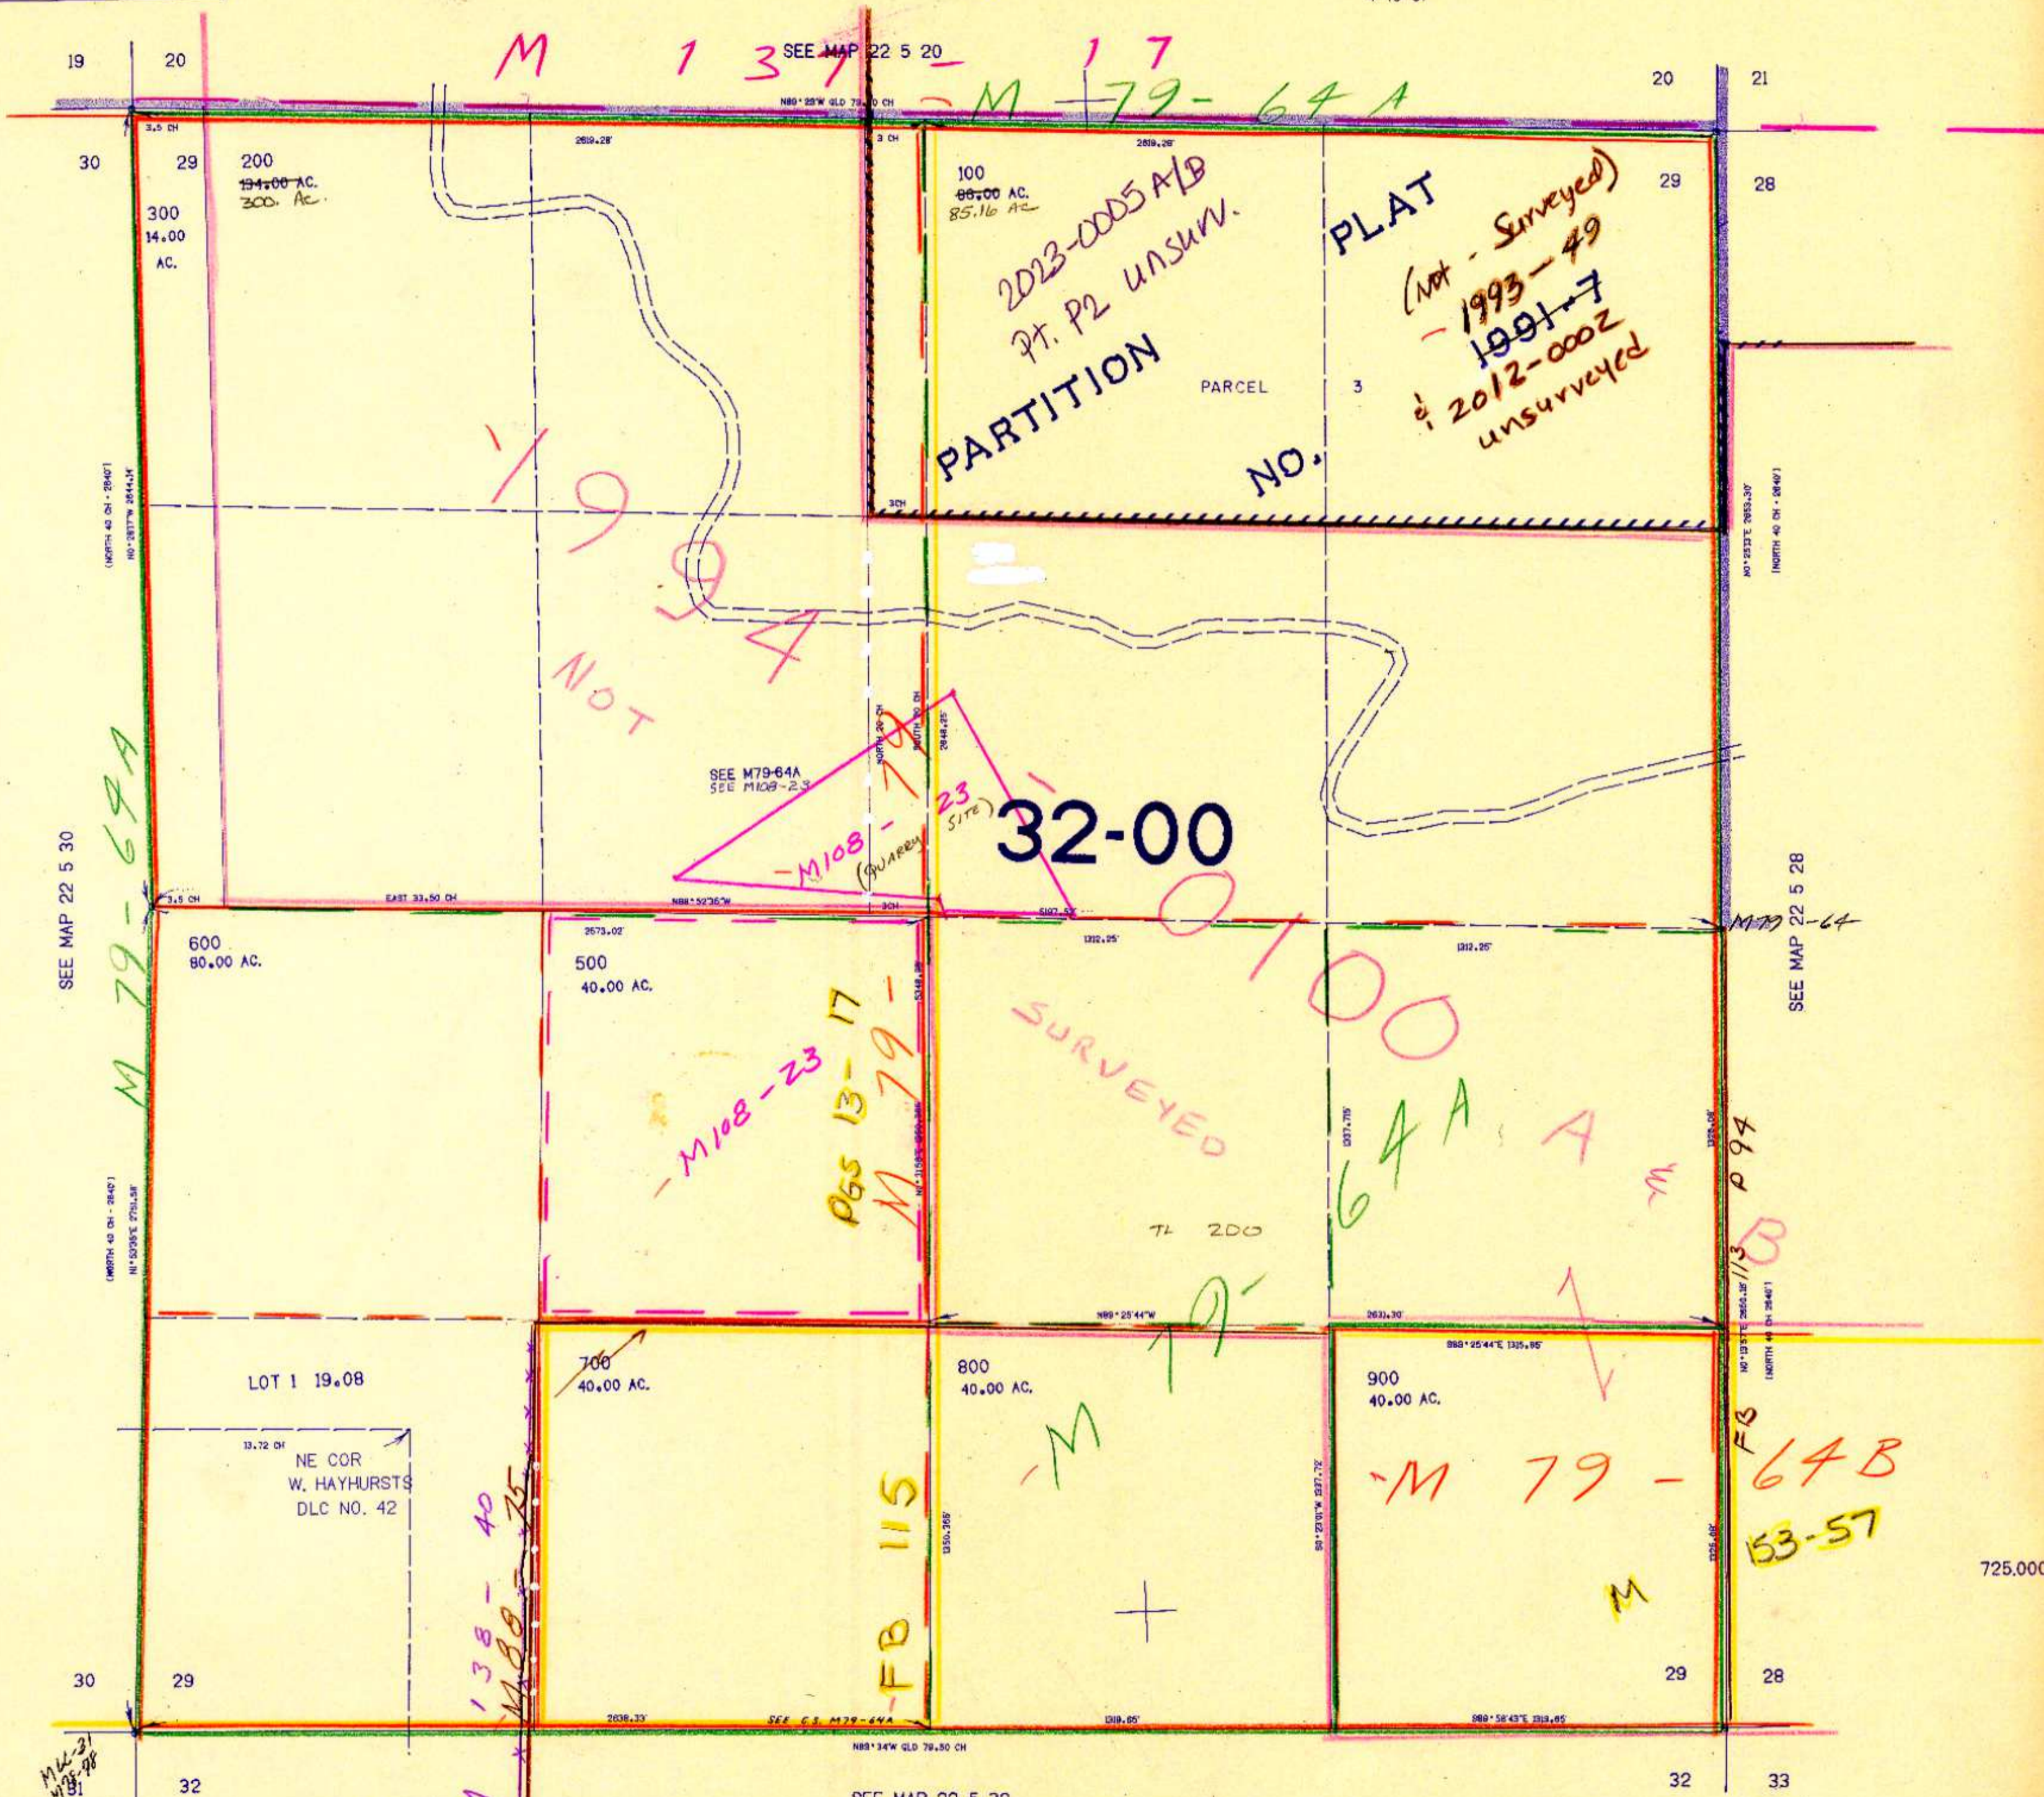

SEE MAP 22 5 30

M 79-69A

M 79-64A

M 79-64B





