


THIS MAP WAS PREPARED FOR ASSESSMENT PURPOSE ONLY.

SEC.32 T.22S. R.5W. W.M.  
DOUGLAS COUNTY  
1" = 400'

REVISED ON  
5-16-02

22 5 32

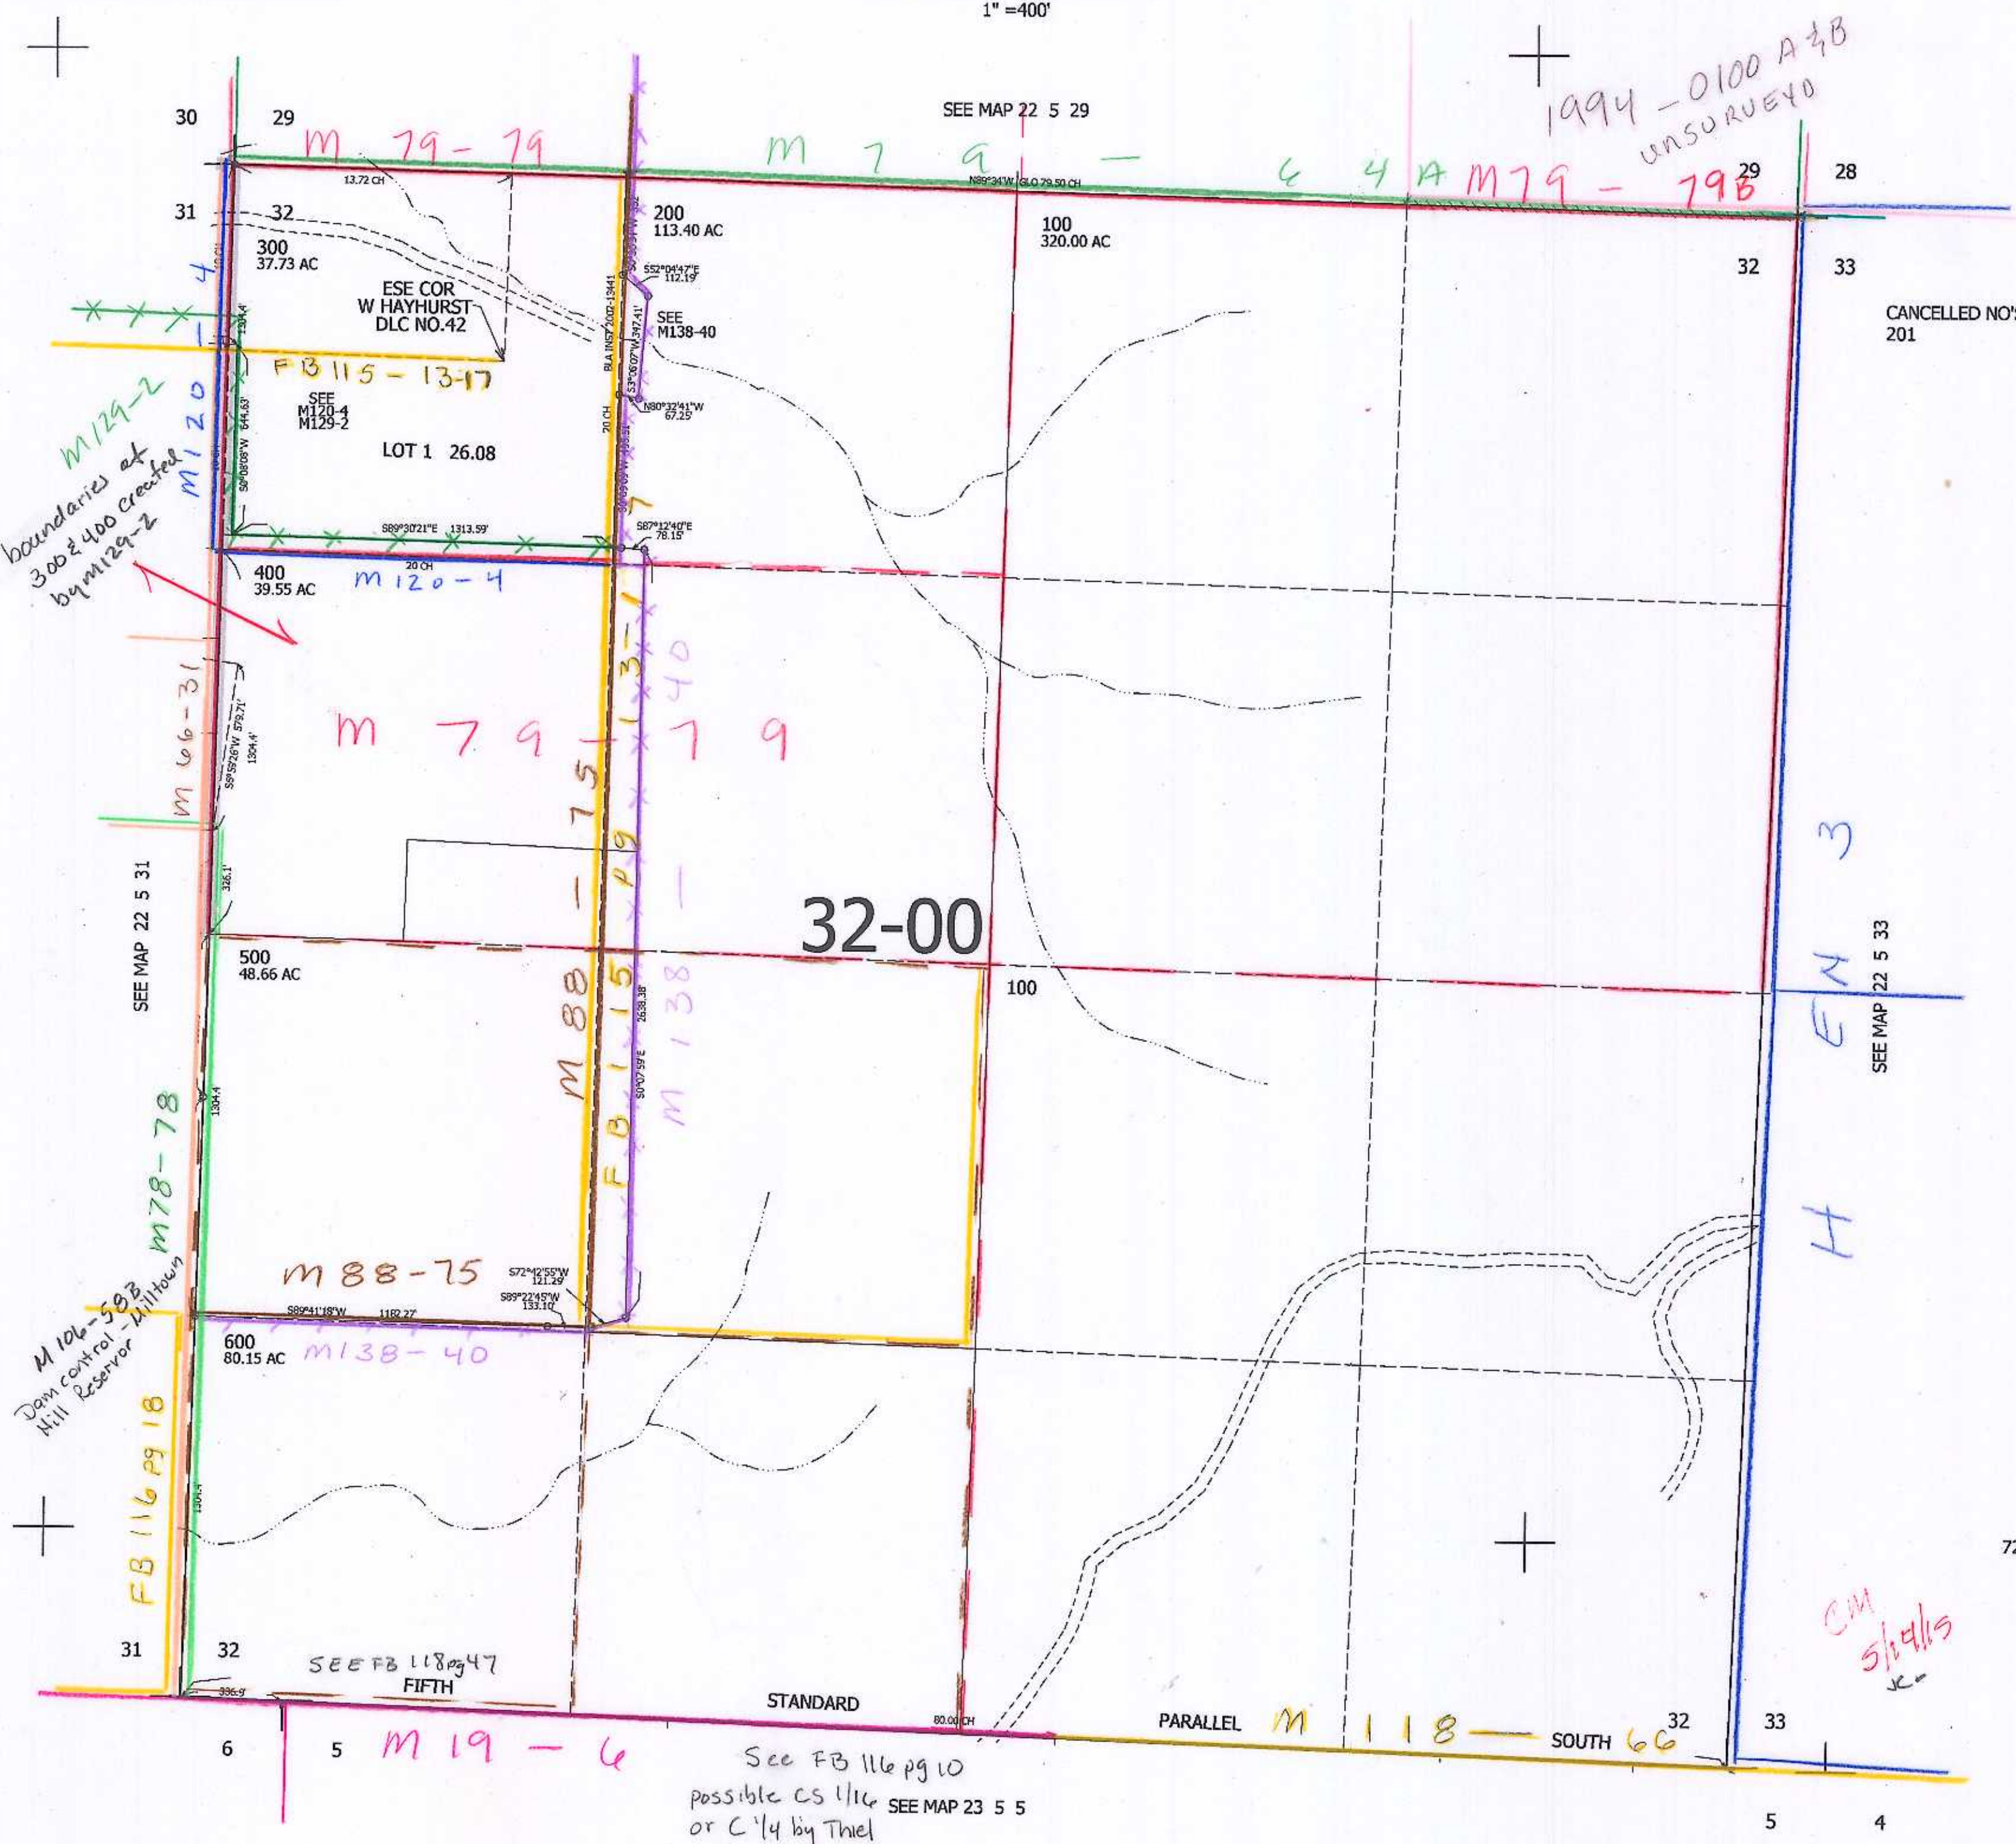

1994-0100 A & B  
UNSURVEYED

M129-2  
boundaries of  
300 & 400 created  
by M129-2

M106-50B  
Dam control - Milltown  
Reservoir

H  
E  
N  
3

CM  
shells  
K

See FB 116 pg 10  
possible CS 1/16  
or C 1/4 by Thiel  
SEE MAP 23 5 5

4,177,000

22 5 32