THIS MAP WAS PREPARED FOR ASSESSMENT PURPOSE ONLY.

SECTION 25 T.22S. R.6W. W.M.
DOUGLAS COUNTY

1"=400'

22 6 25

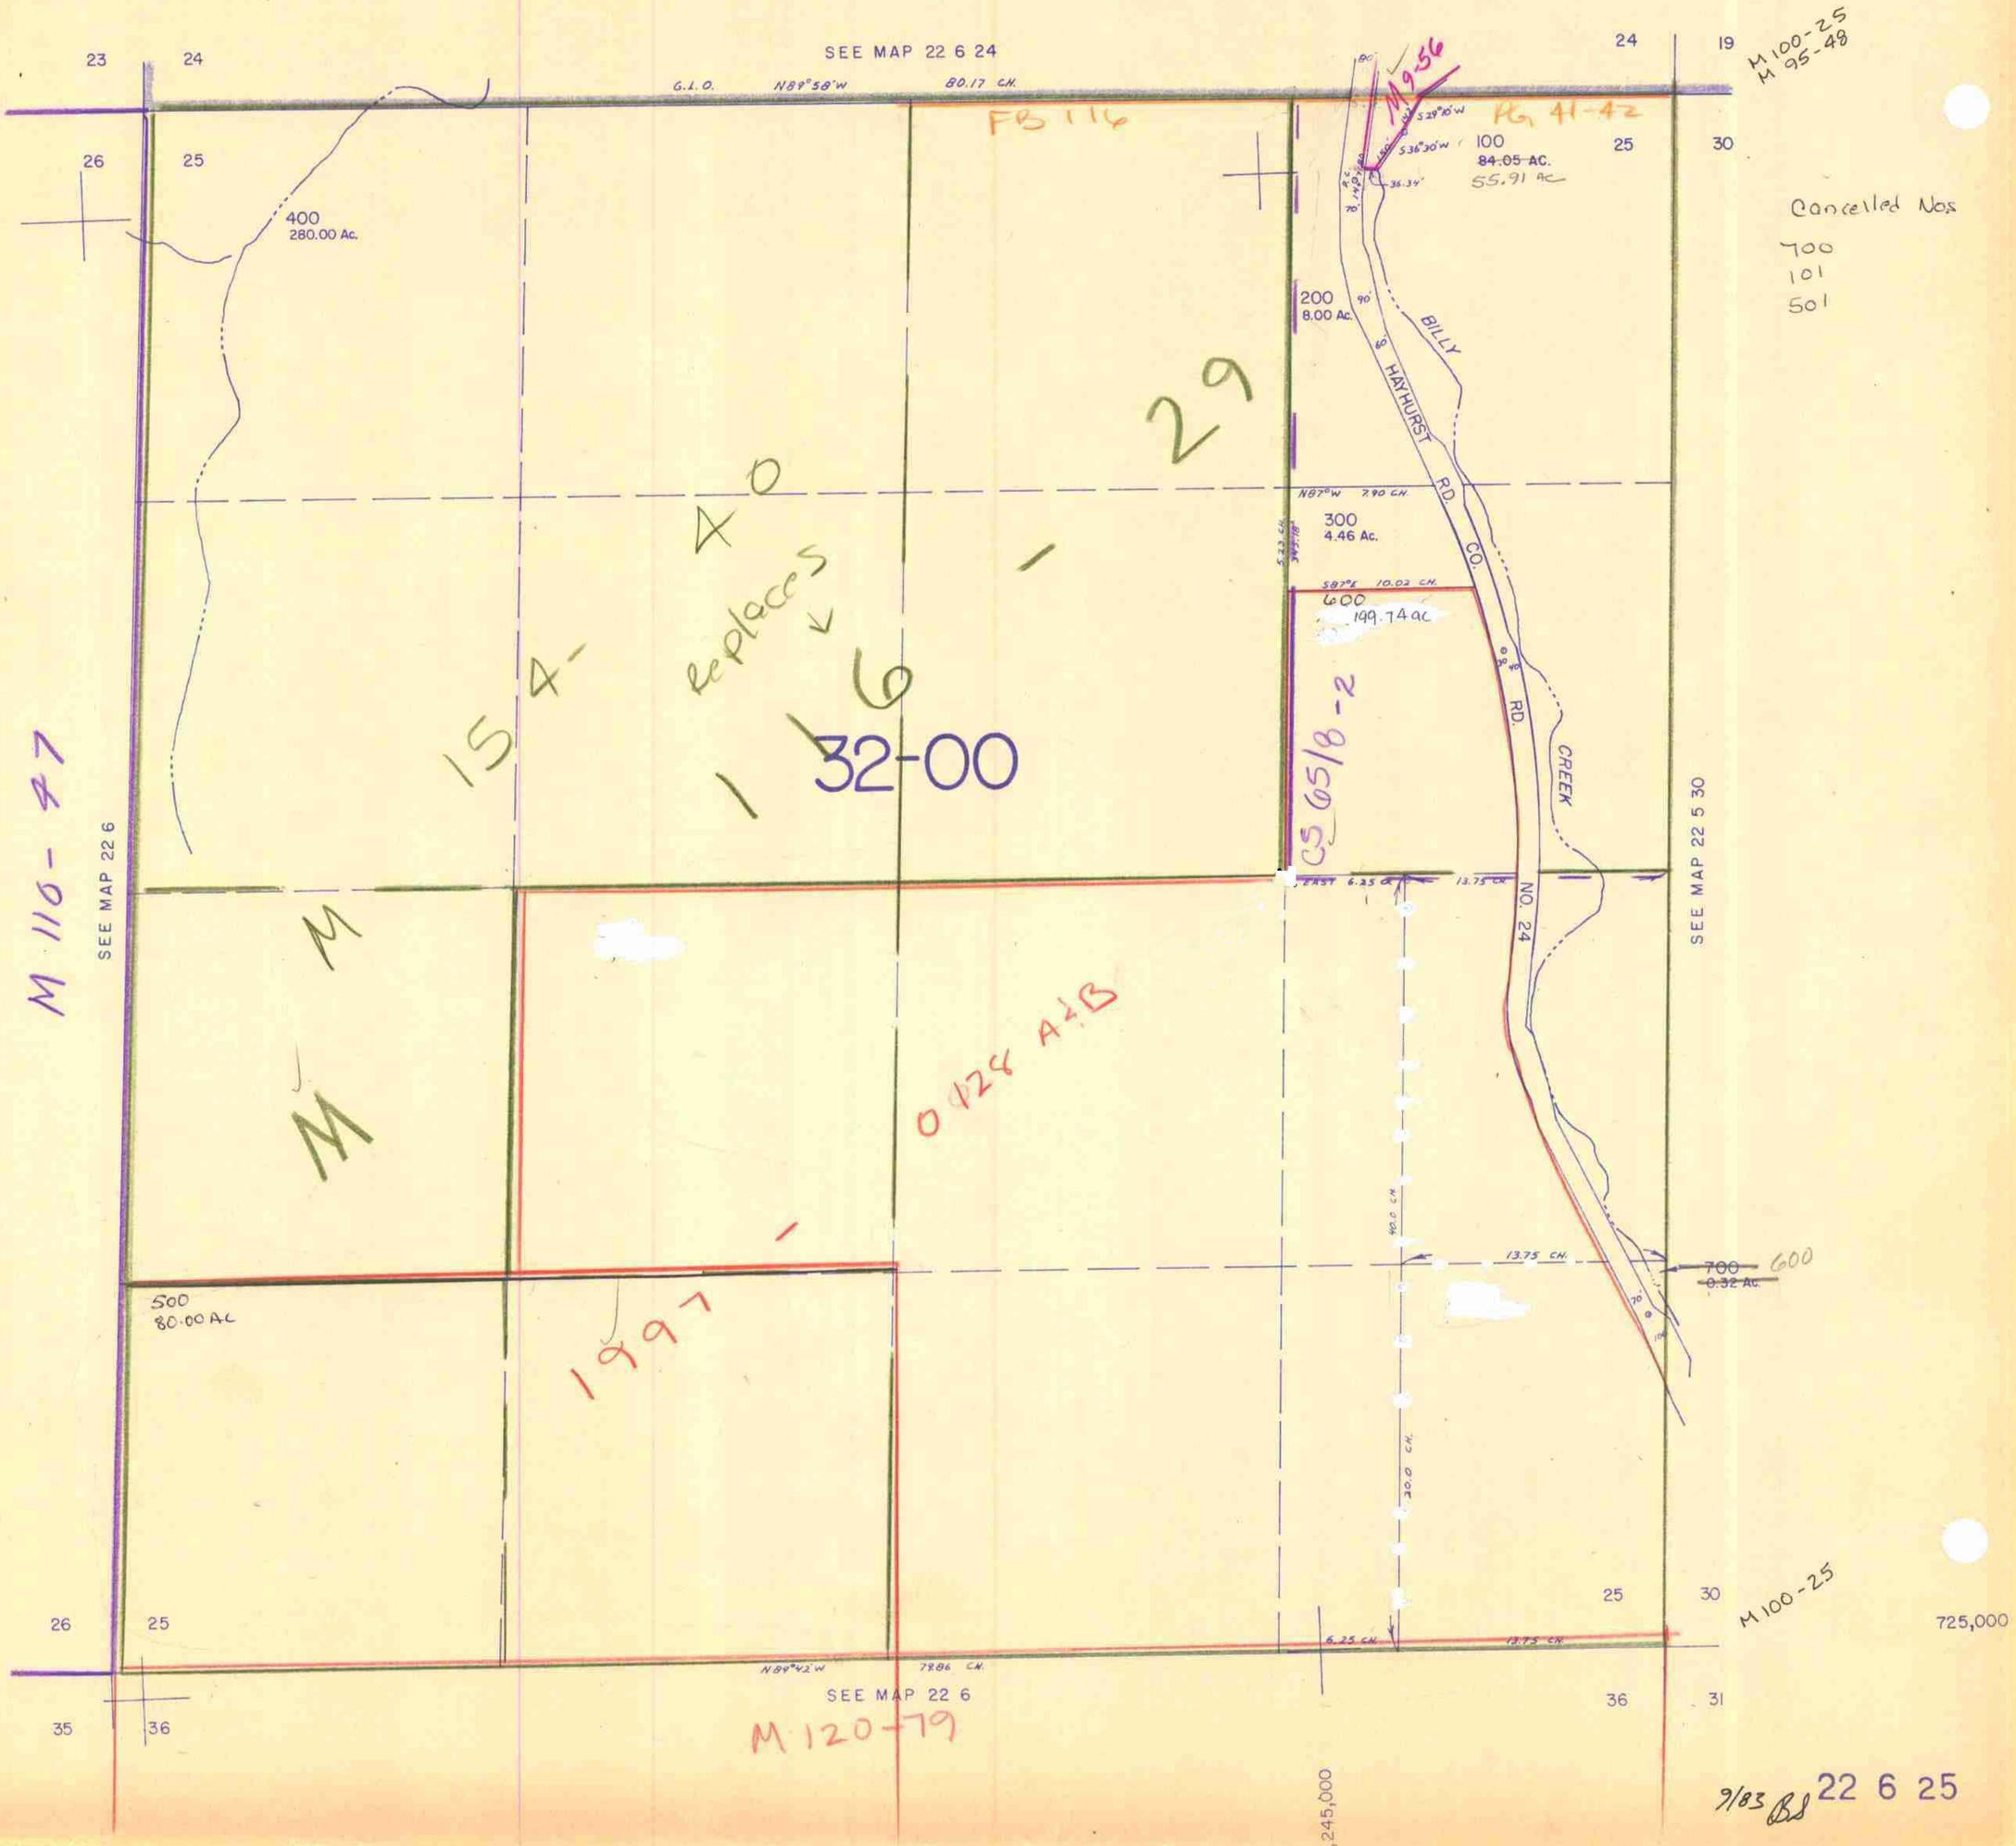

9/83 BJ

22 6 25