SECTION 15 T.22S. R.7W. W.M.
DOUGLAS COUNTY

THIS MAP WAS PREPARED FOR ASSESSMENT PURPOSE ONLY.
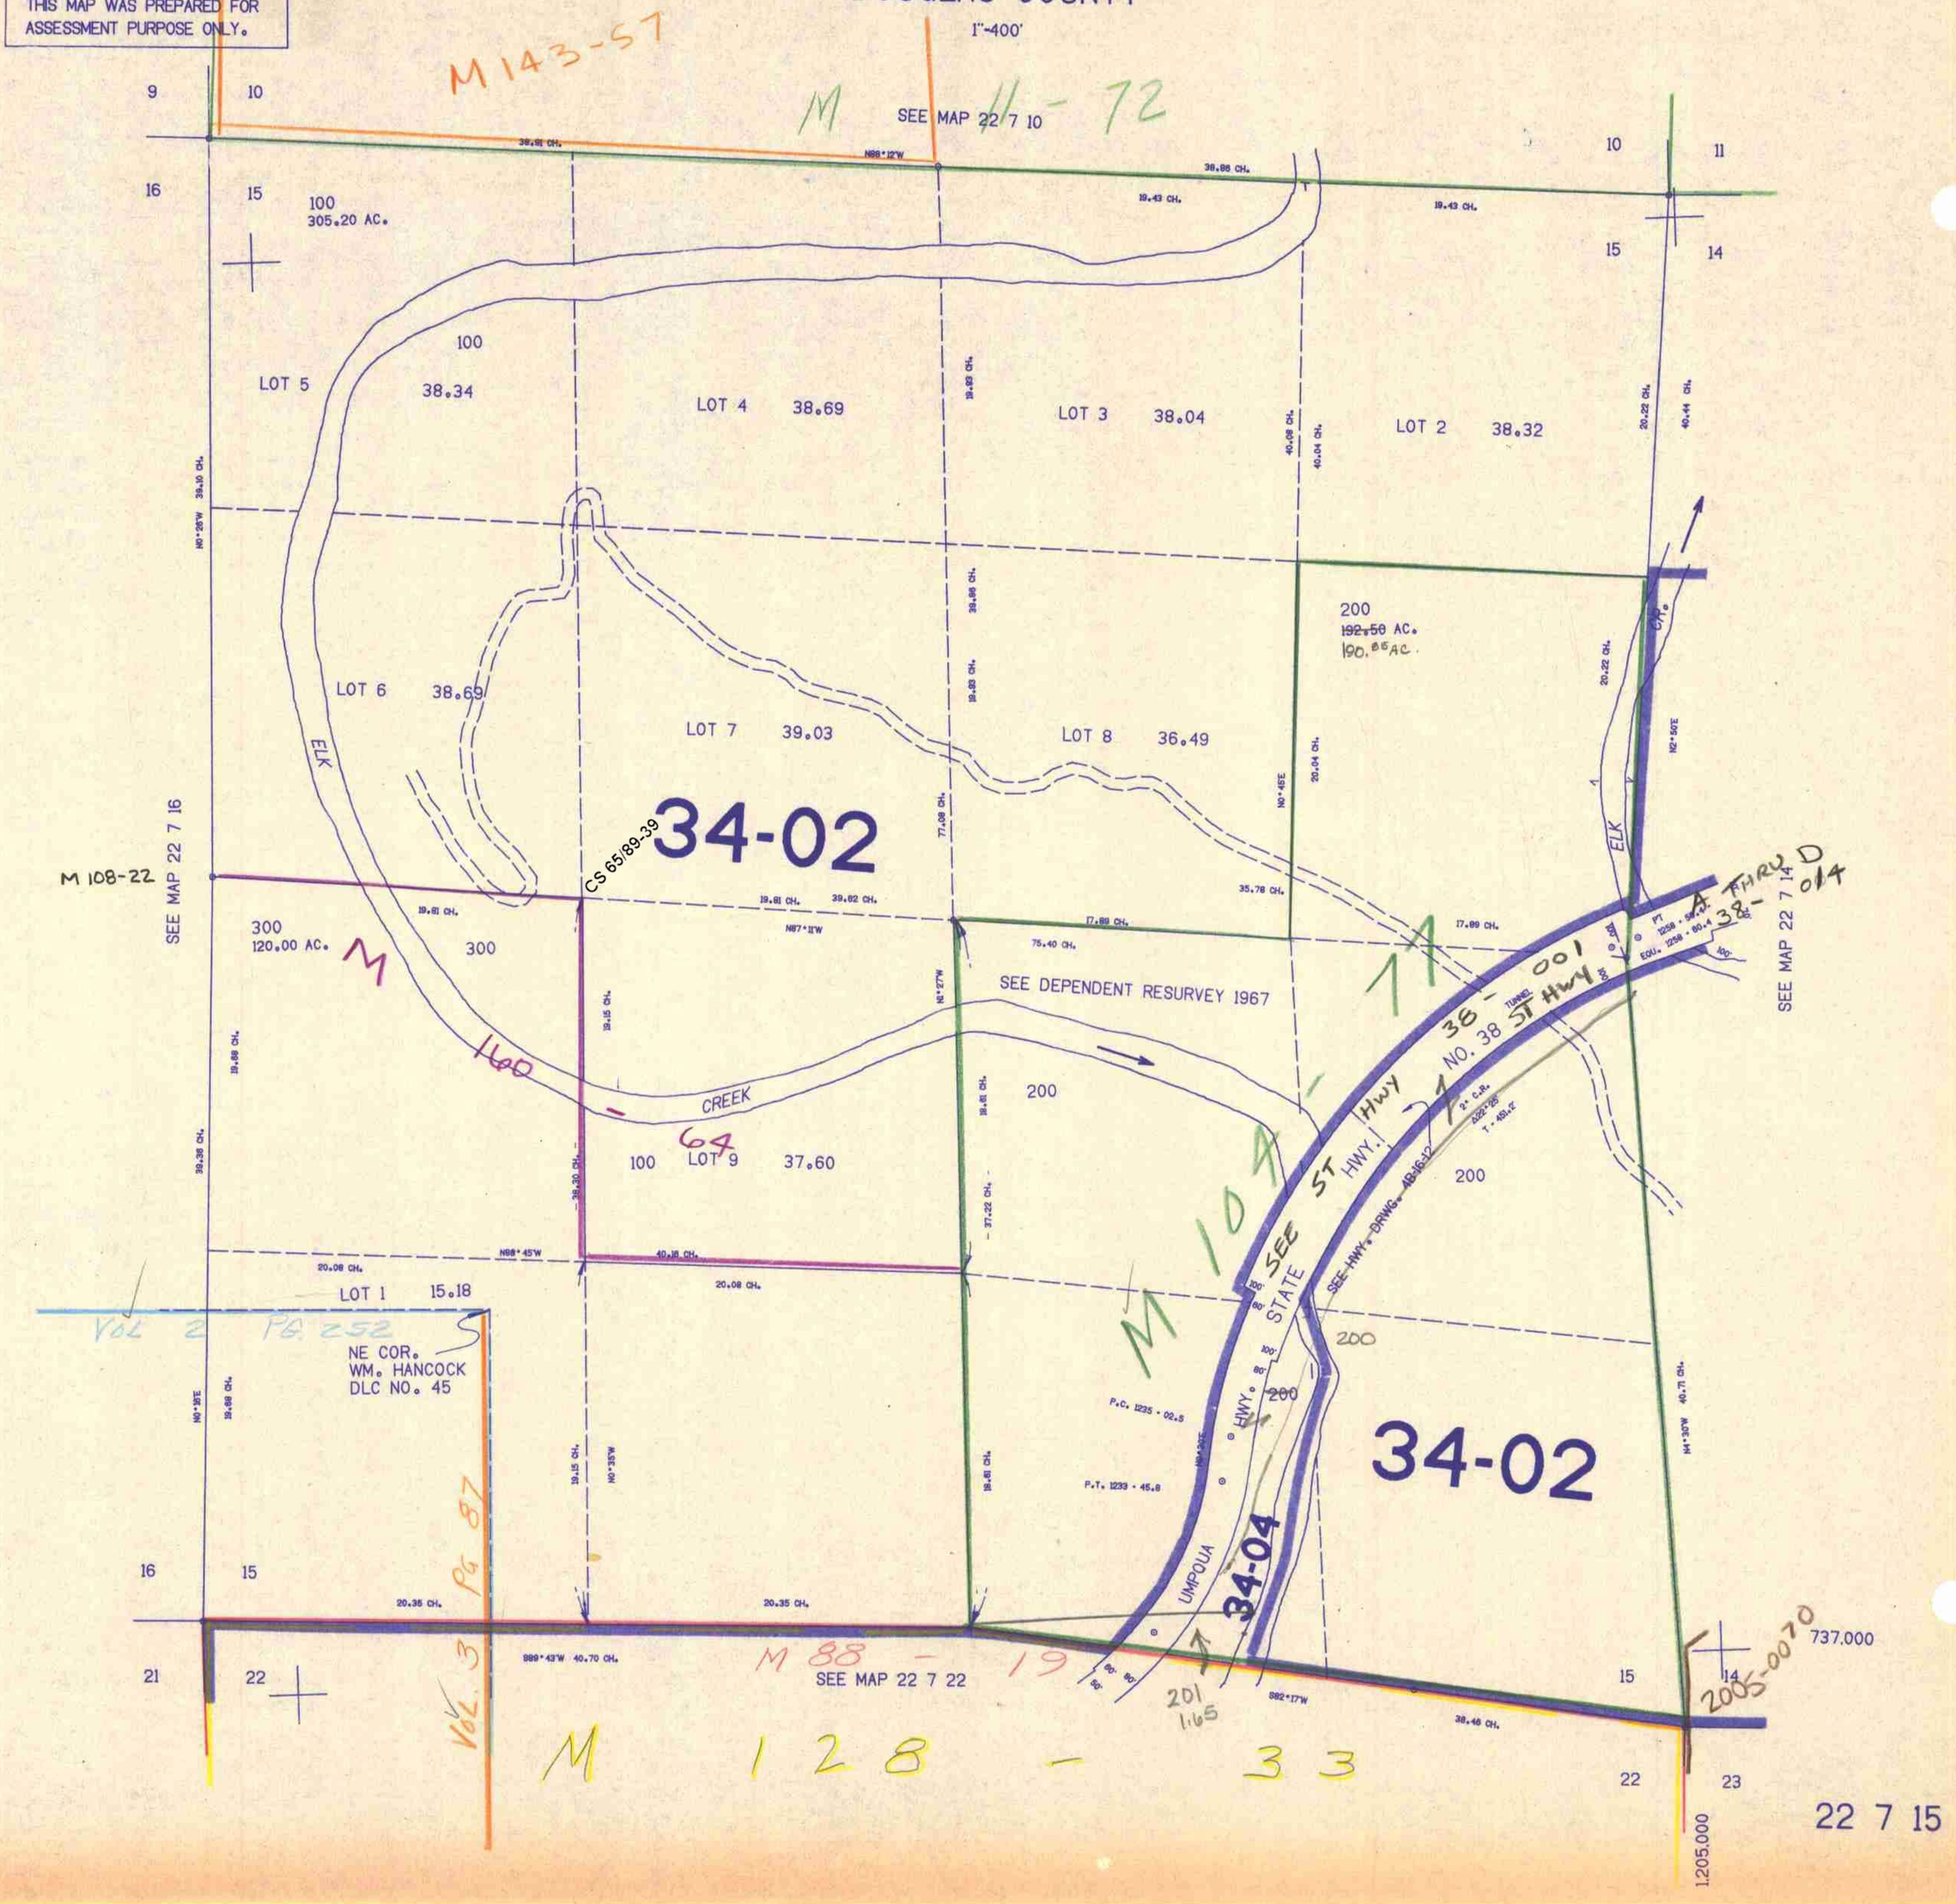
1"=400'