NW1/4 SW1/4 SEC. 20 T.22S. R.7W. W.M.
DOUGLAS COUNTY

1"=100'

22 7 20CB
ELKTON

THIS MAP WAS PREPARED FOR ASSESSMENT PURPOSE ONLY.

APPROX.
1/4 COR.

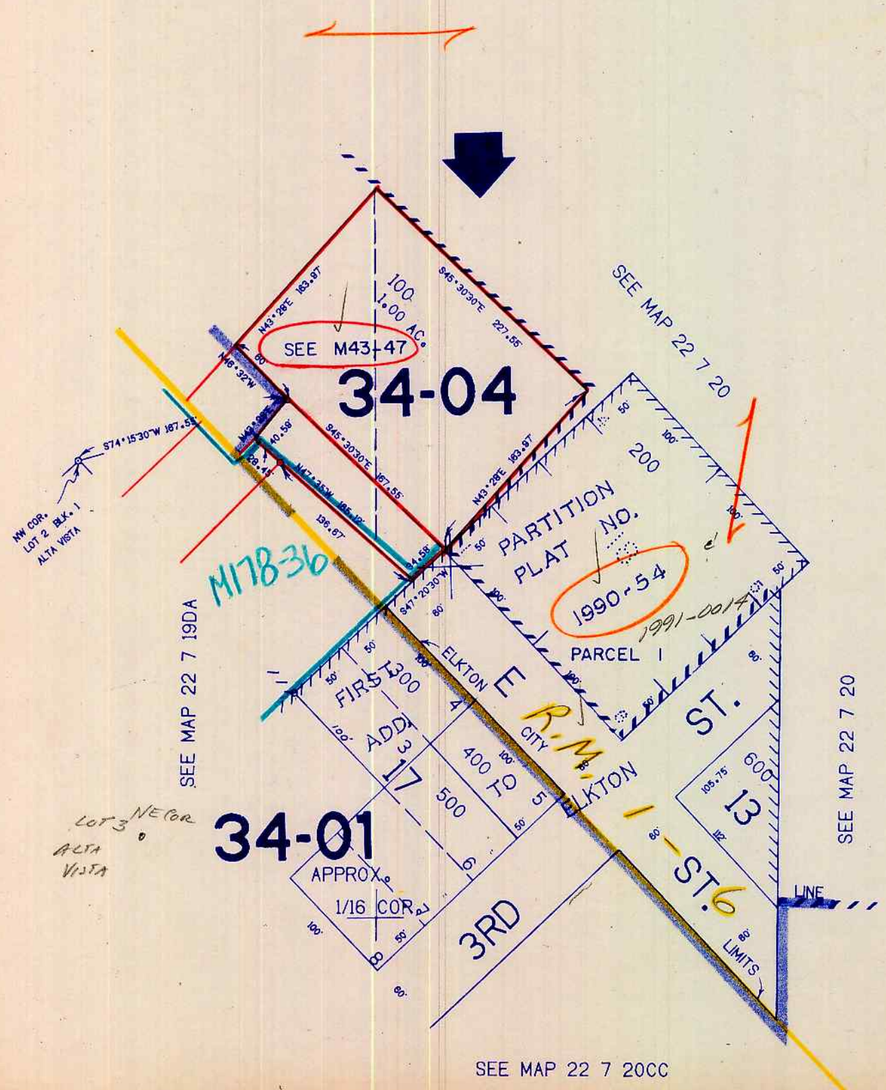

734.000

1,190.000

APPROX.
1/16 COR.

22 7 20CB
ELKTON