

SECTION 8 T.22S. R.8W. W.M.
DOUGLAS COUNTY

22 8 8

THIS MAP WAS PREPARED FOR
ASSESSMENT PURPOSE ONLY.

1"=400'

SEE MAP 22 8 5

34-02

34-04

34-02

M 130-77


M 126-32



SEE MAP 22 8 7

SEE MAP 22 8 17

SEE MAP 22 8 9

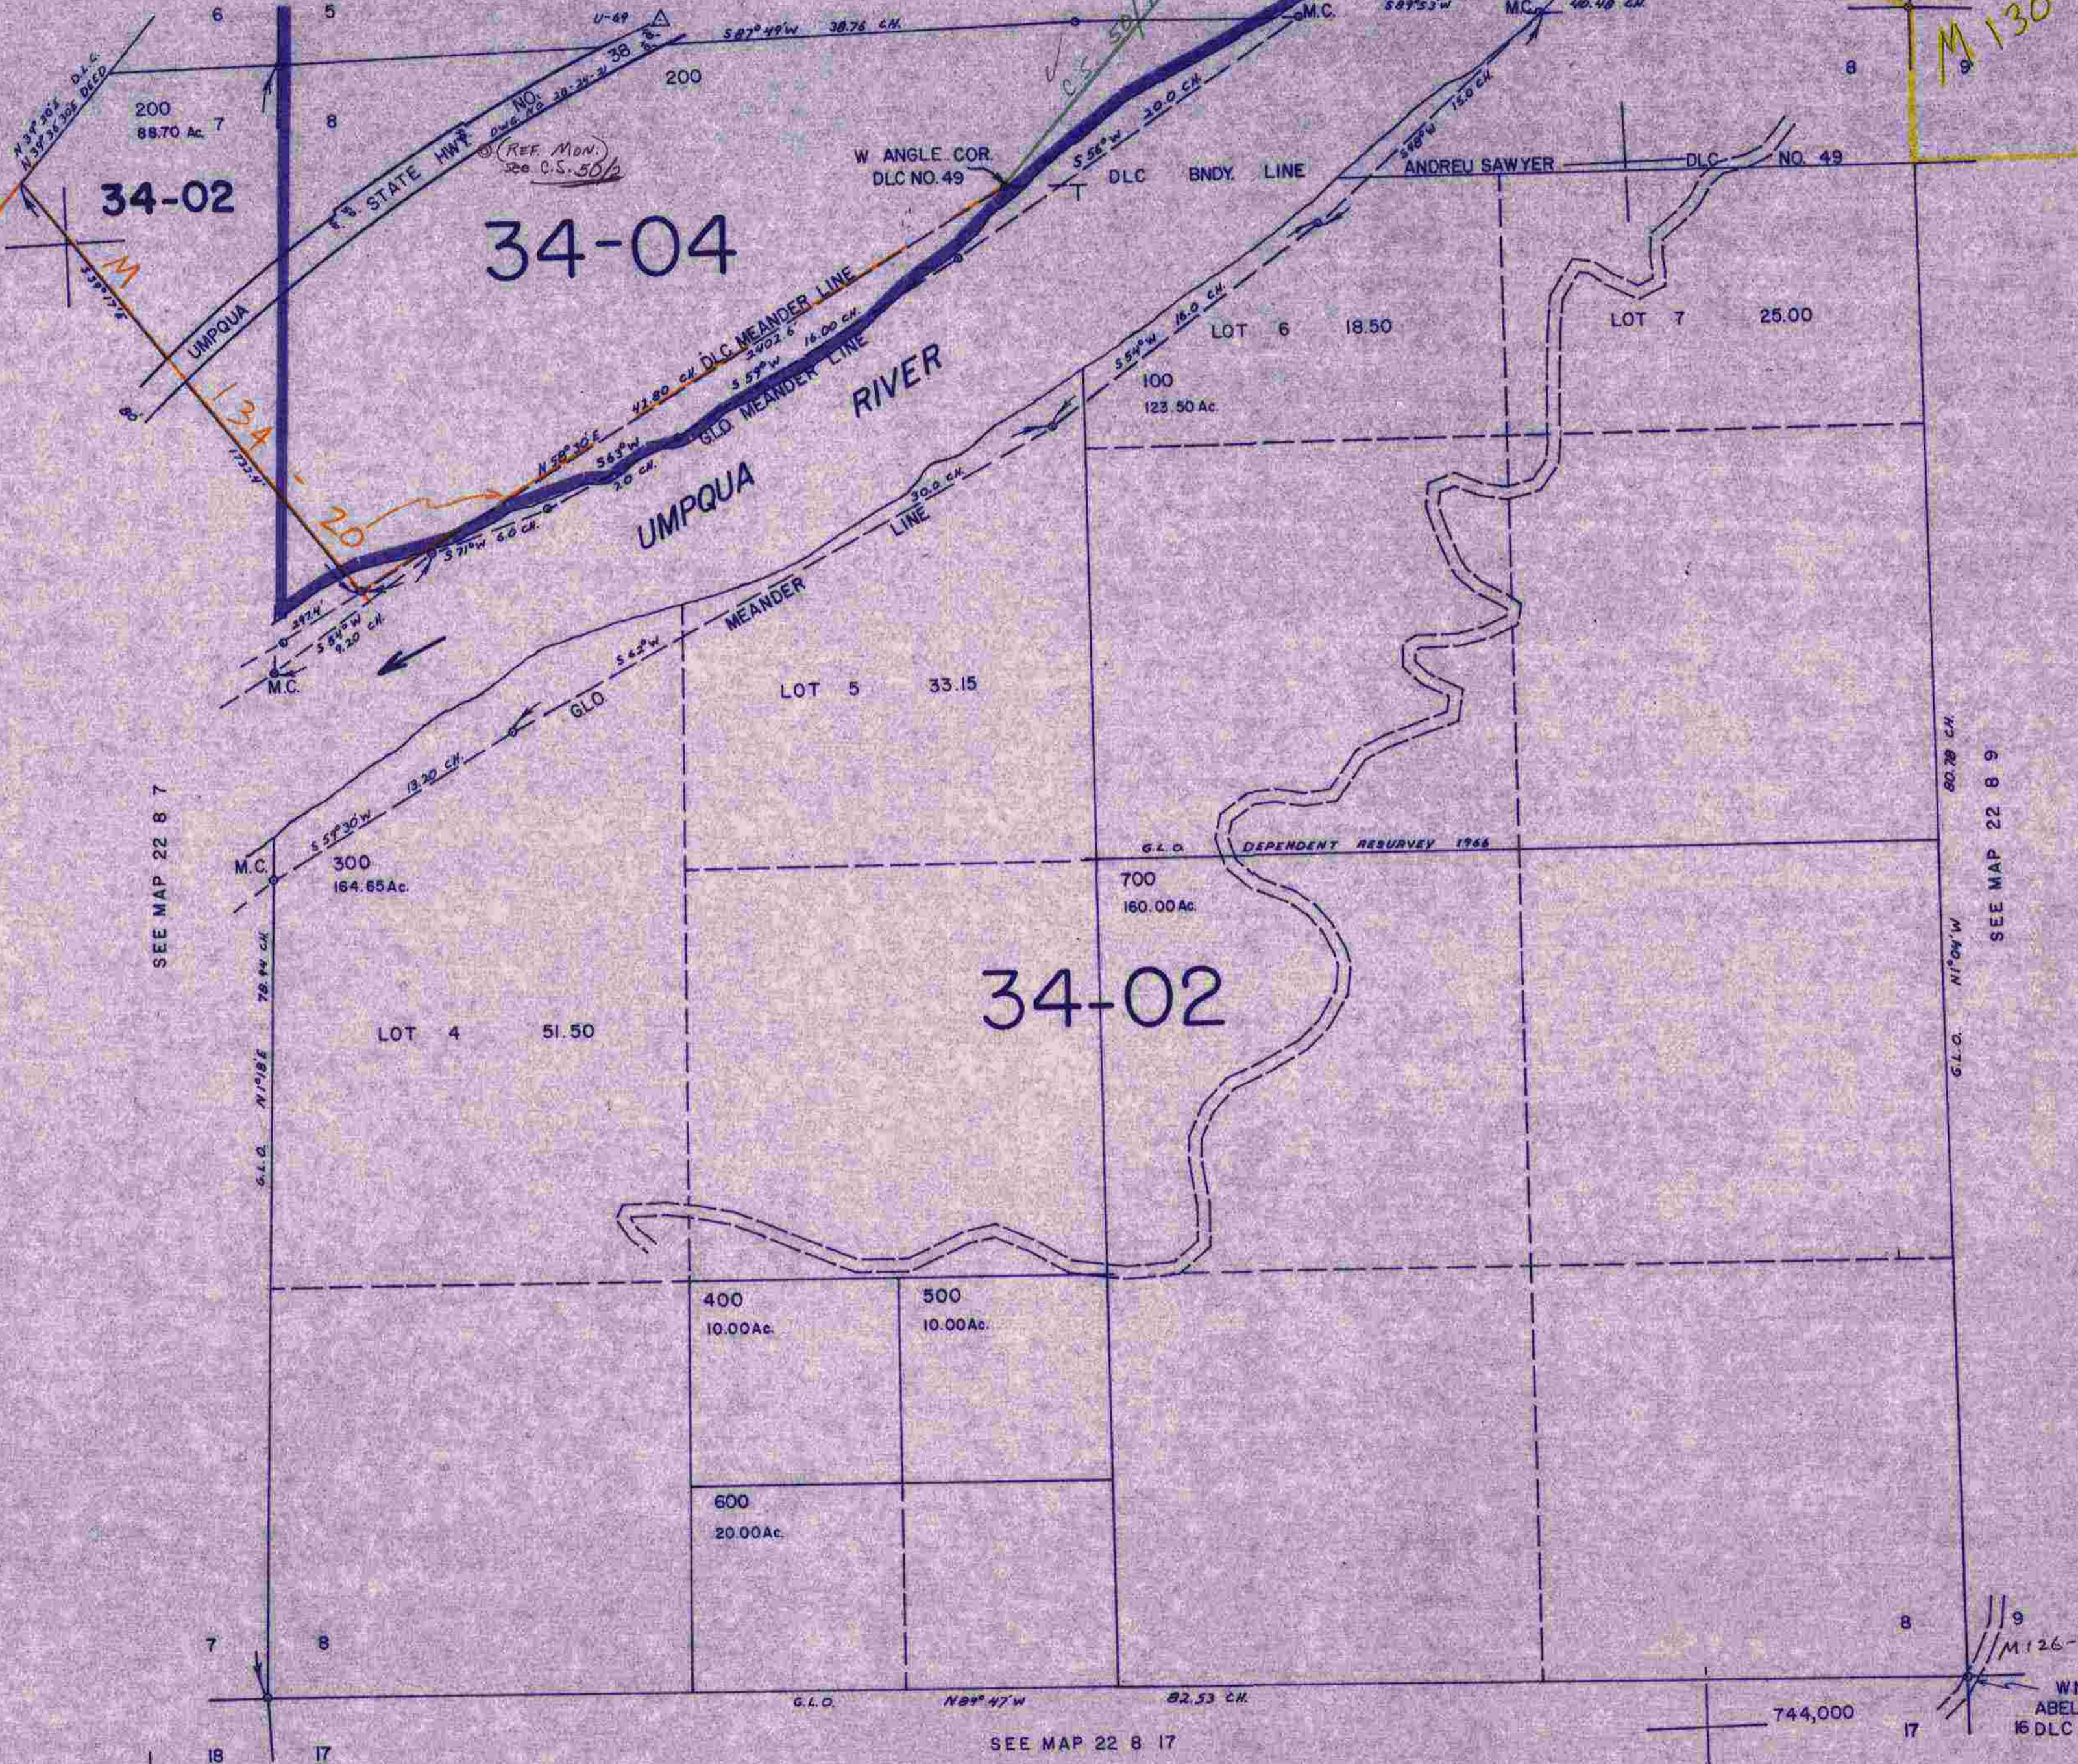

200
88.70 Ac

123.50 Ac

300
164.65 Ac

400
10.00 Ac

500
10.00 Ac

600
20.00 Ac

700
160.00 Ac




