THIS MAP WAS PREPARED FOR ASSESSMENT PURPOSE ONLY.

# SECTION 11 T.22S. R.8W. W.M.
## DOUGLAS COUNTY
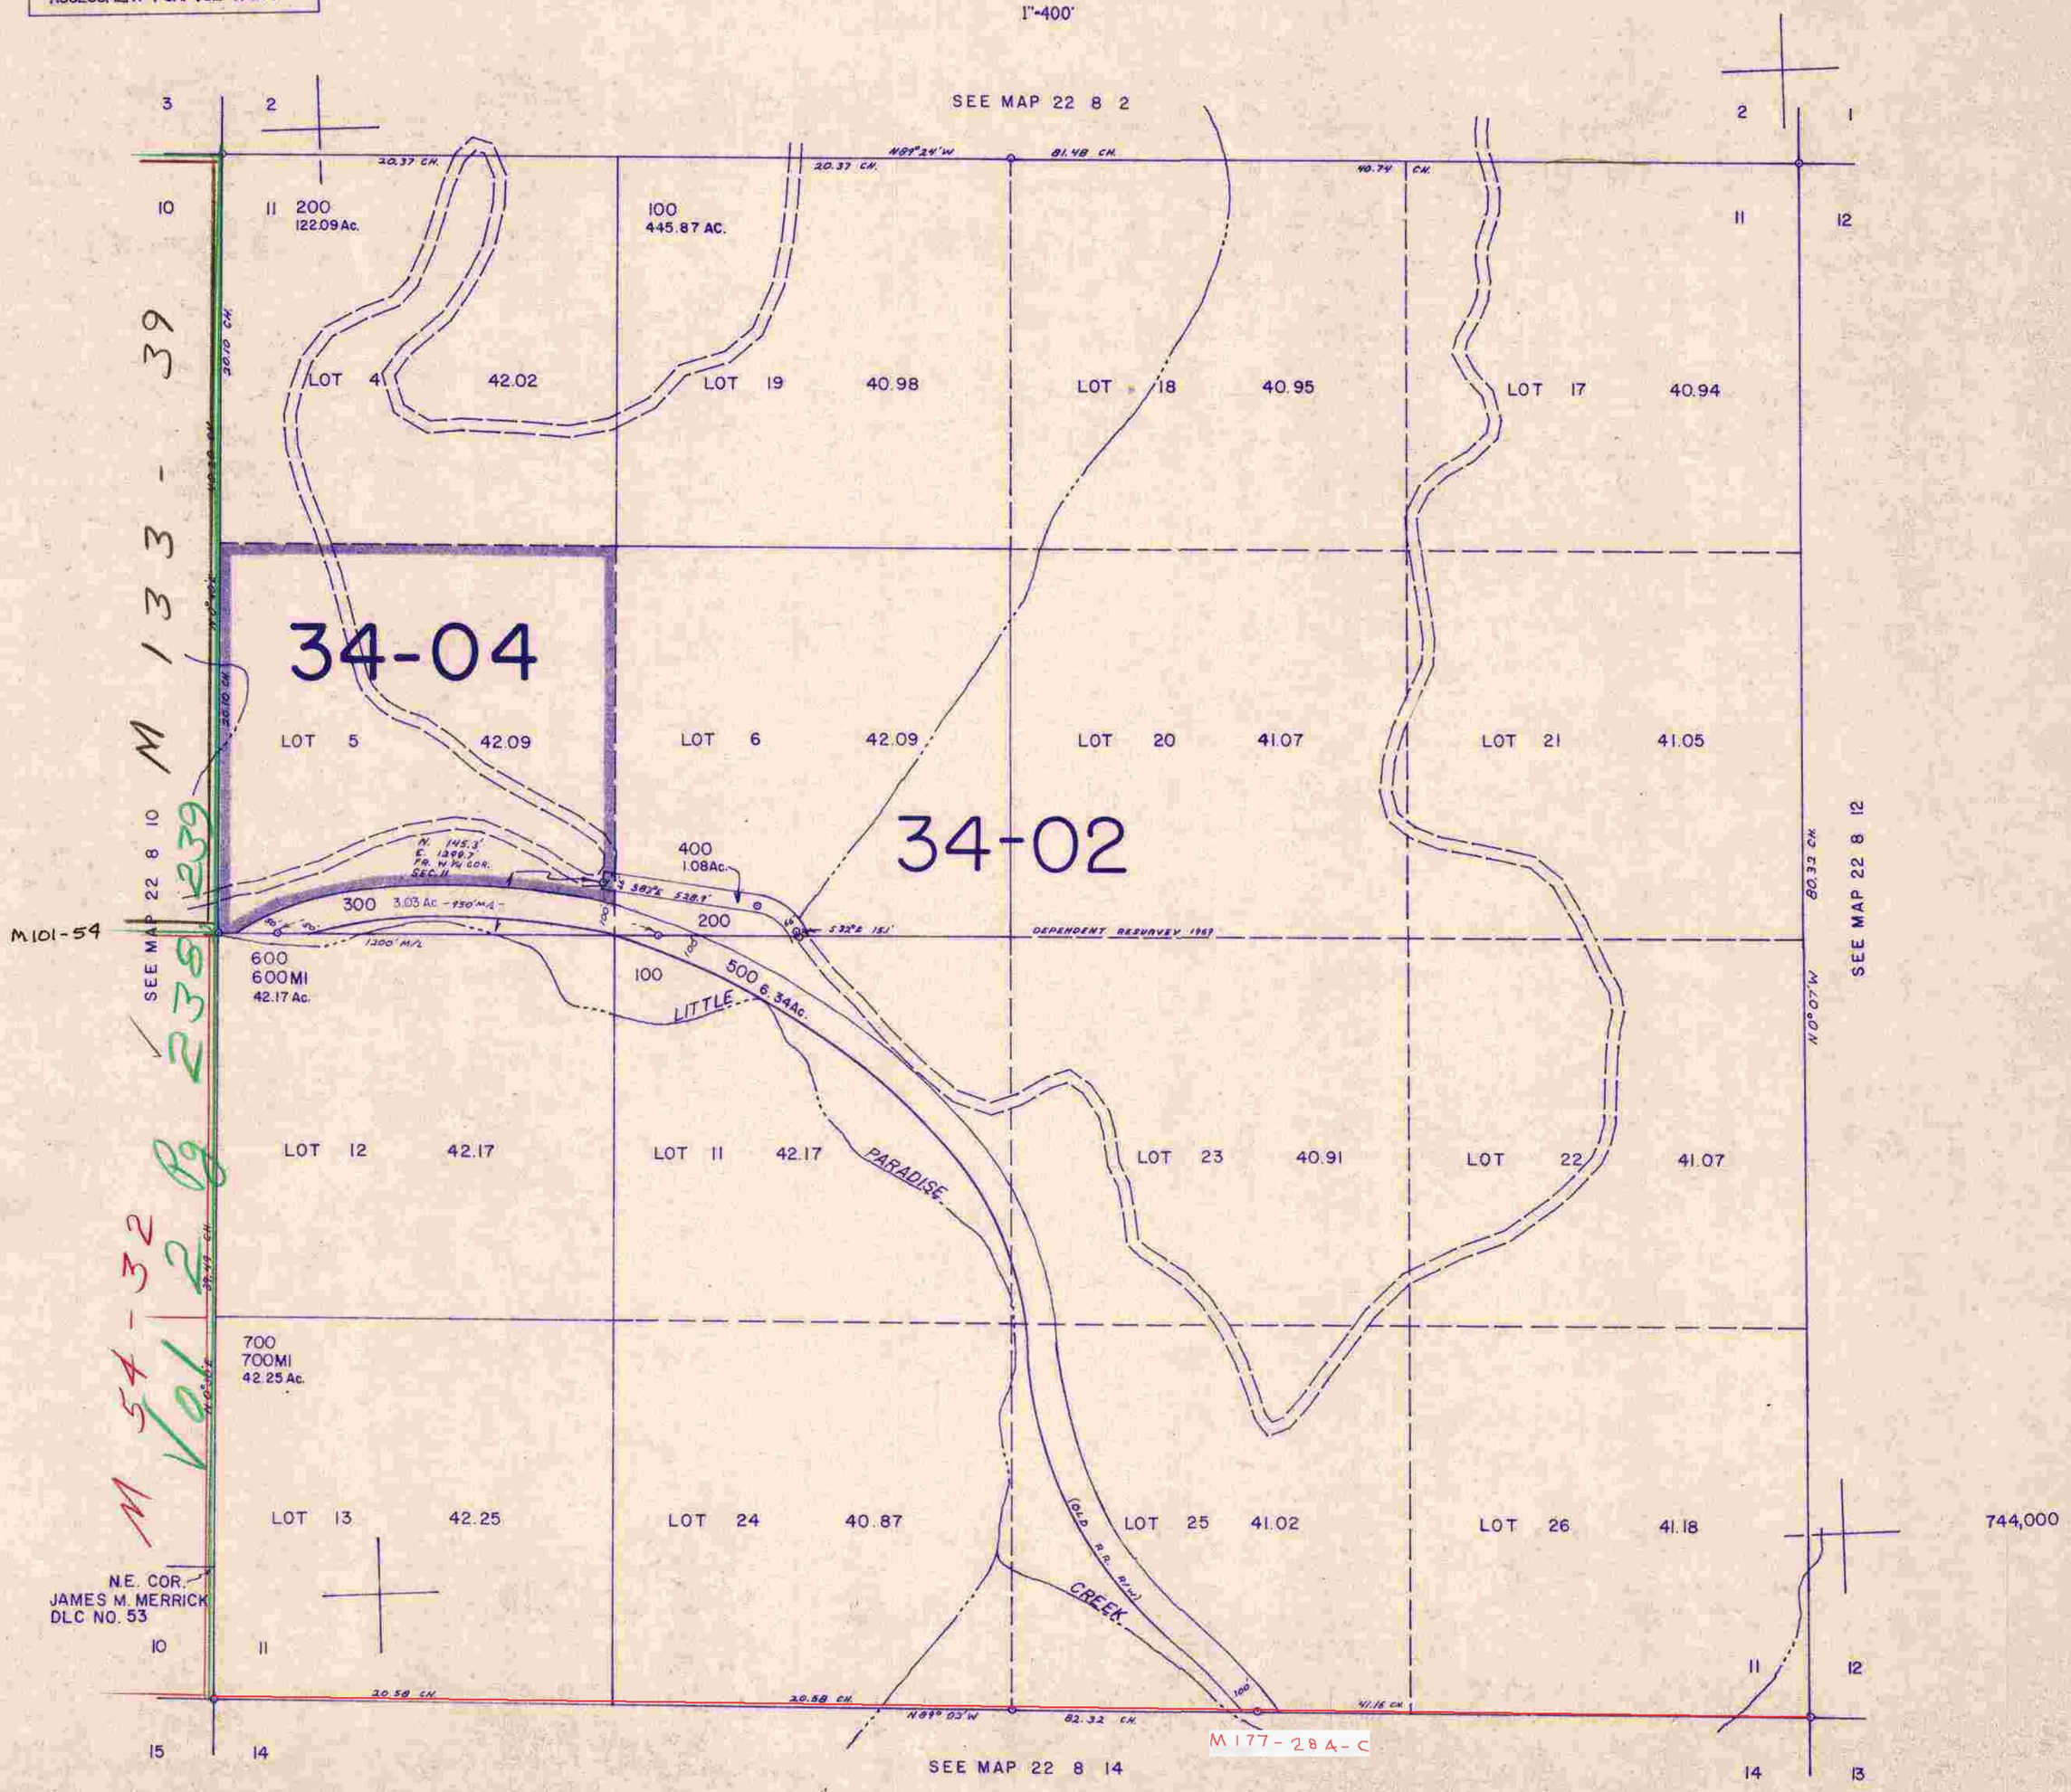
1"=400'