SECTION 12 T.22 S. R. 8 W. W.M.
DOUGLAS COUNTY
1"=400'

THIS MAP WAS PREPARED FOR ASSESSMENT PURPOSE ONLY.

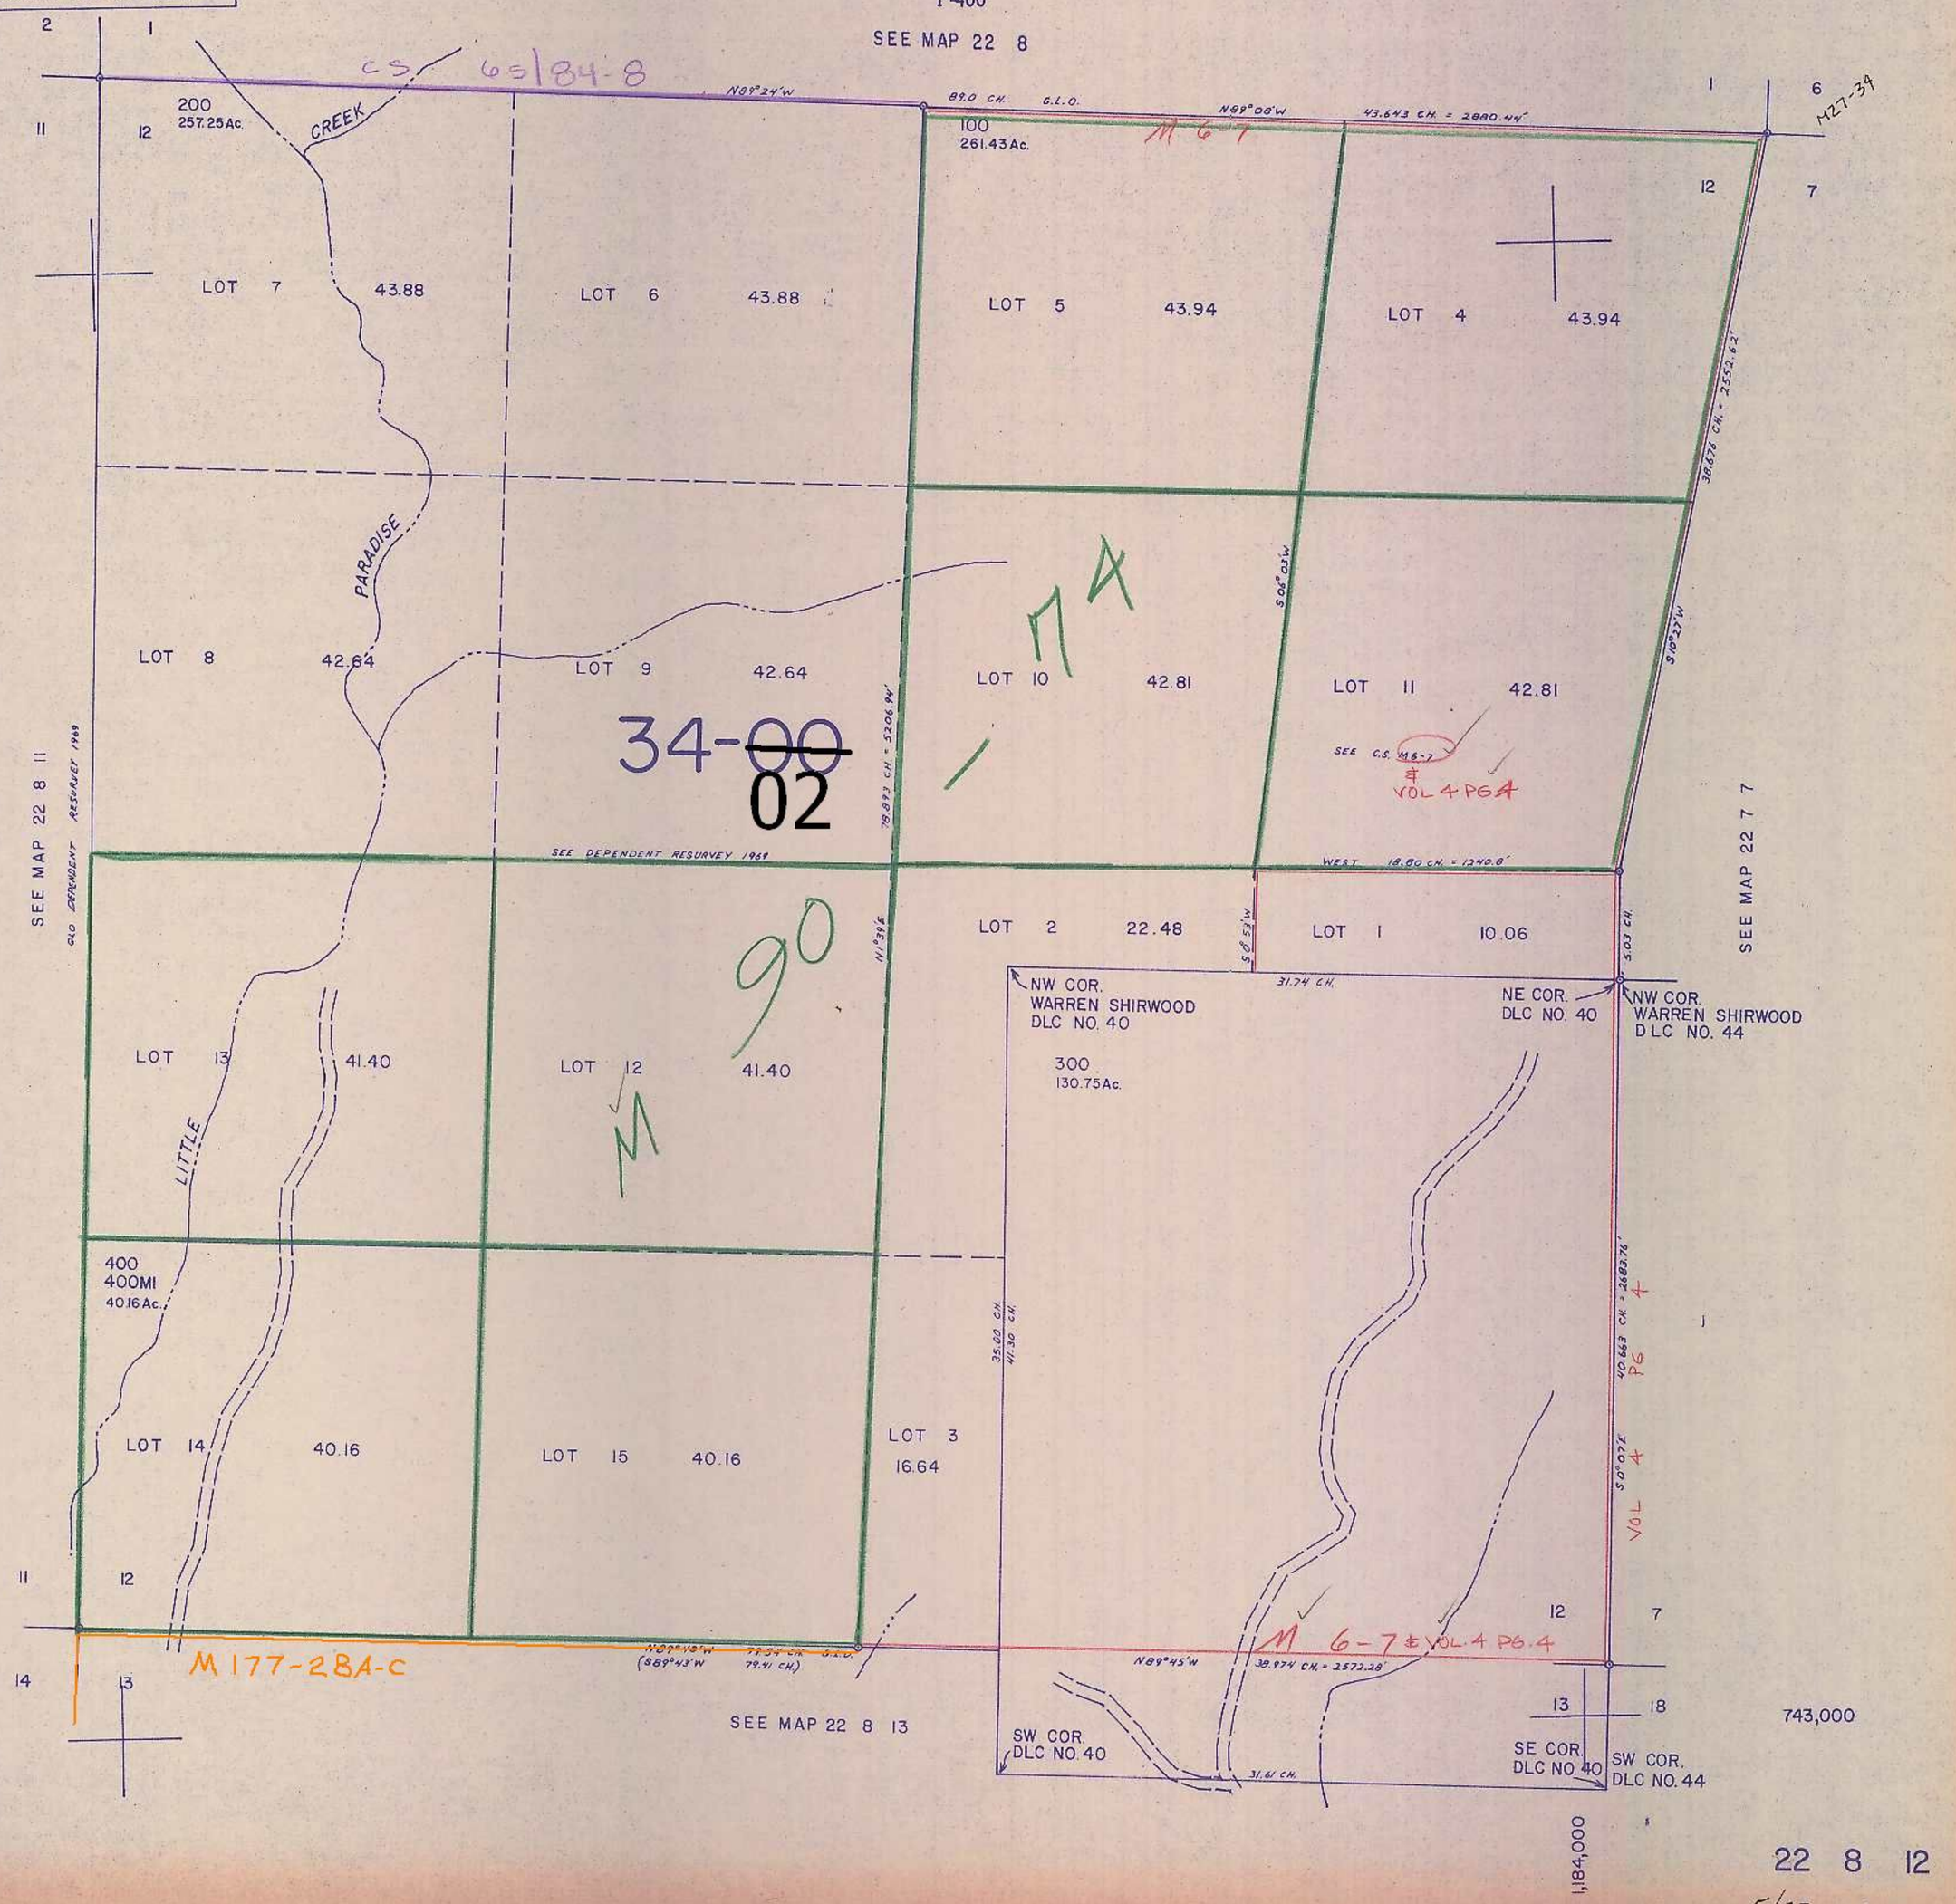

5/83 BS