THIS MAP WAS PREPARED FOR ASSESSMENT PURPOSE ONLY.

NW1/4 NE1/4 SEC.23 T.22S. R.8W. W.M.
DOUGLAS COUNTY

1" =100'

REVISED ON 6-21-13

22 8 23AB

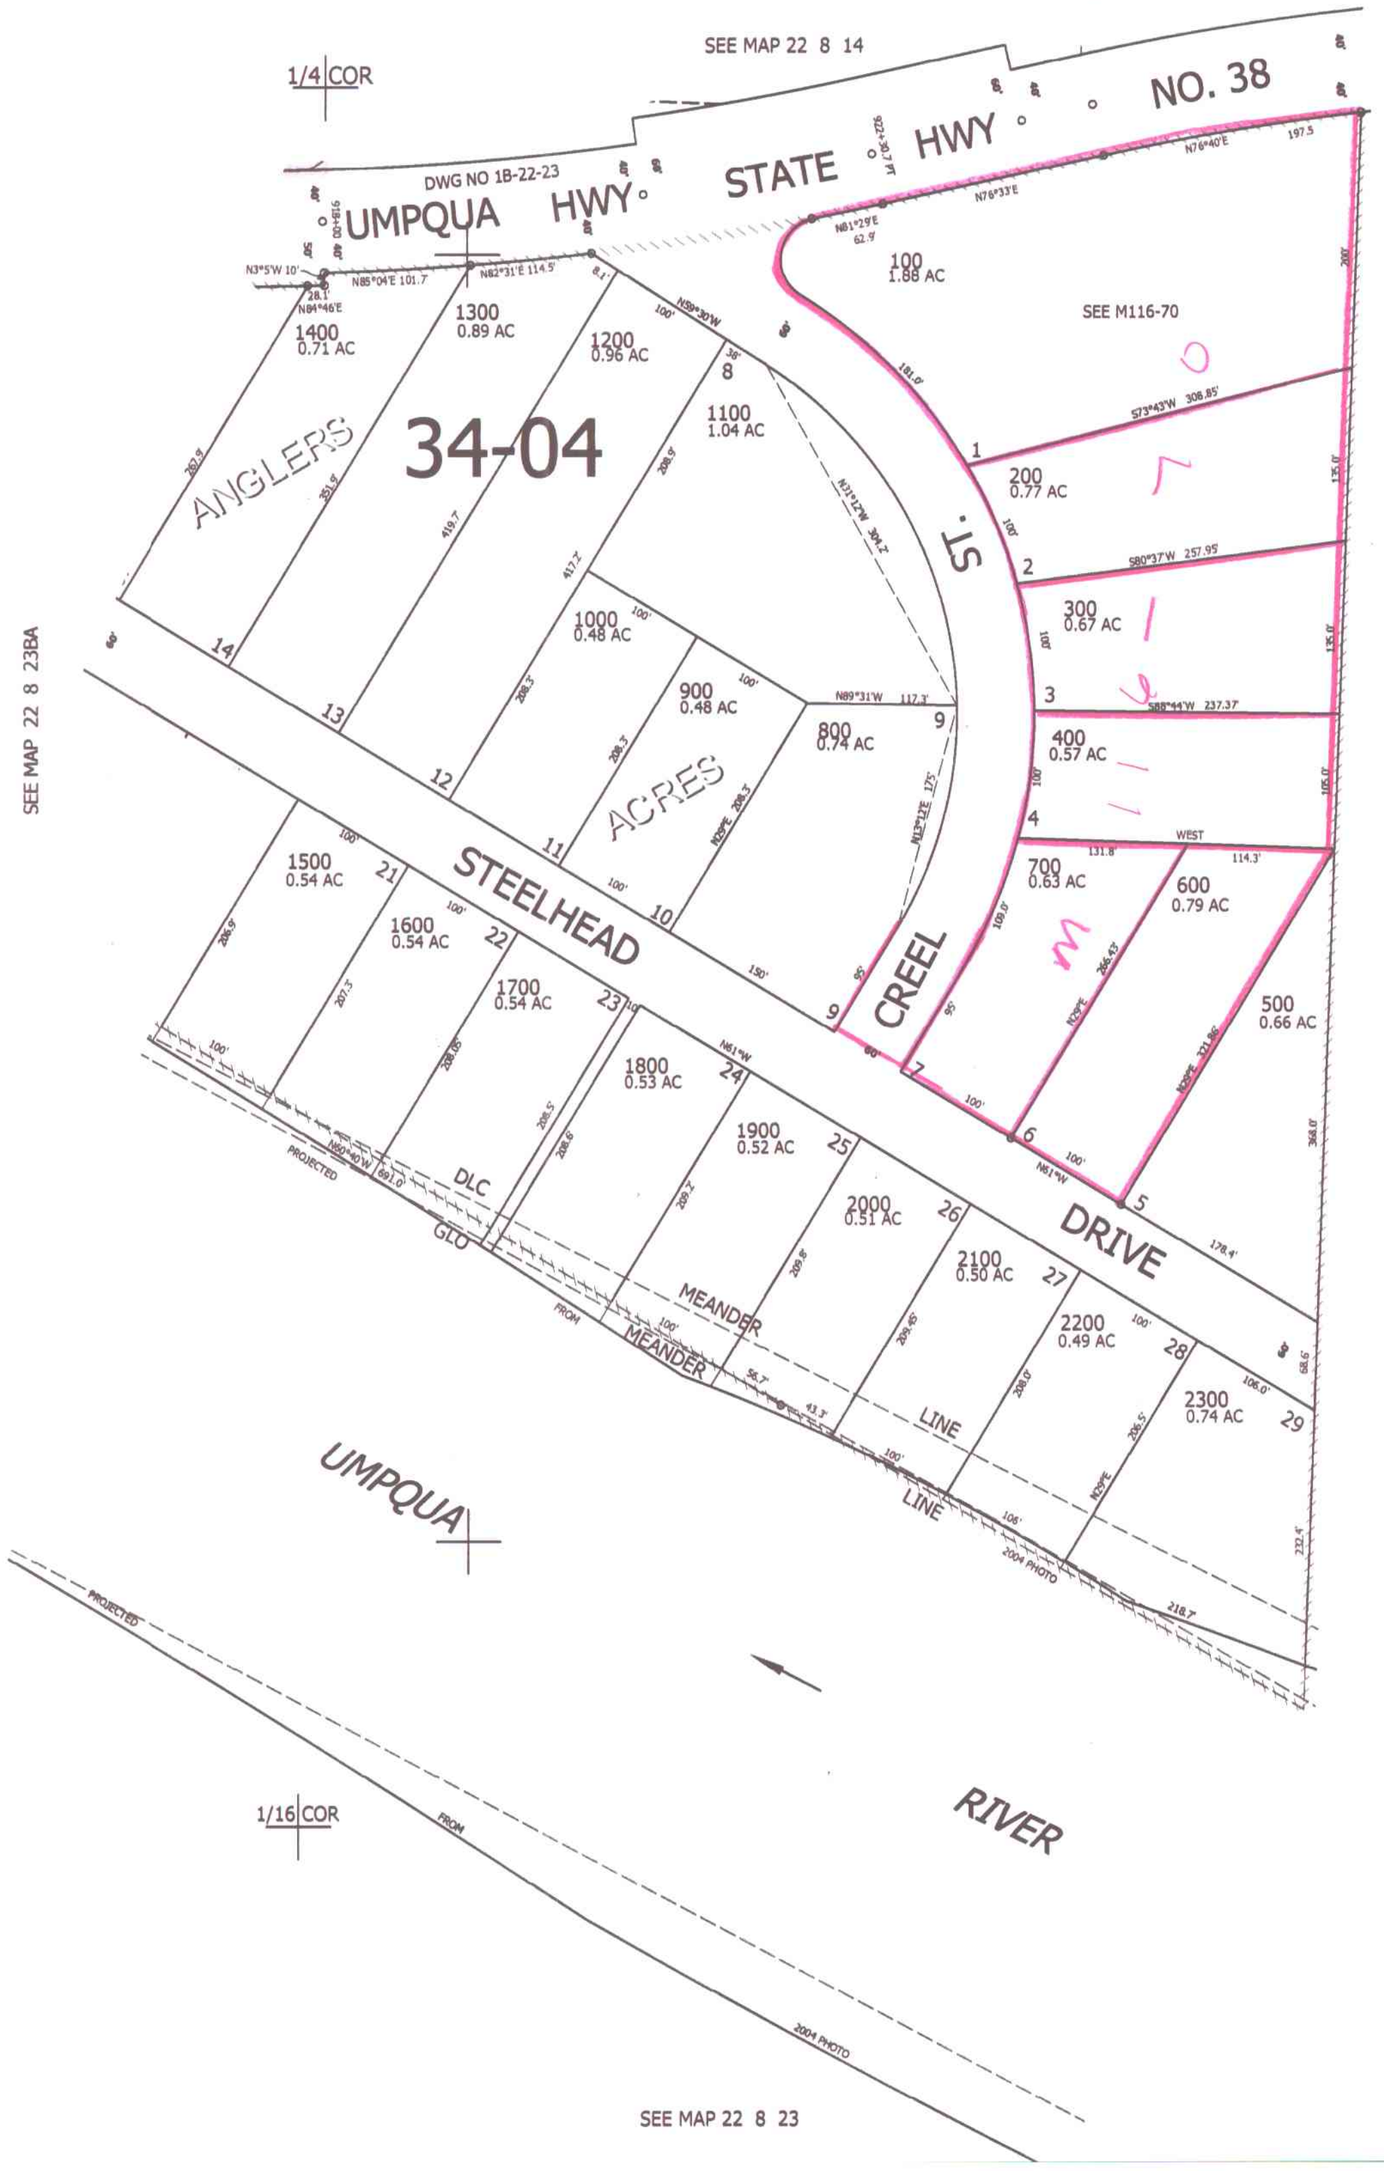

22 8 23AB