THIS MAP WAS PREPARED FOR ASSESSMENT PURPOSE ONLY.

SEC.35 T.22S. R.8W. W.M.
DOUGLAS COUNTY

1" =400'

REVISED ON 11-7-18

22 8 35

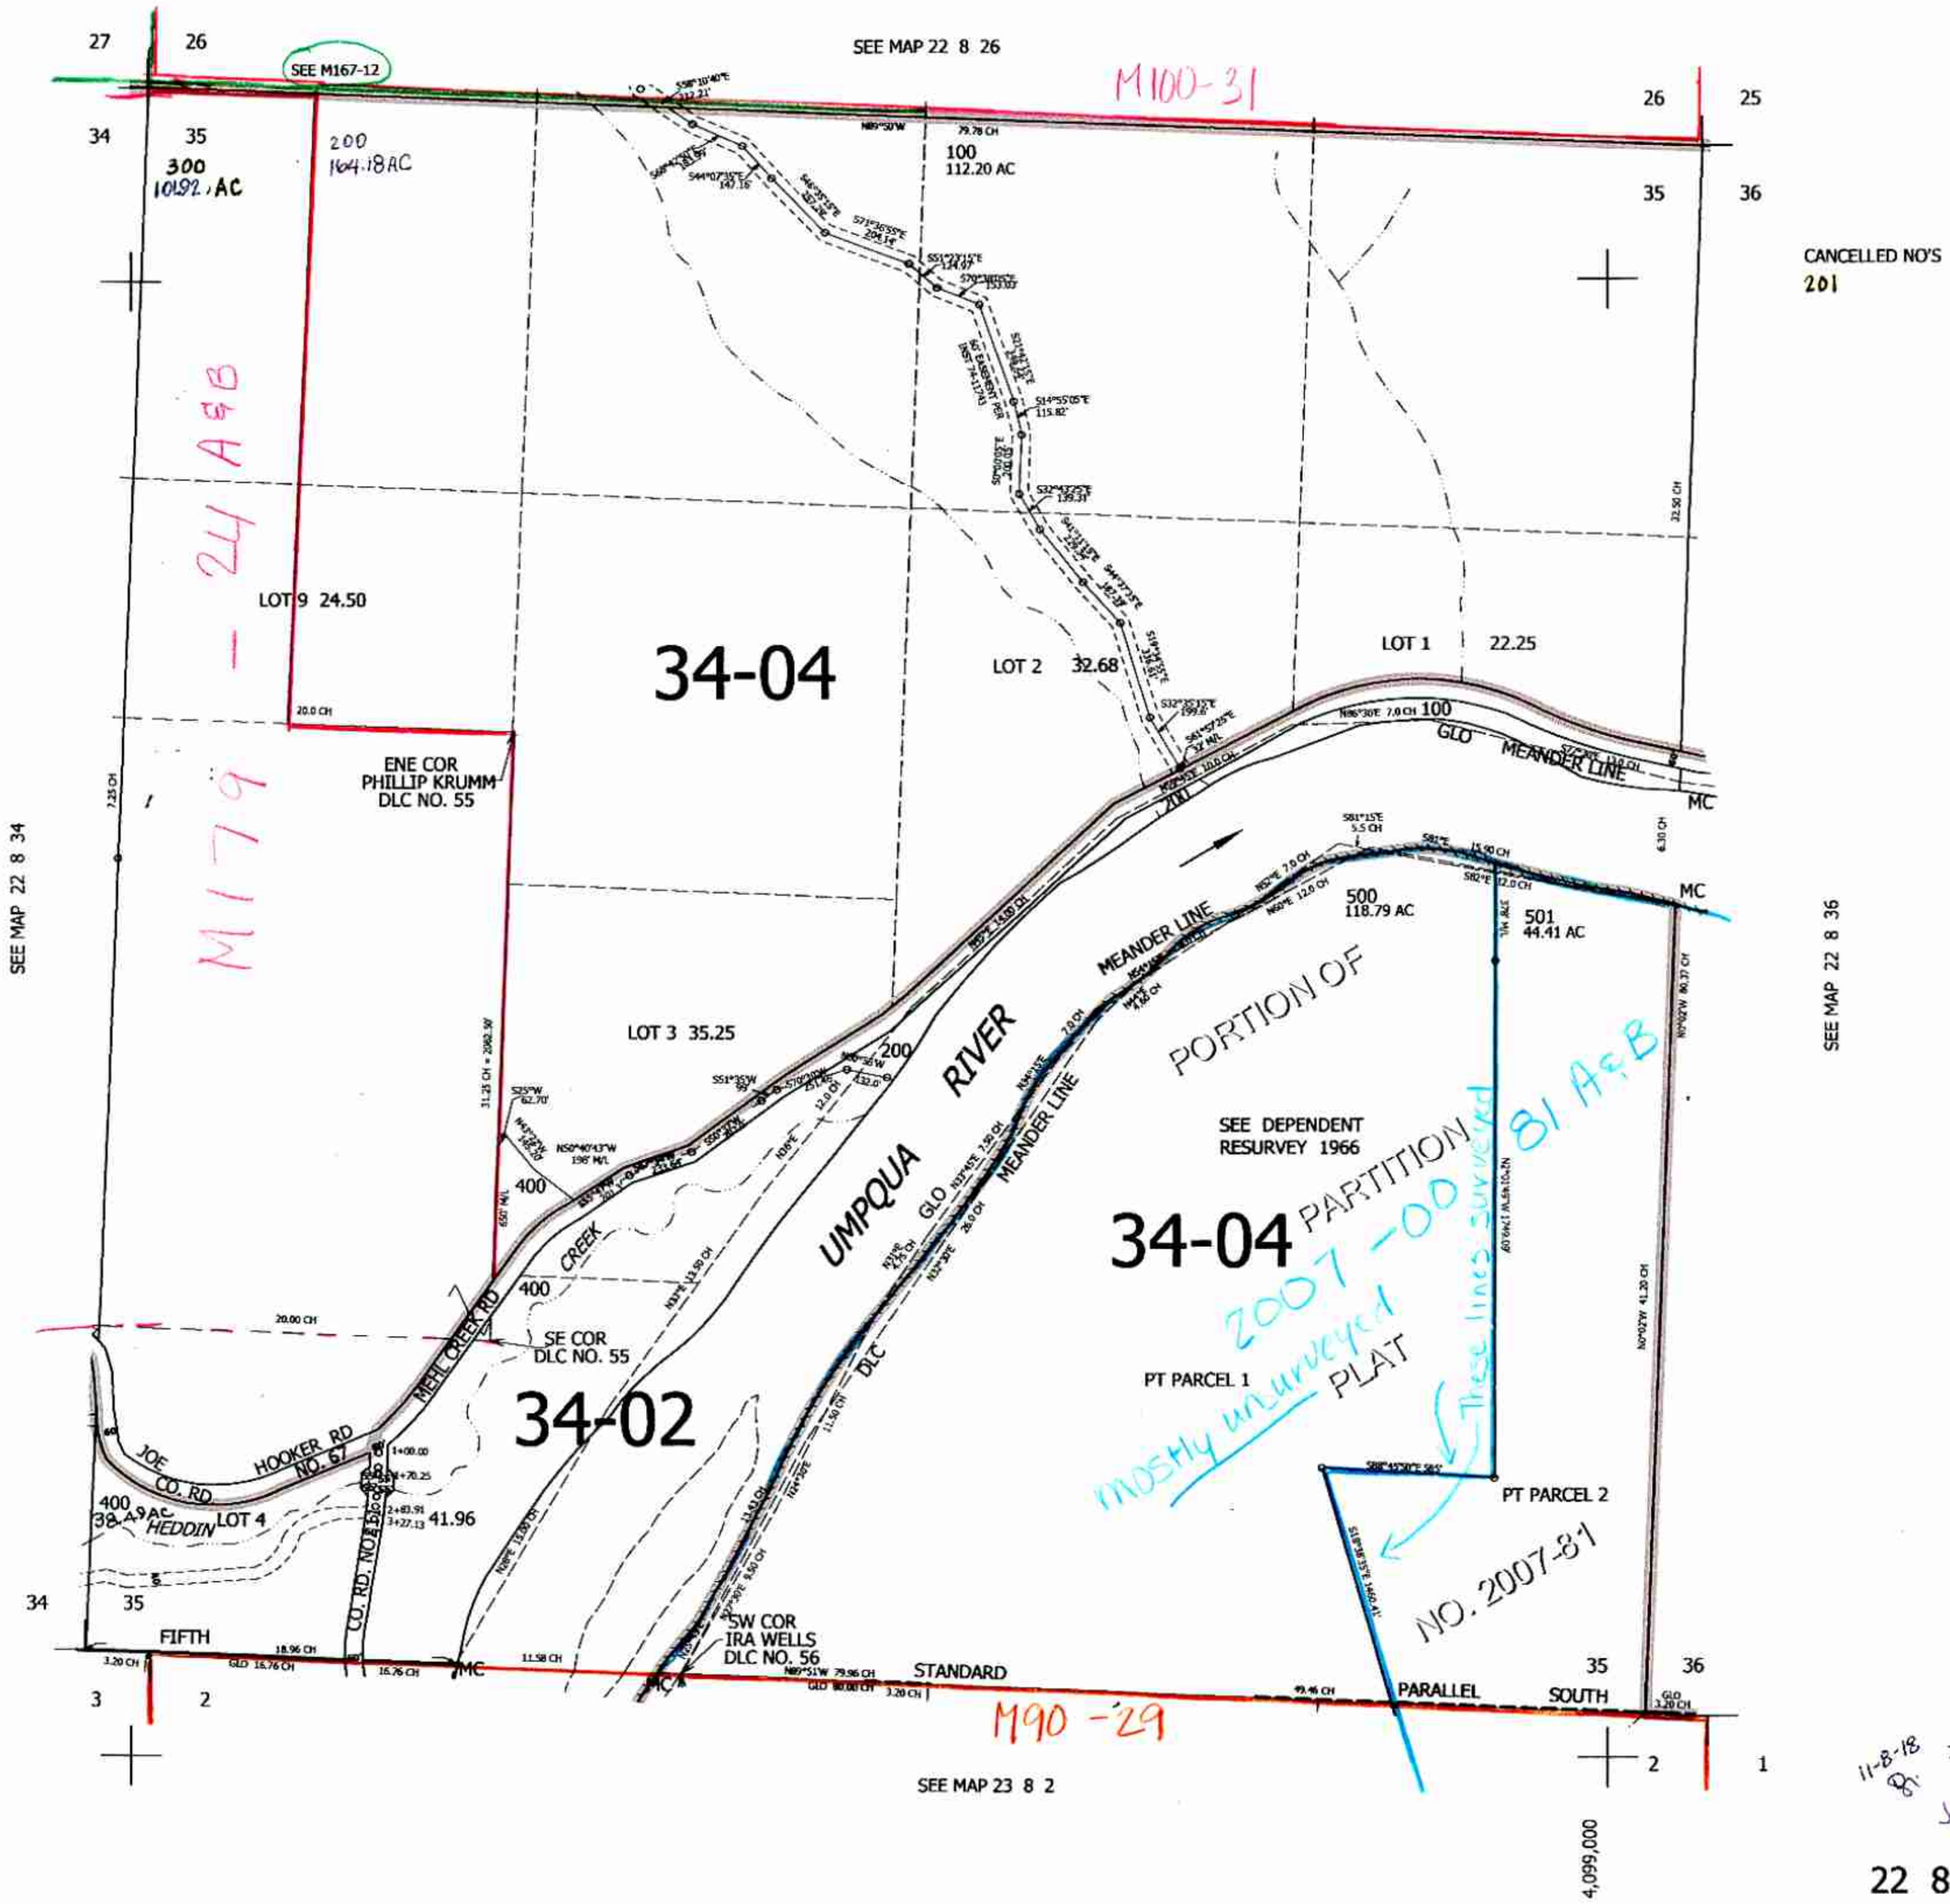

22 8 35