


SECTION 36 T.22S. R.8W. W.M.
DOUGLAS COUNTY

22 8 36

THIS MAP WAS PREPARED FOR
ASSESSMENT PURPOSE ONLY.

1"=400'

SEE MAP 22 8 25

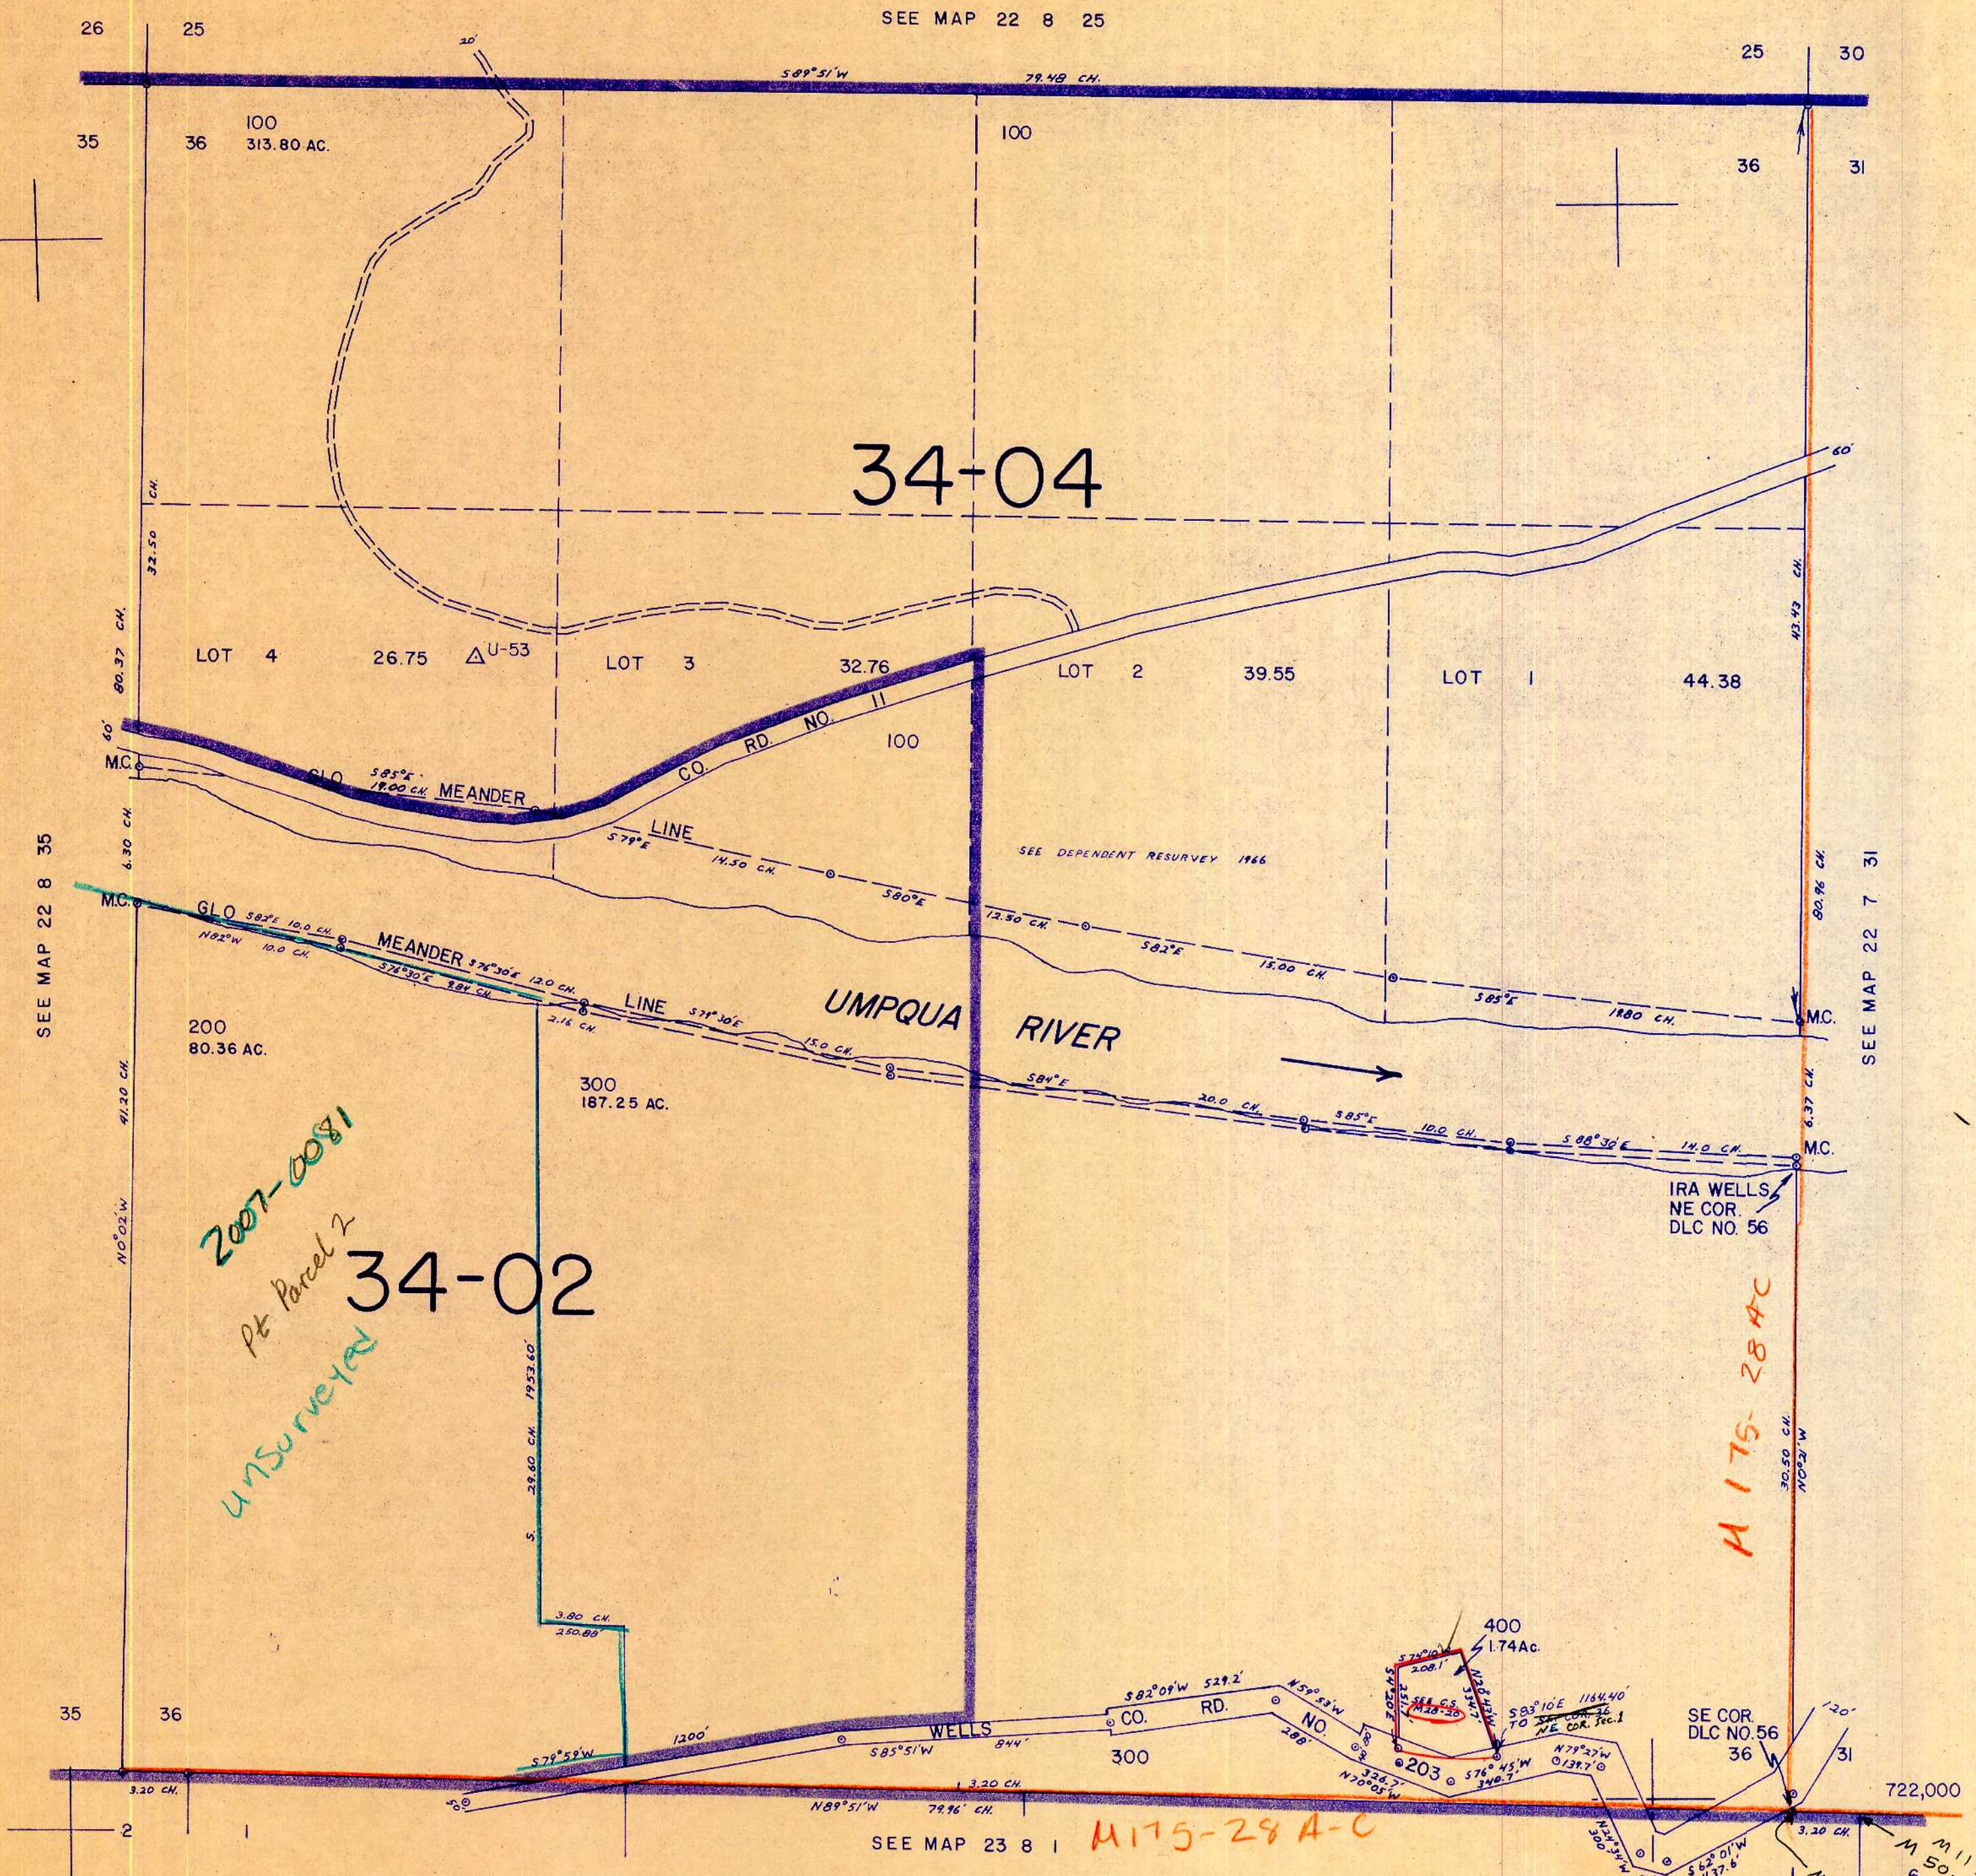

34-04

34-02

*2007-0081
Pt Parcel 2
Unsurveyed*

M 175-28 AC

M 175-28 A-C

IRA WELLS
NE COR.
DLC NO. 56

SE COR
DLC NO. 56

22 8 36

7/83 *bd*

SEE MAP 22 8 35

SEE MAP 22 7 31

SEE MAP 23 8 1

1,183,000

*M 119-80
M 50-38
M 50-38
M 119-80*