


THIS MAP WAS PREPARED FOR
ASSESSMENT PURPOSE ONLY.

SECTION 7 T.22S. R.10W. W.M.
DOUGLAS COUNTY
1" = 400'

22 10 7
& INDEX

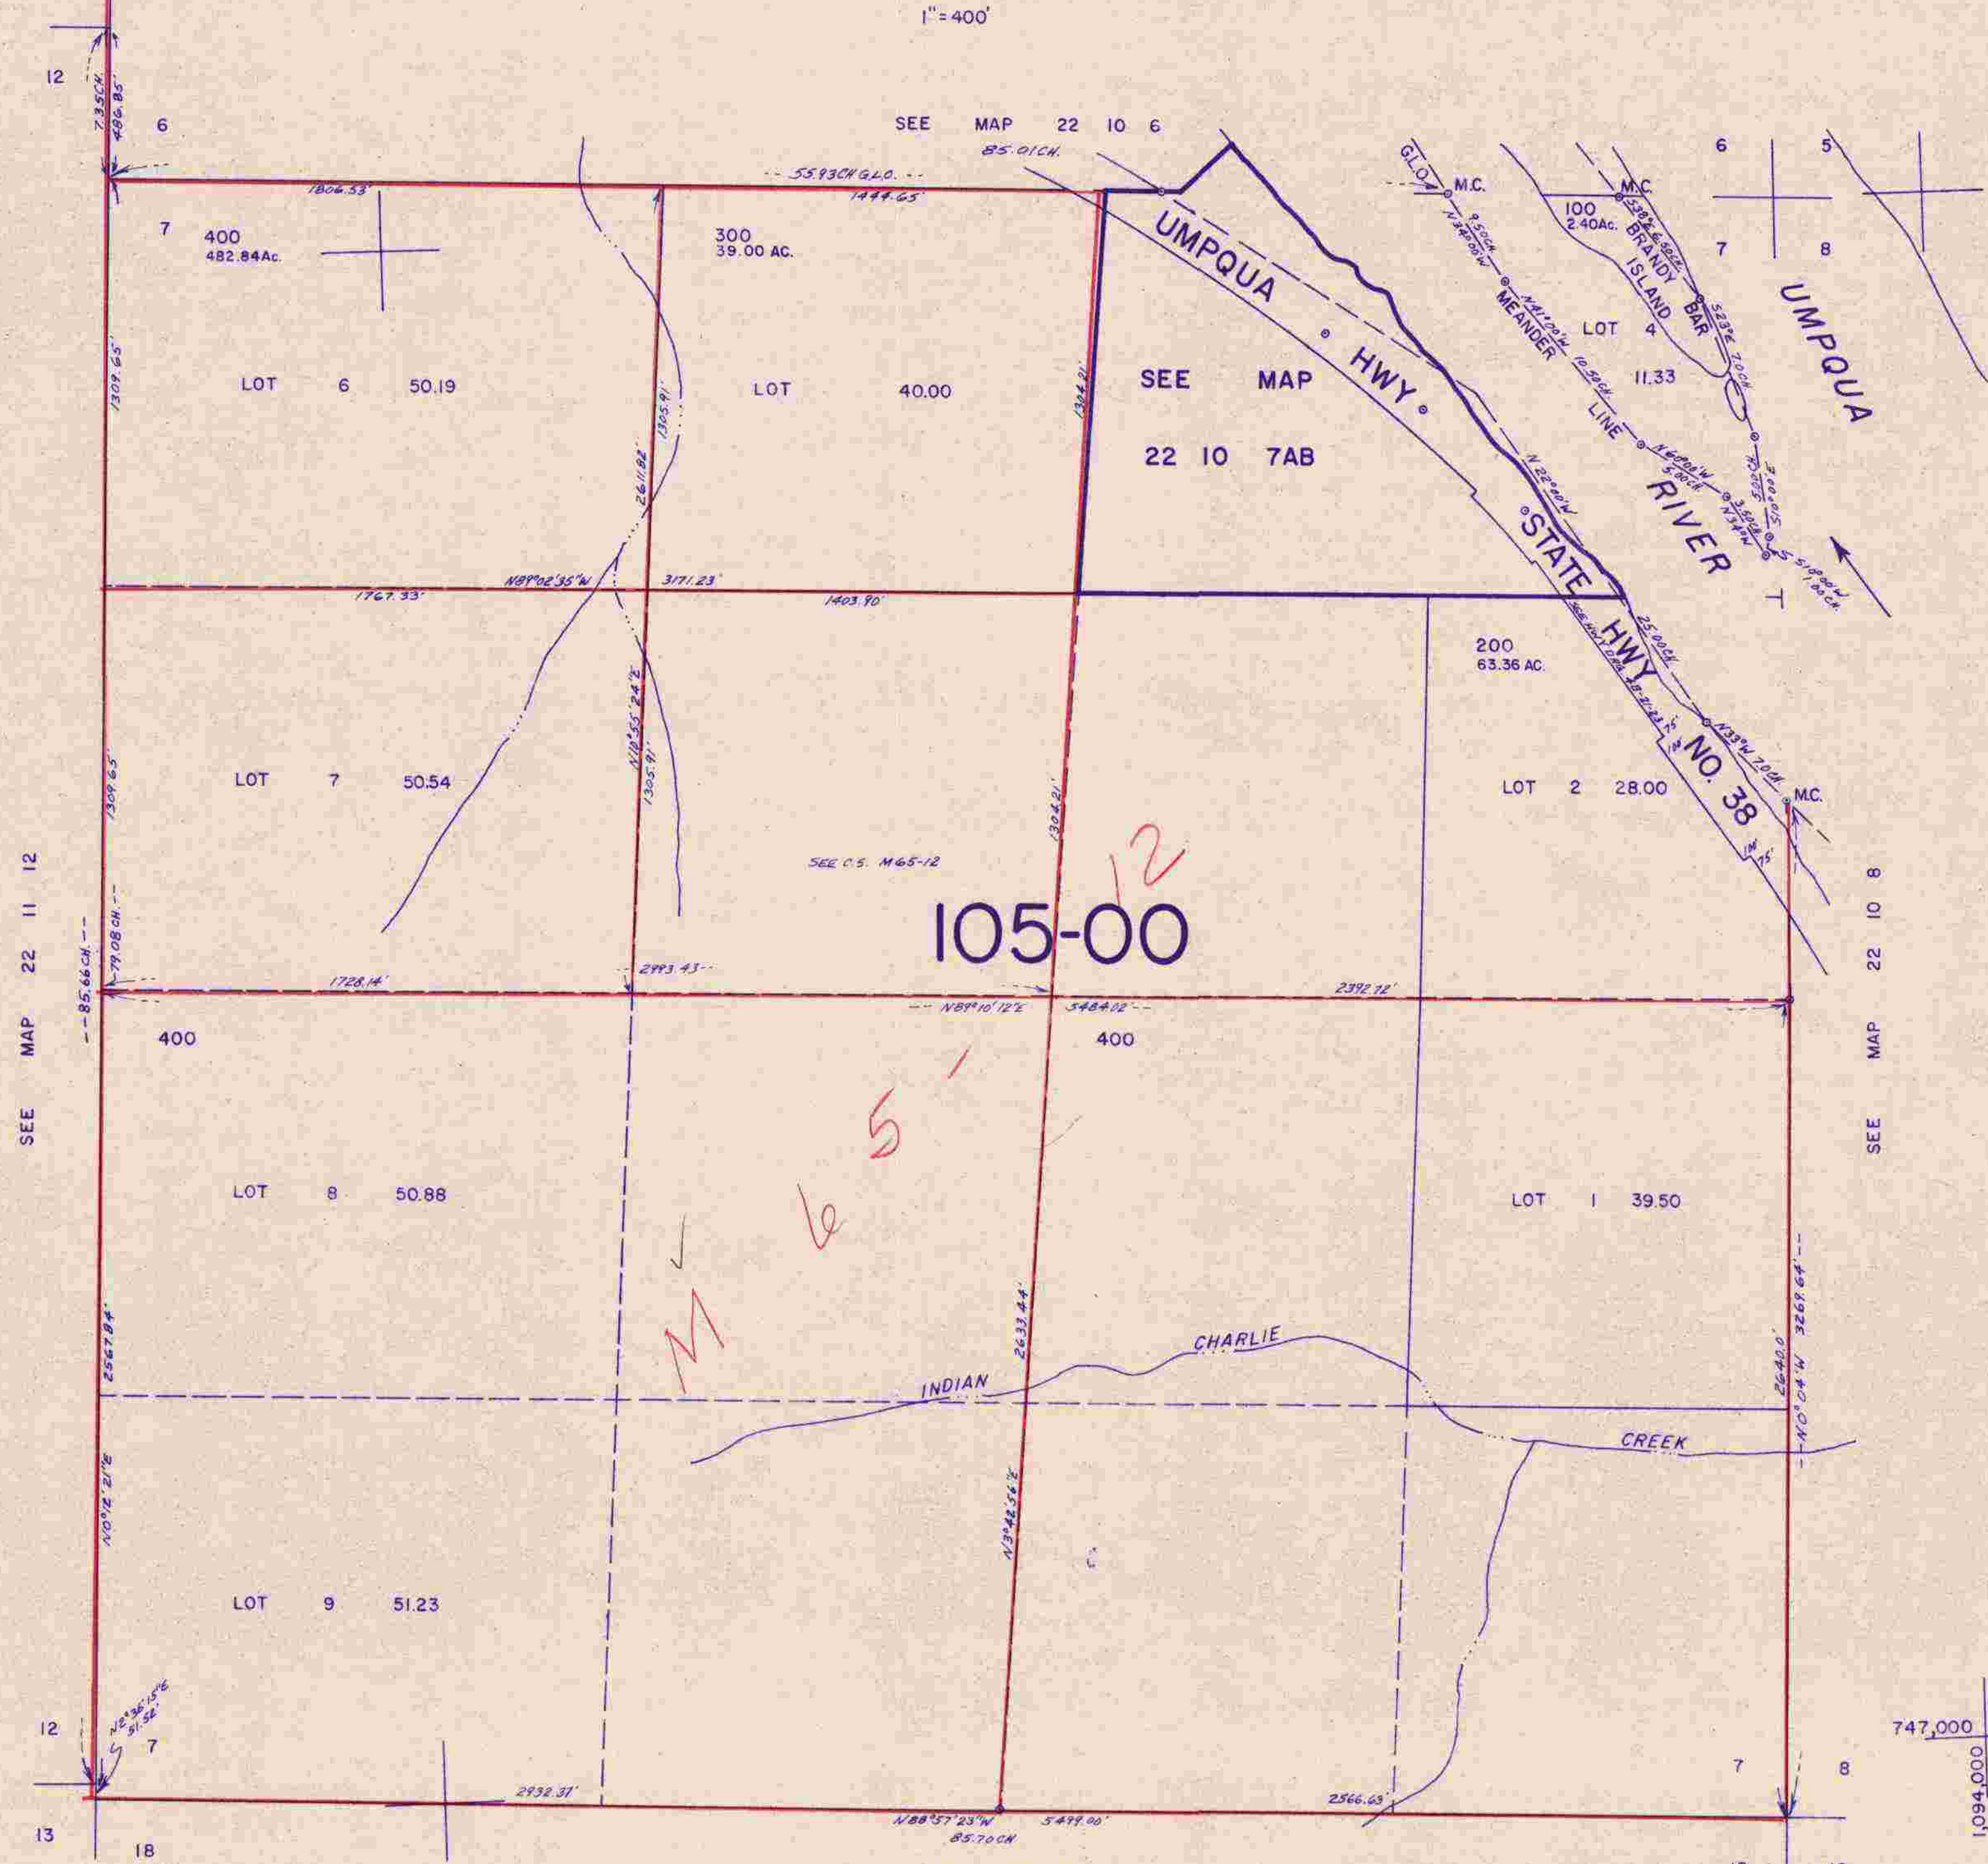

105-00

M b S

INDIAN

CHARLIE

CREEK

SEE MAP
22 10 7AB

SEE MAP 22 11 12

SEE MAP 22 10 8

SEE MAP 22 10

22 10 7
& INDEX

3/83
2/8