THIS MAP WAS PREPARED FOR ASSESSMENT PURPOSE ONLY

NW1/4 NW1/4 SEC. 24 T.22S. R.10W W.M.
DOUGLAS COUNTY

REVISED ON 10-6-99

22 10 24BB

1" = 100'

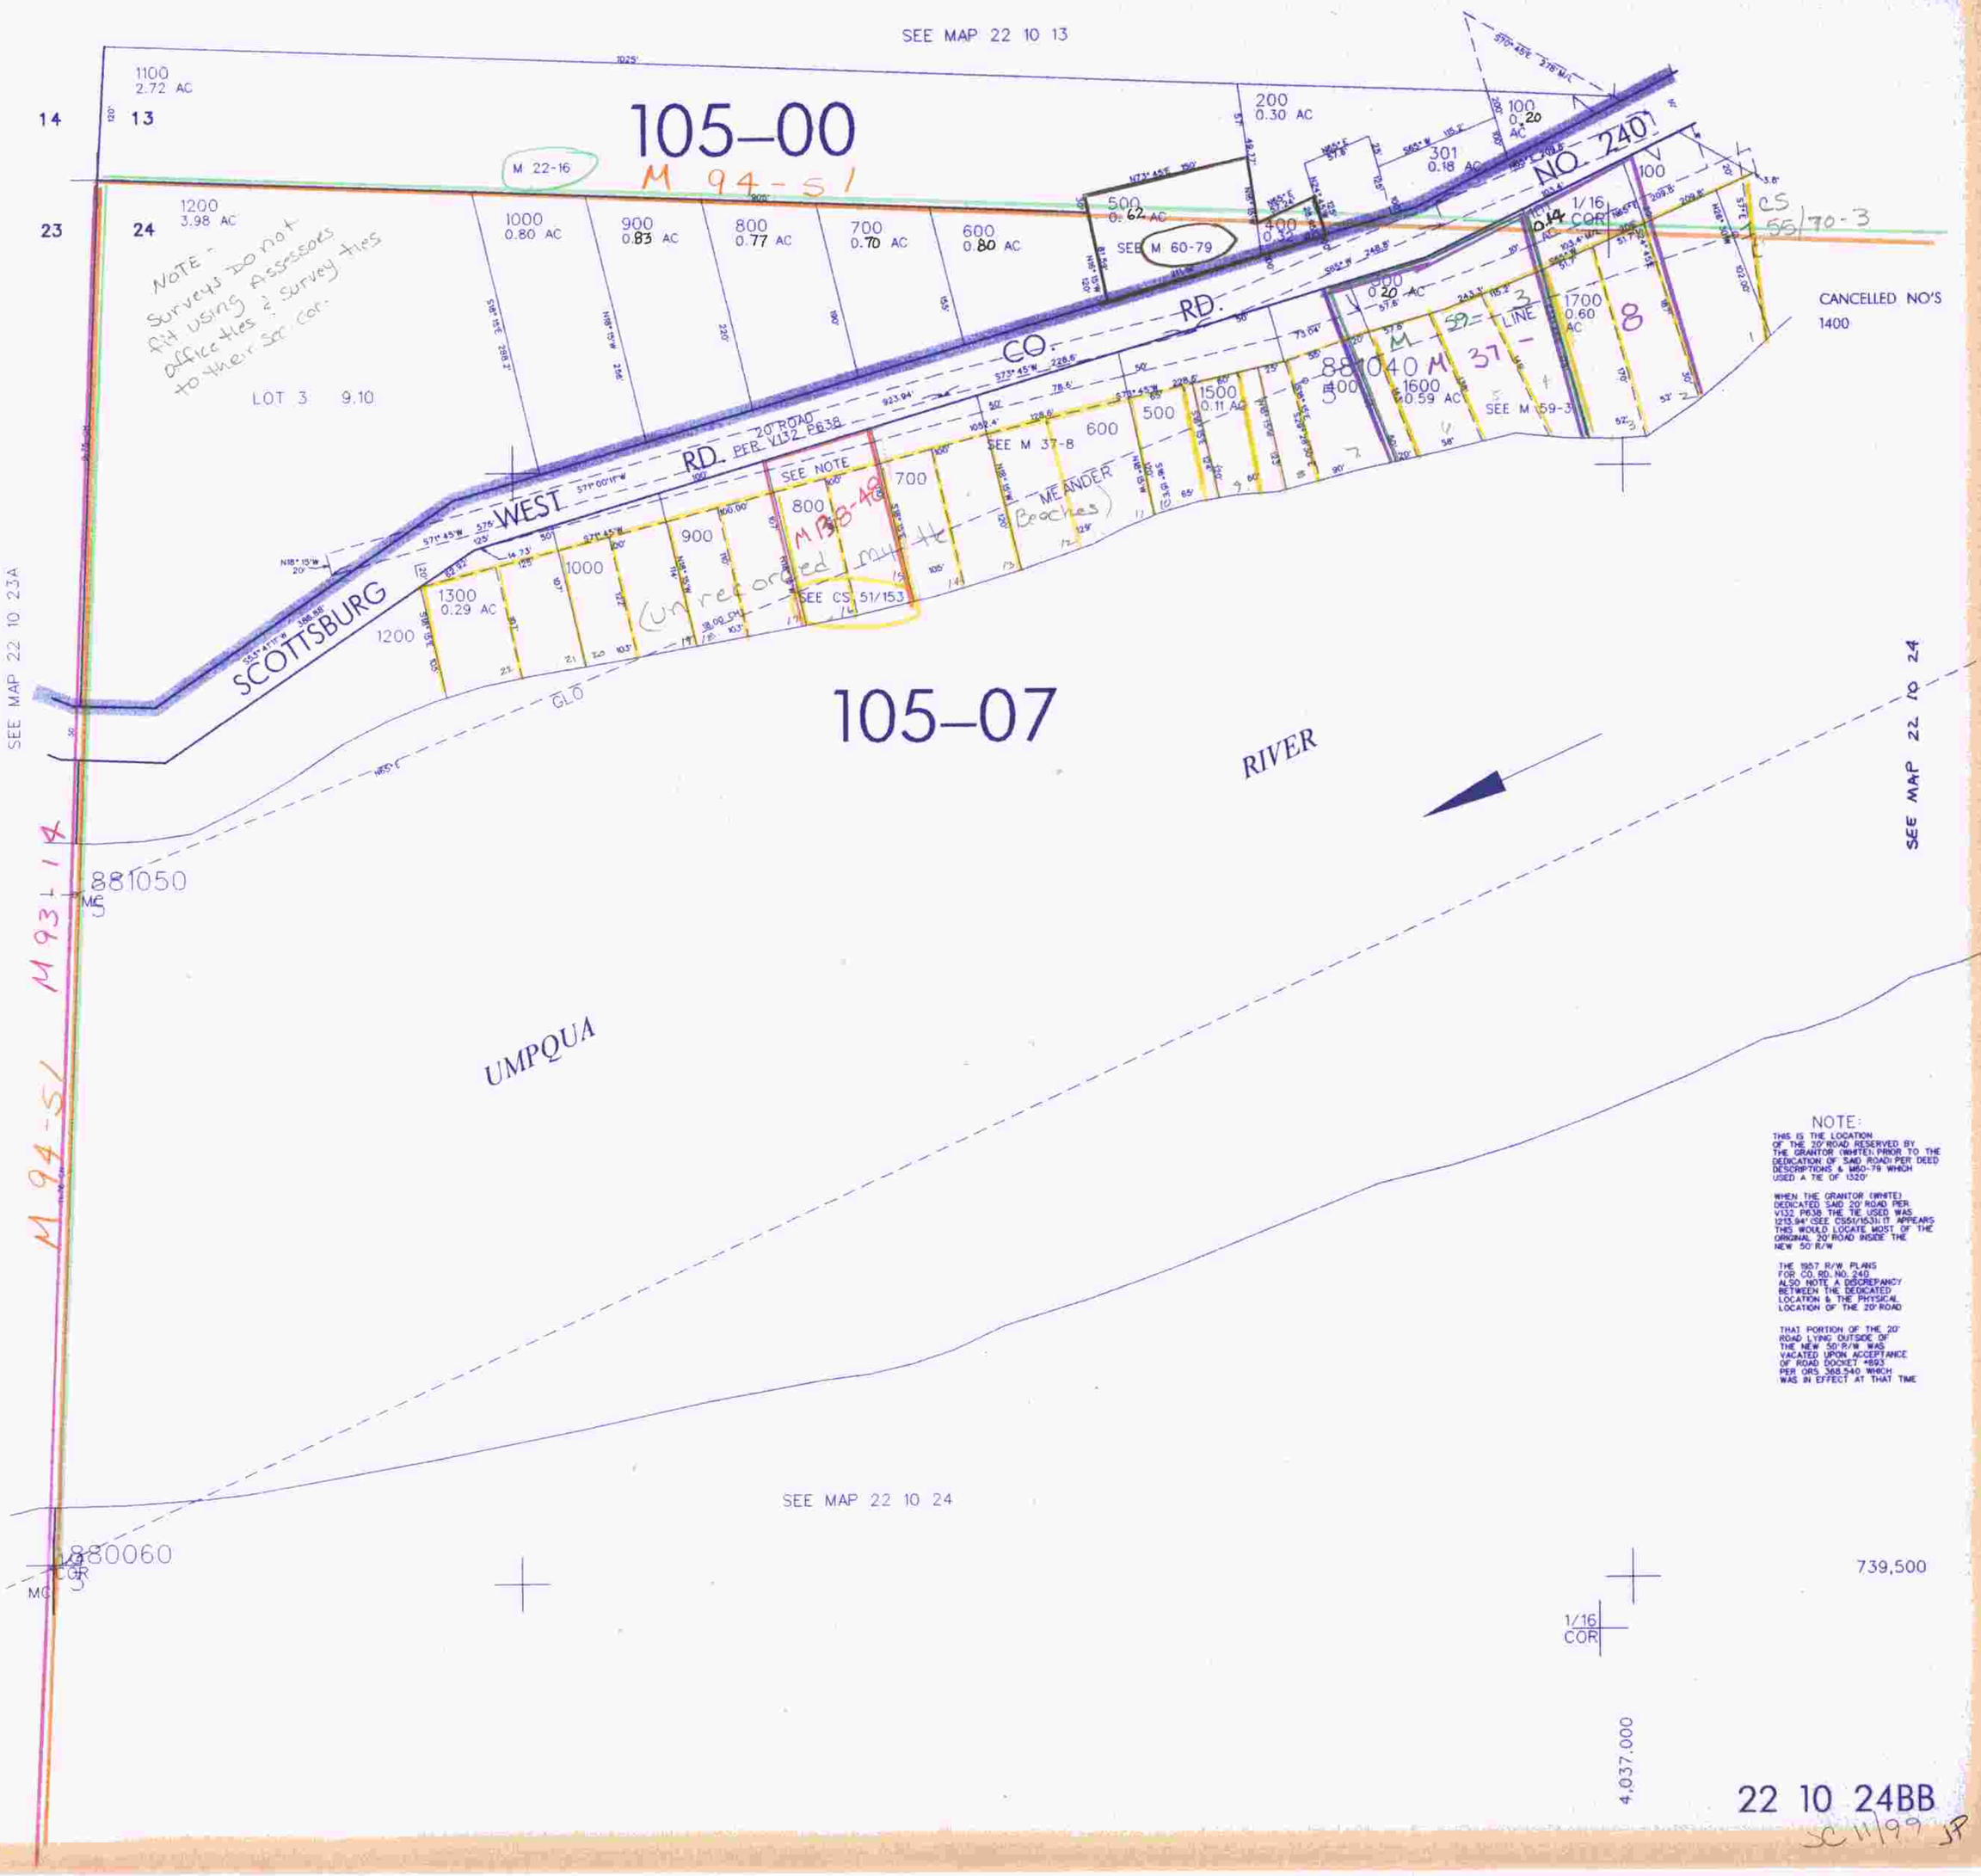

NOTE:
THIS IS THE LOCATION OF THE 20' ROAD RESERVED BY THE GRANTOR (WHITE) PRIOR TO THE DEDICATION OF SAID ROAD PER DEED DESCRIPTIONS & M60-79 WHICH USED A TIE OF 1320'

WHEN THE GRANTOR (WHITE) DEDICATED SAID 20' ROAD PER V132 P638 THE TIE USED WAS 1213.94' (SEE CS51/153) IT APPEARS THIS WOULD LOCATE MOST OF THE ORIGINAL 20' ROAD INSIDE THE NEW 50' R/W

THE 1957 R/W PLANS FOR CO. RD. NO. 240 ALSO NOTE A DISCREPANCY BETWEEN THE DEDICATED LOCATION & THE PHYSICAL LOCATION OF THE 20' ROAD

THAT PORTION OF THE 20' ROAD LYING OUTSIDE OF THE NEW 50' R/W WAS VACATED UPON ACCEPTANCE OF ROAD DOCKET #893 PER ORS 368.540 WHICH WAS IN EFFECT AT THAT TIME

22 10 24BB

SC 11/99 JP