THIS MAP WAS PREPARED FOR ASSESSMENT PURPOSE ONLY

SEC. 3 T.22S. R.11W W.M.
DOUGLAS COUNTY

1" = 400'

22 11 3

REVISED ON
12-6-99
7-8-03

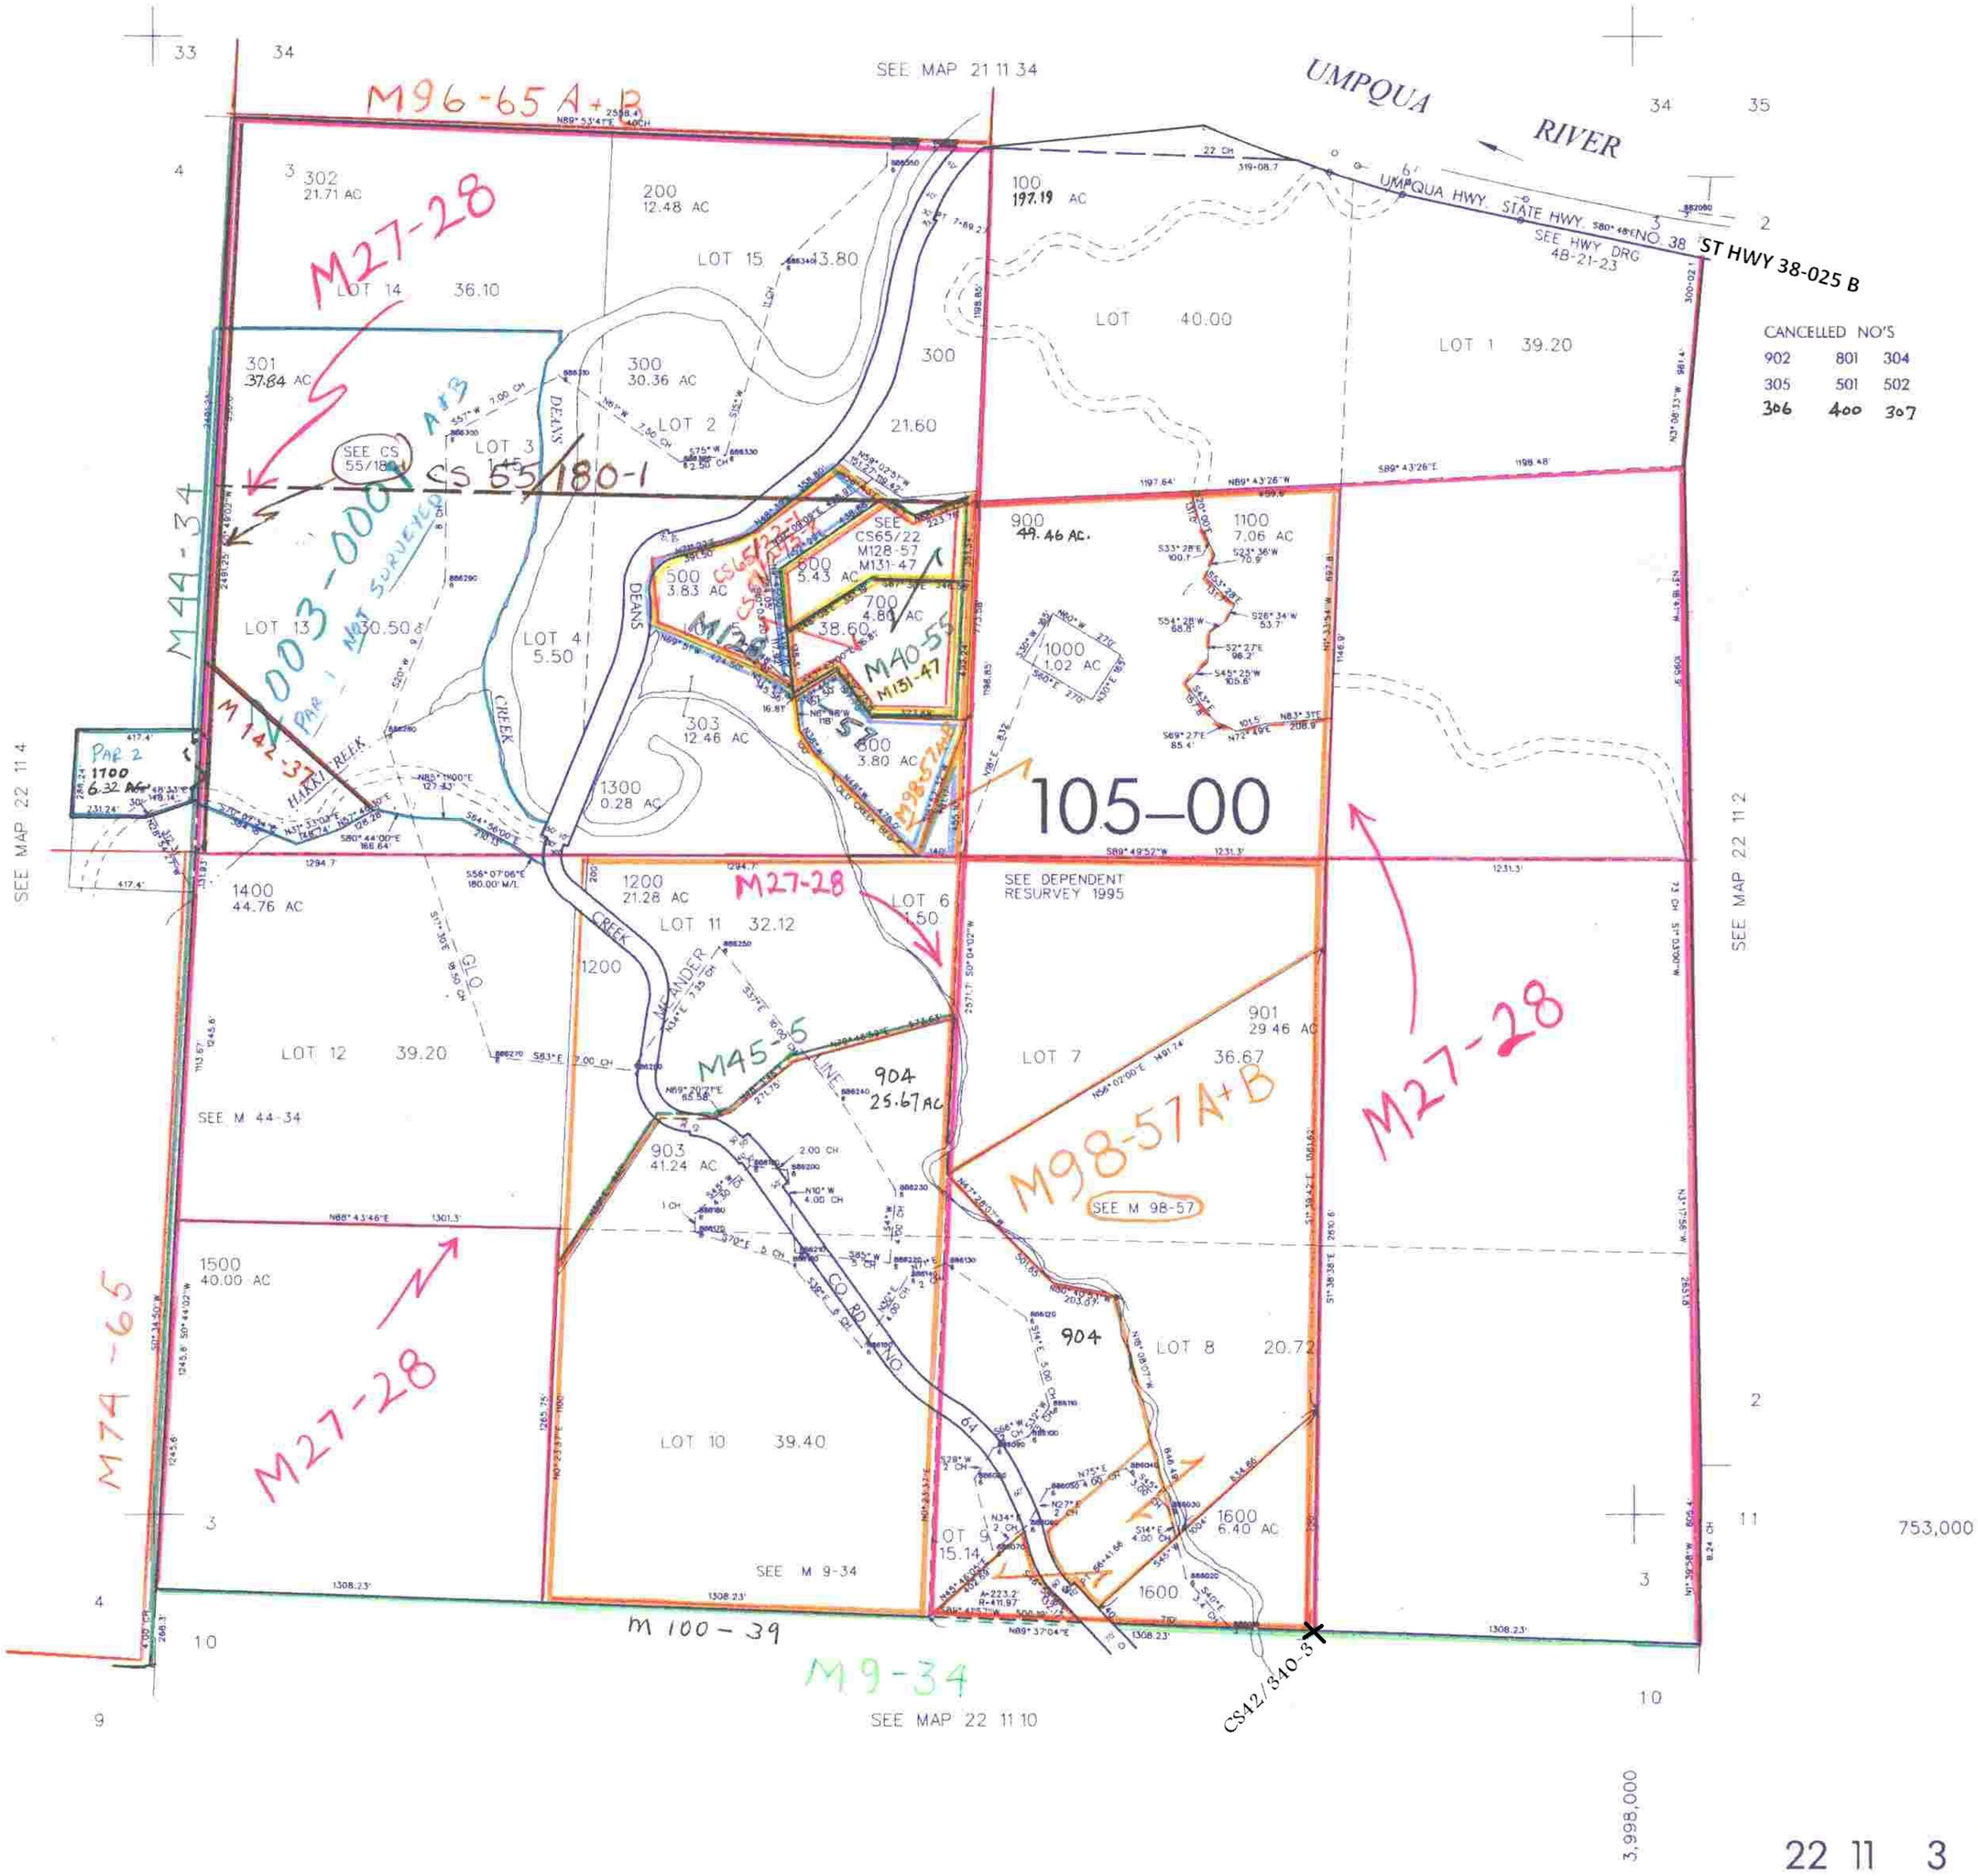

CANCELLED NO'S

902	801	304
305	501	502
306	400	307

22 11 3