THIS MAP WAS PREPARED FOR ASSESSMENT PURPOSE ONLY.

SEC.3 T.22S. R.12W. W.M.
DOUGLAS COUNTY

1" = 400'

REVISED ON 1-29-21

22 12 3 & INDEX REEDSPORT

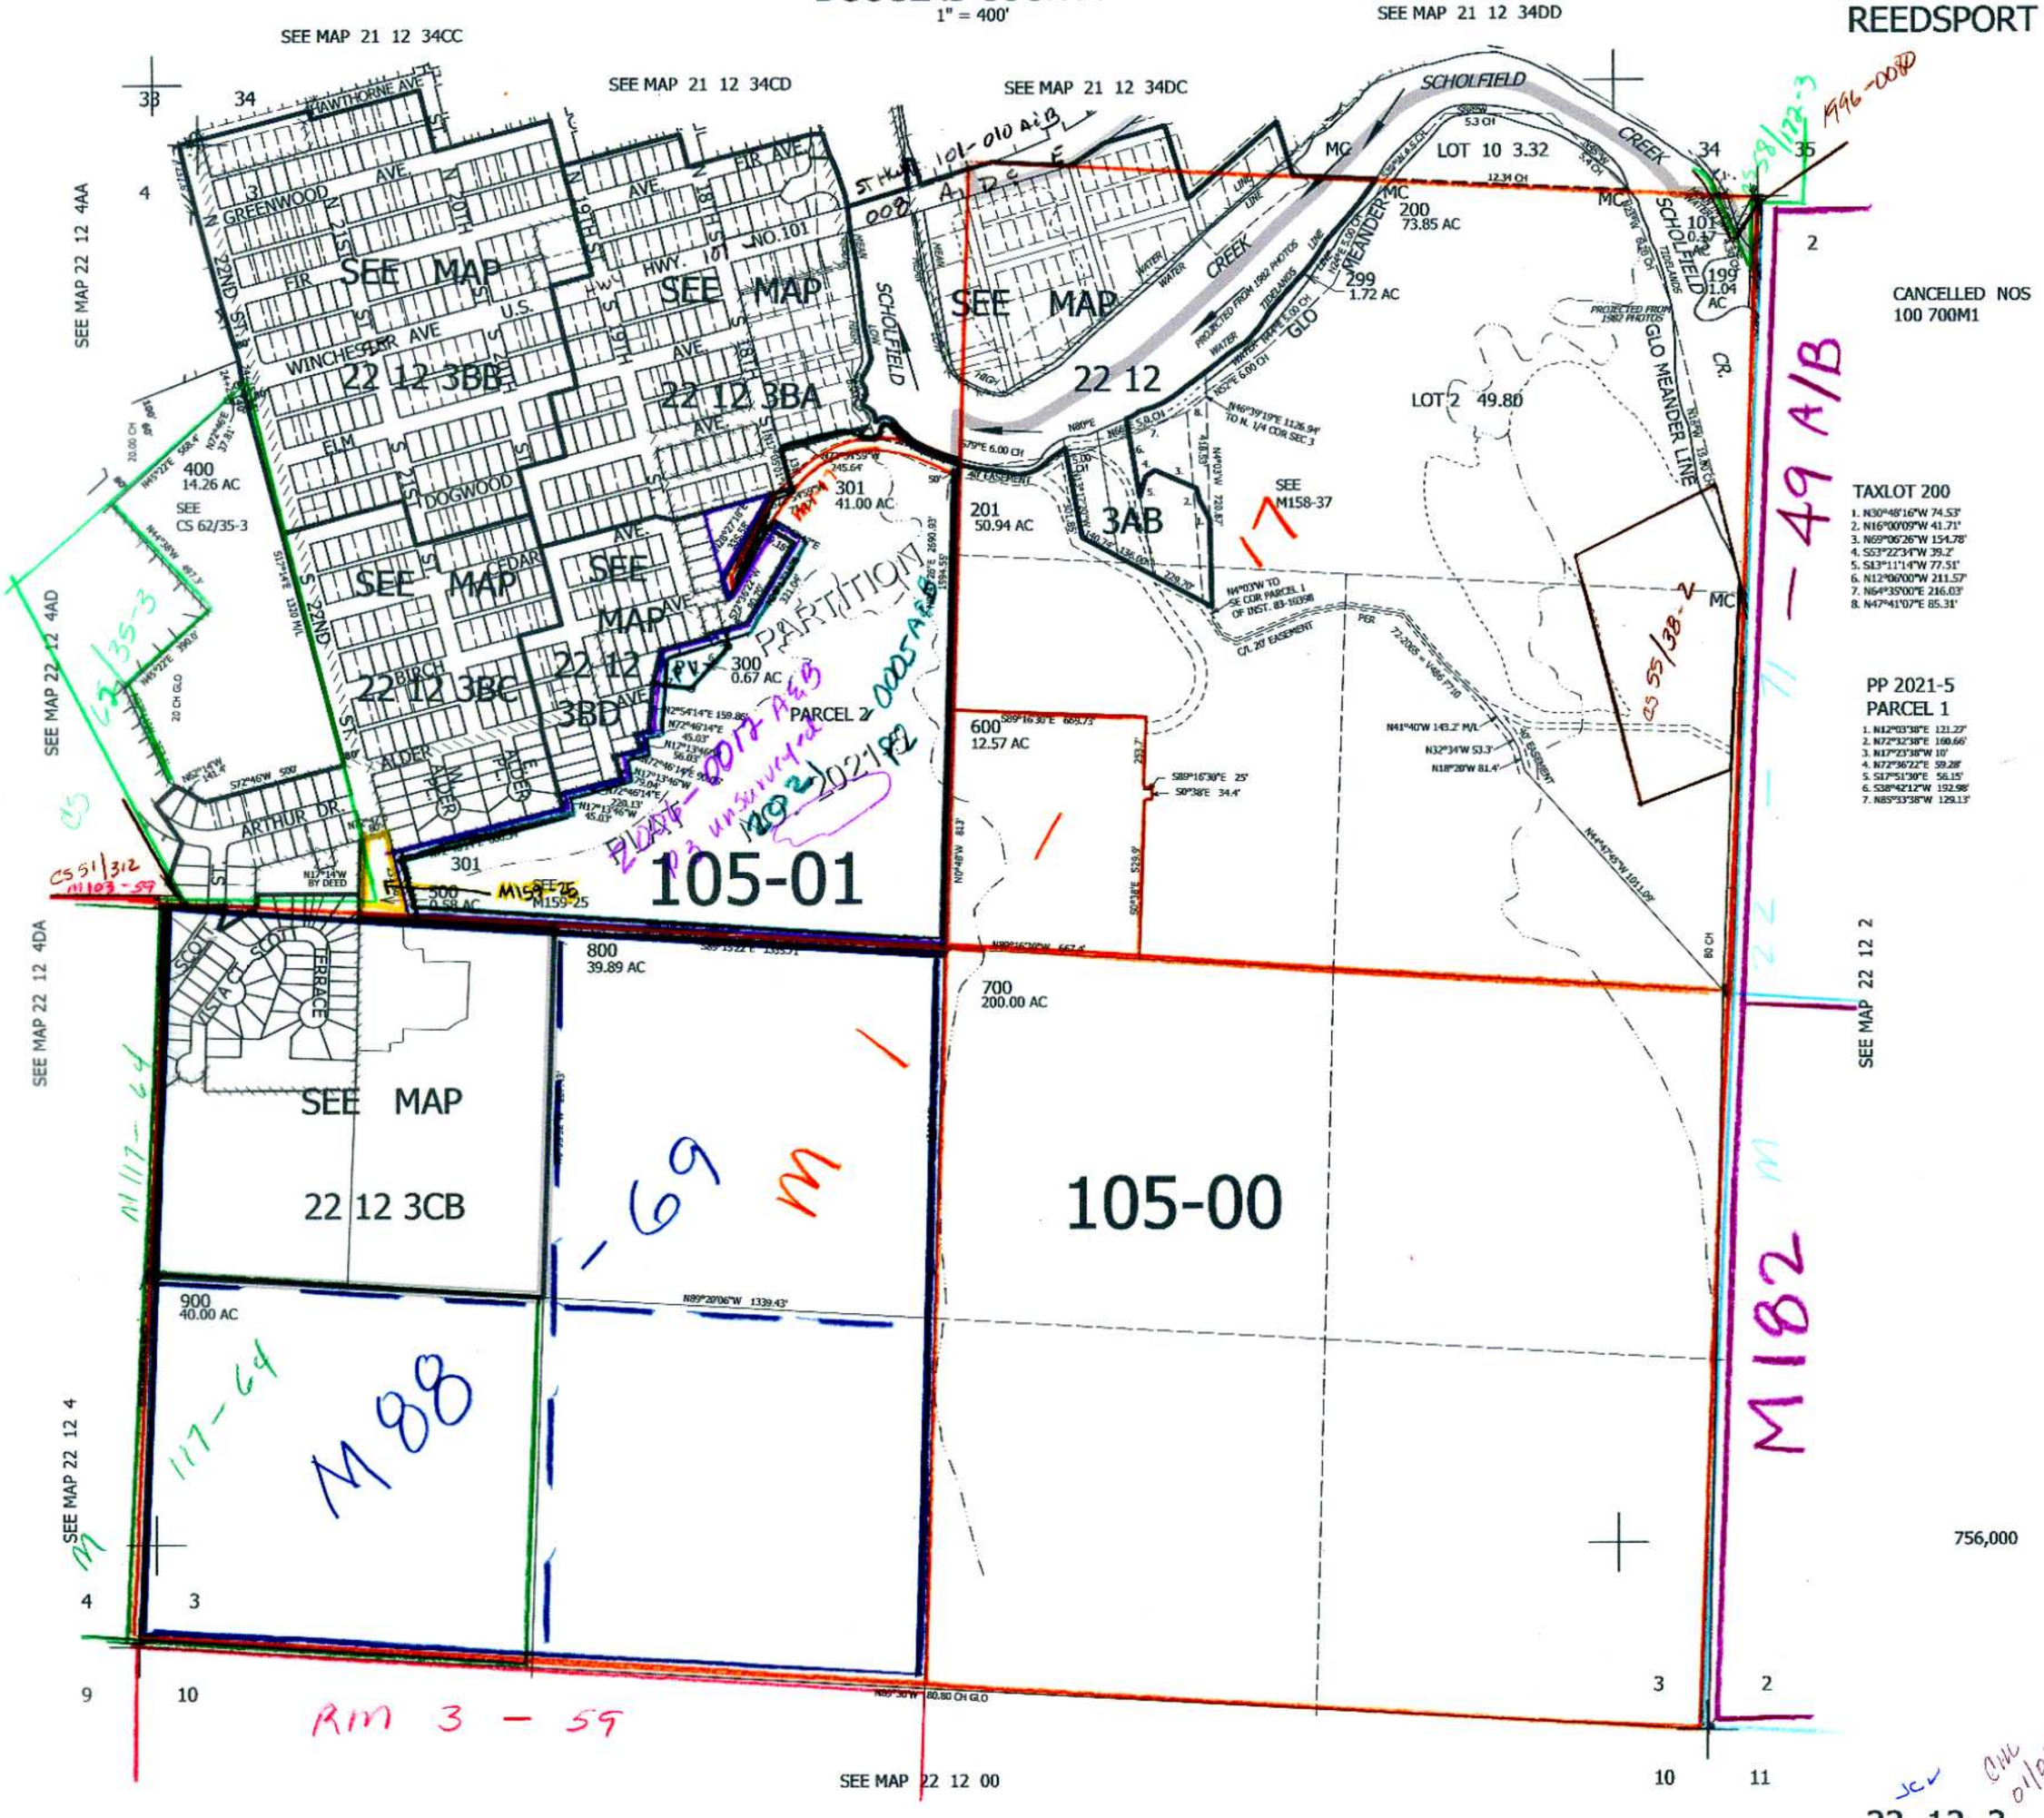

22 12 3 & INDEX REEDSPORT