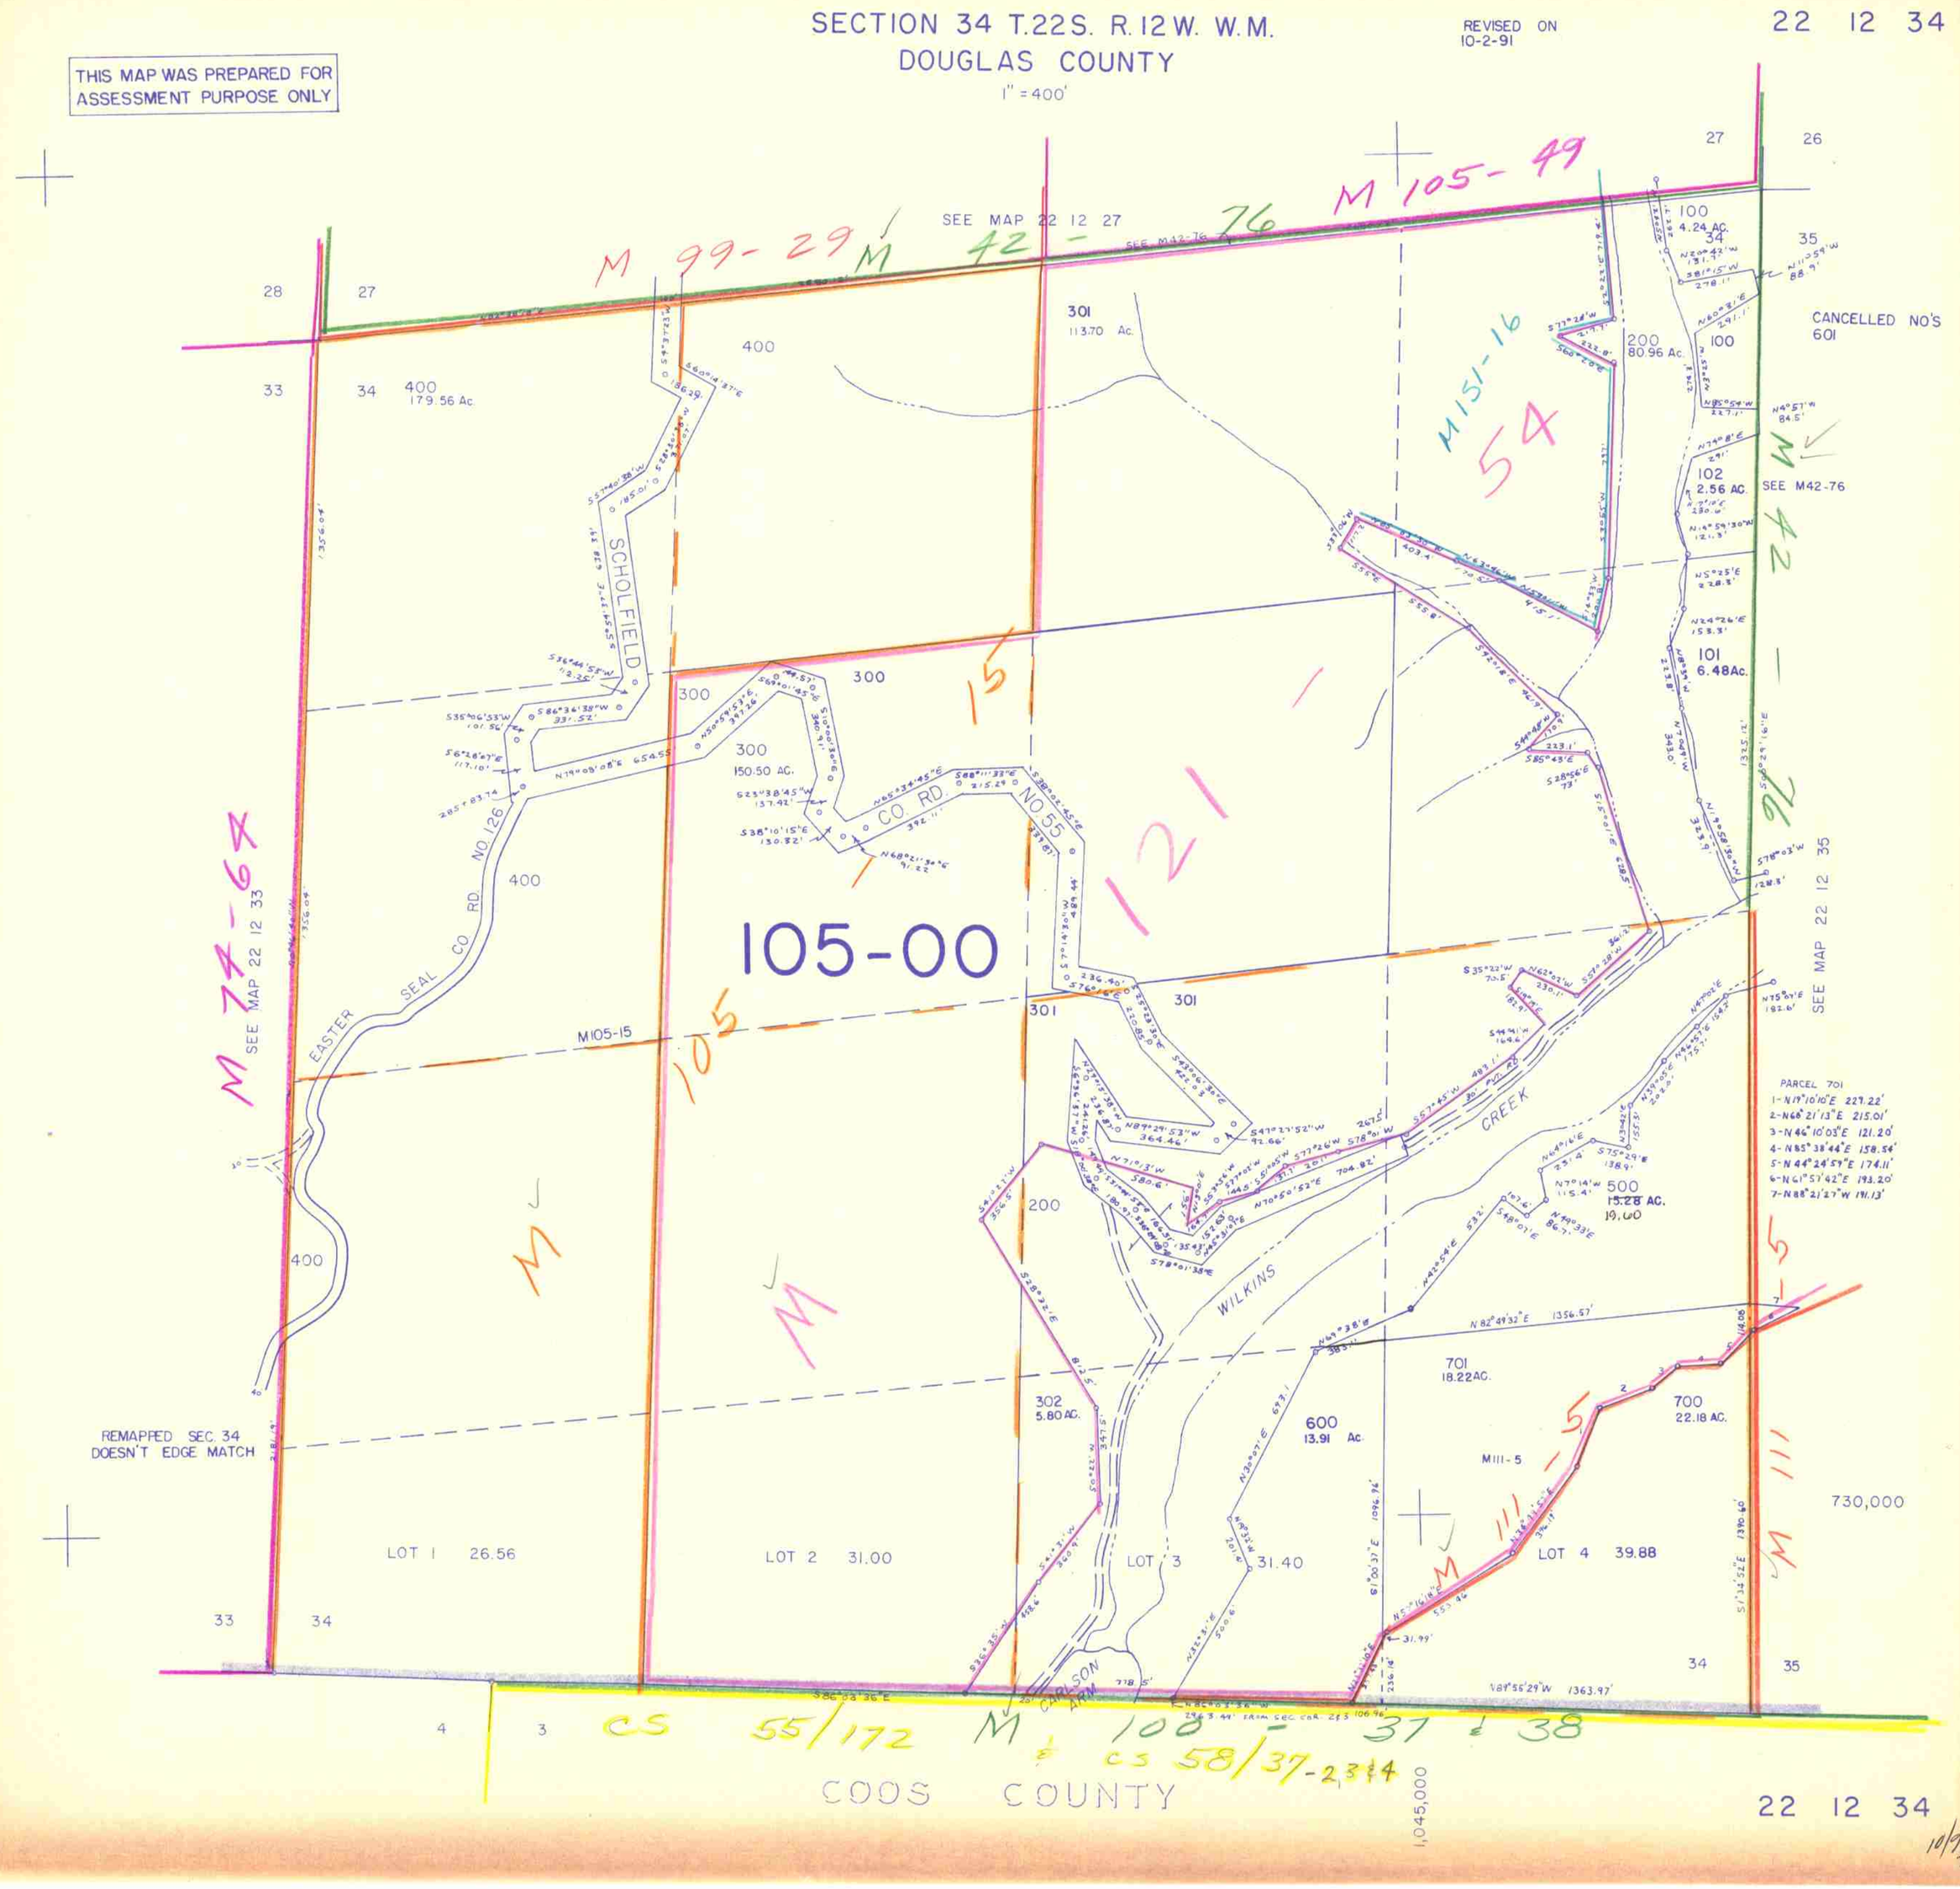
SECTION 34 T.22S. R.12W. W.M.
DOUGLAS COUNTY
1" = 400'
REVISED ON 10-2-91
22 12 34
THIS MAP WAS PREPARED FOR ASSESSMENT PURPOSE ONLY
SEE MAP 22 12 27
SEE M42-76
CANCELLED NO'S 601
SEE M42-76
SEE MAP 22 12 35
SEE MAP 22 12 33
105-00
SCHOLFIELD
EASTER SEAL CO RD
CO. RD. NO 55
CO. RD. NO 126
WILKINS CREEK
CARLSON ARM
M105-15
M111-5
PARCEL 701
1-N19°10'10"E 227.22'
2-N66°21'13"E 215.01'
3-N44°10'03"E 121.20'
4-N85°38'44"E 158.54'
5-N44°24'59"E 174.11'
6-N61°51'42"E 193.20'
7-N88°21'27"W 191.13'
REMAPPED SEC. 34 DOESN'T EDGE MATCH
LOT 1 26.56
LOT 2 31.00
LOT 3 31.40
LOT 4 39.88
400 179.56 Ac.
300 150.50 AC.
301 113.70 Ac.
200 80.96 Ac.
100 4.24 AC.
102 2.56 AC.
101 6.48Ac.
500 15.28 AC.
302 5.80 AC.
600 13.91 Ac.
701 18.22AC.
700 22.18 AC.
730,000
1,045,000
CS 55/172
M 100-37 & 38
CS 58/37-2,3&4
COOS COUNTY
22 12 34
10/91