THIS MAP WAS PREPARED FOR ASSESSMENT PURPOSE ONLY.

SE1/4 SEC.36 T.22S. R.13W. W.M.
DOUGLAS COUNTY
1" = 200'

REVISED ON 12-14-21

22 13 36D

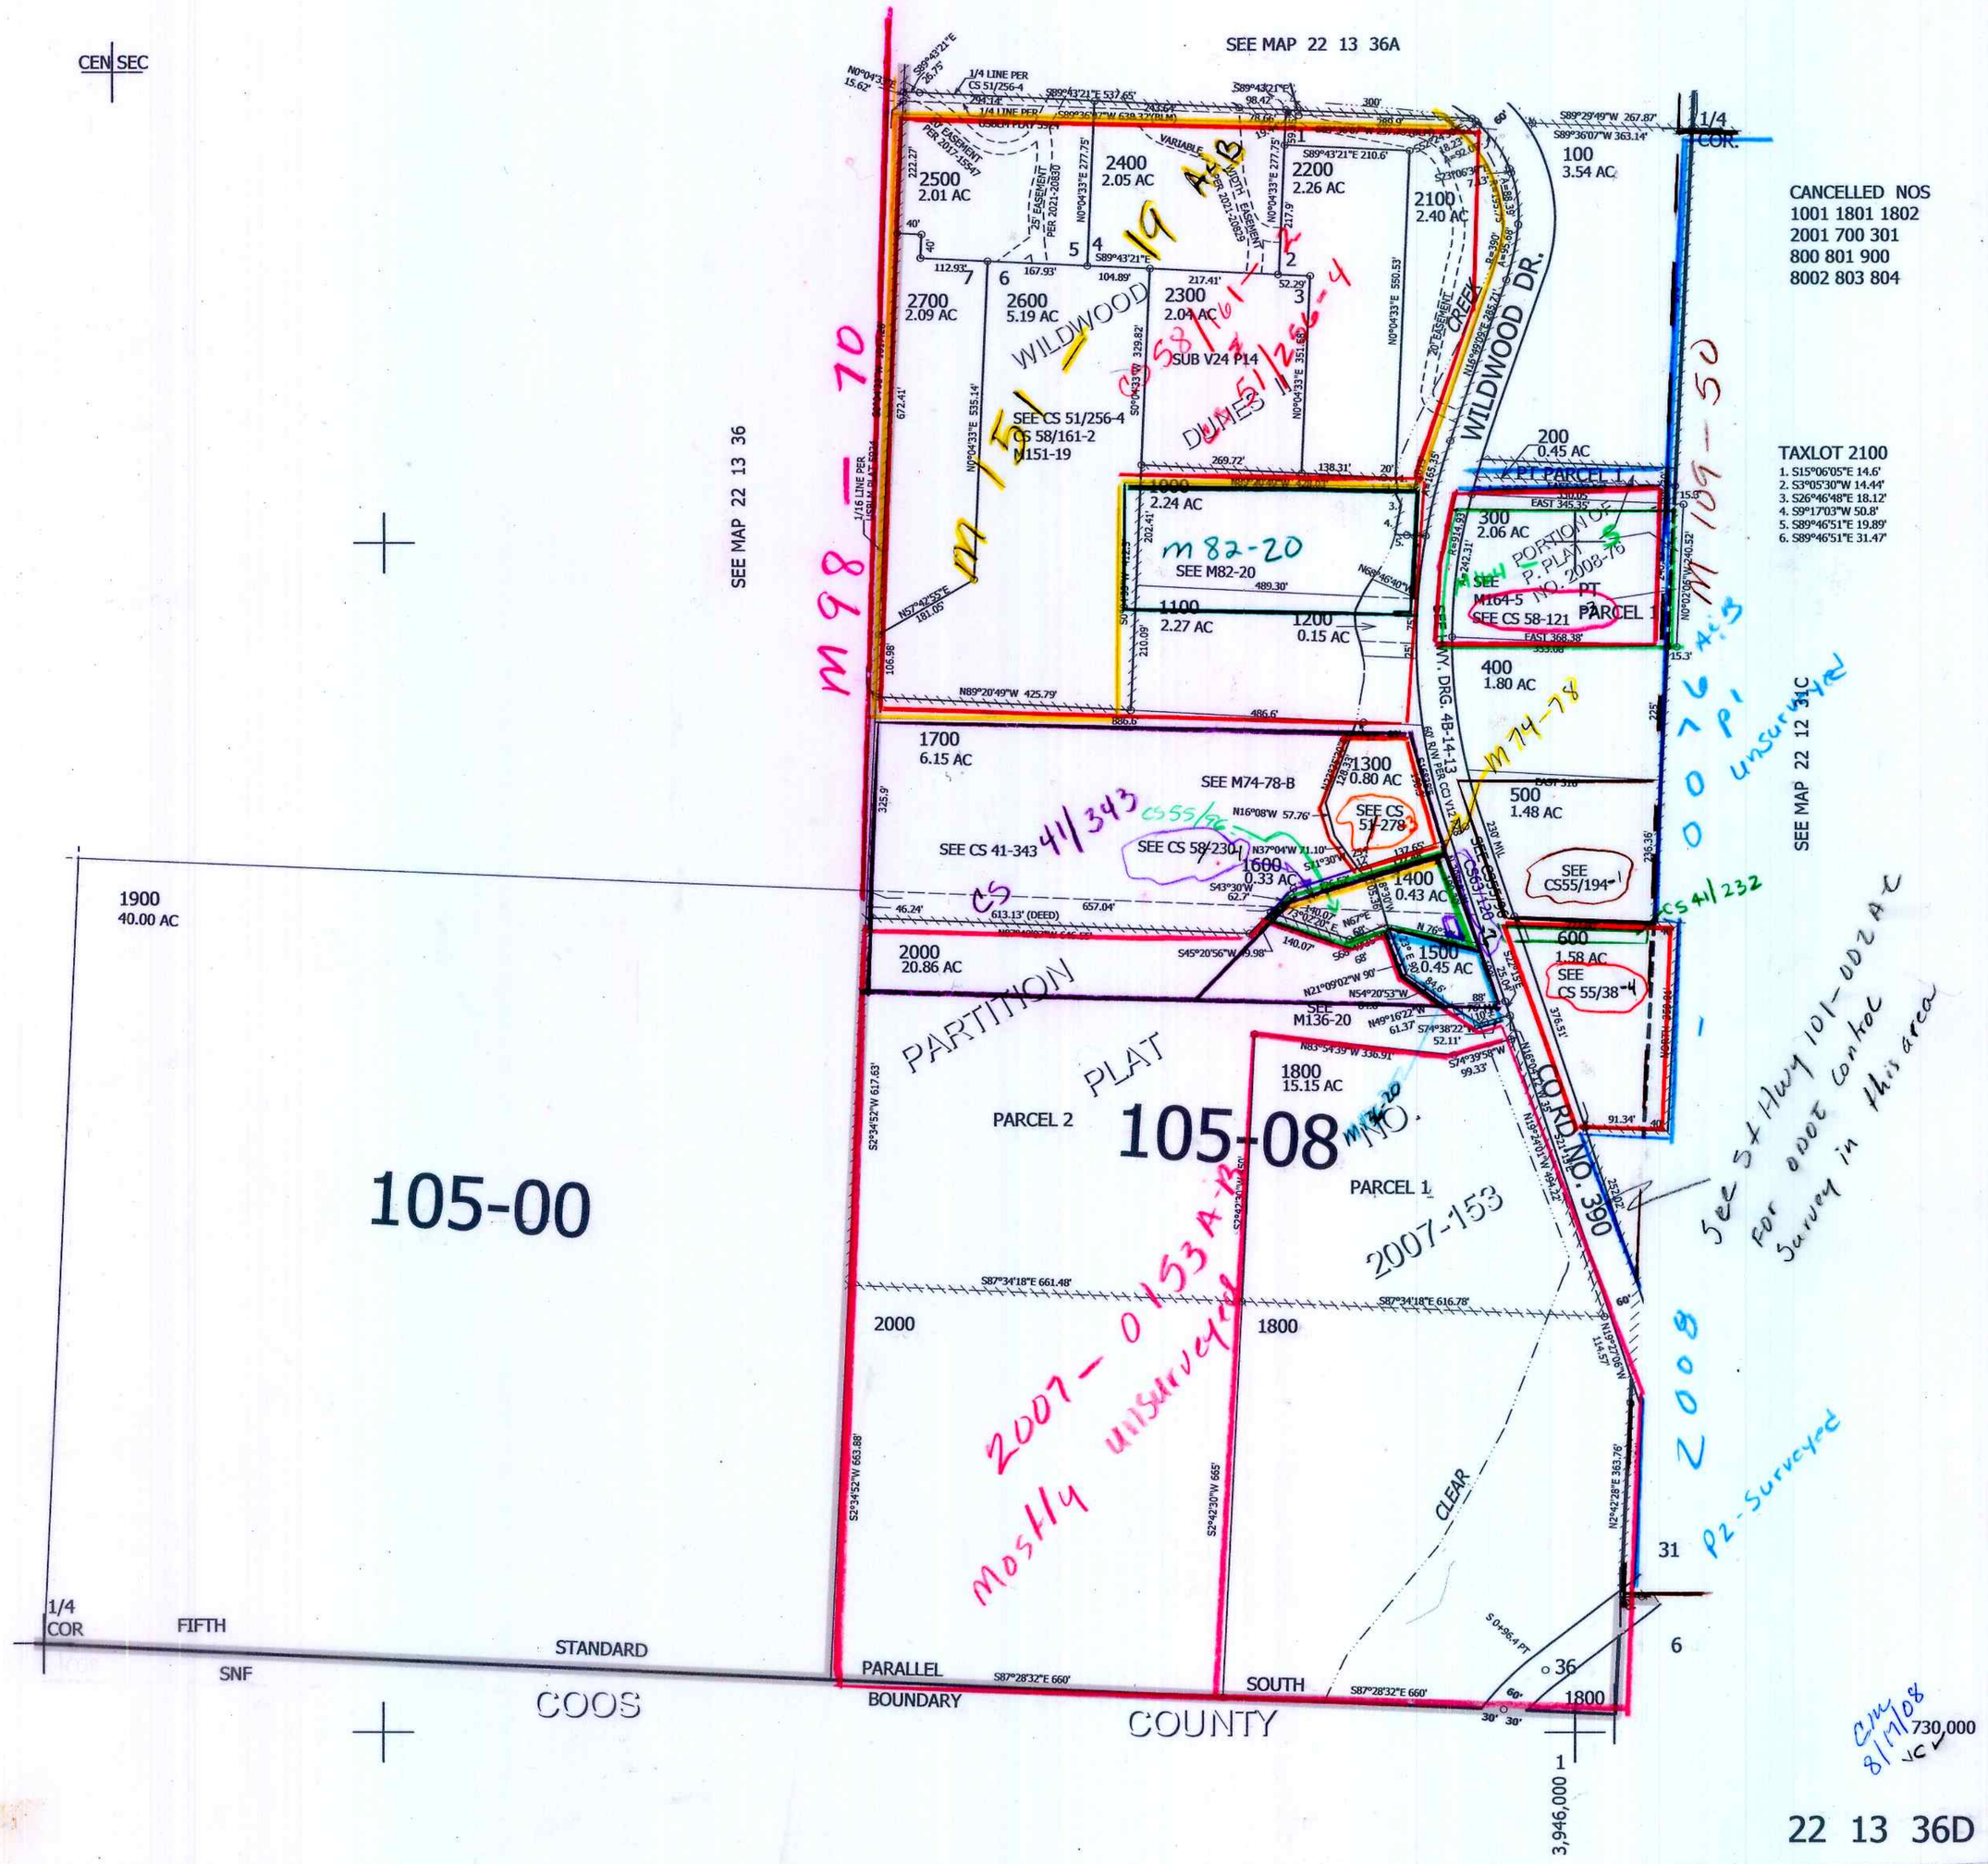

22 13 36D