THIS MAP WAS PREPARED FOR ASSESSMENT PURPOSE ONLY.

SEC.6 T.23S. R.4W. W.M.
DOUGLAS COUNTY

1" = 400'

REVISED ON 1-3-20
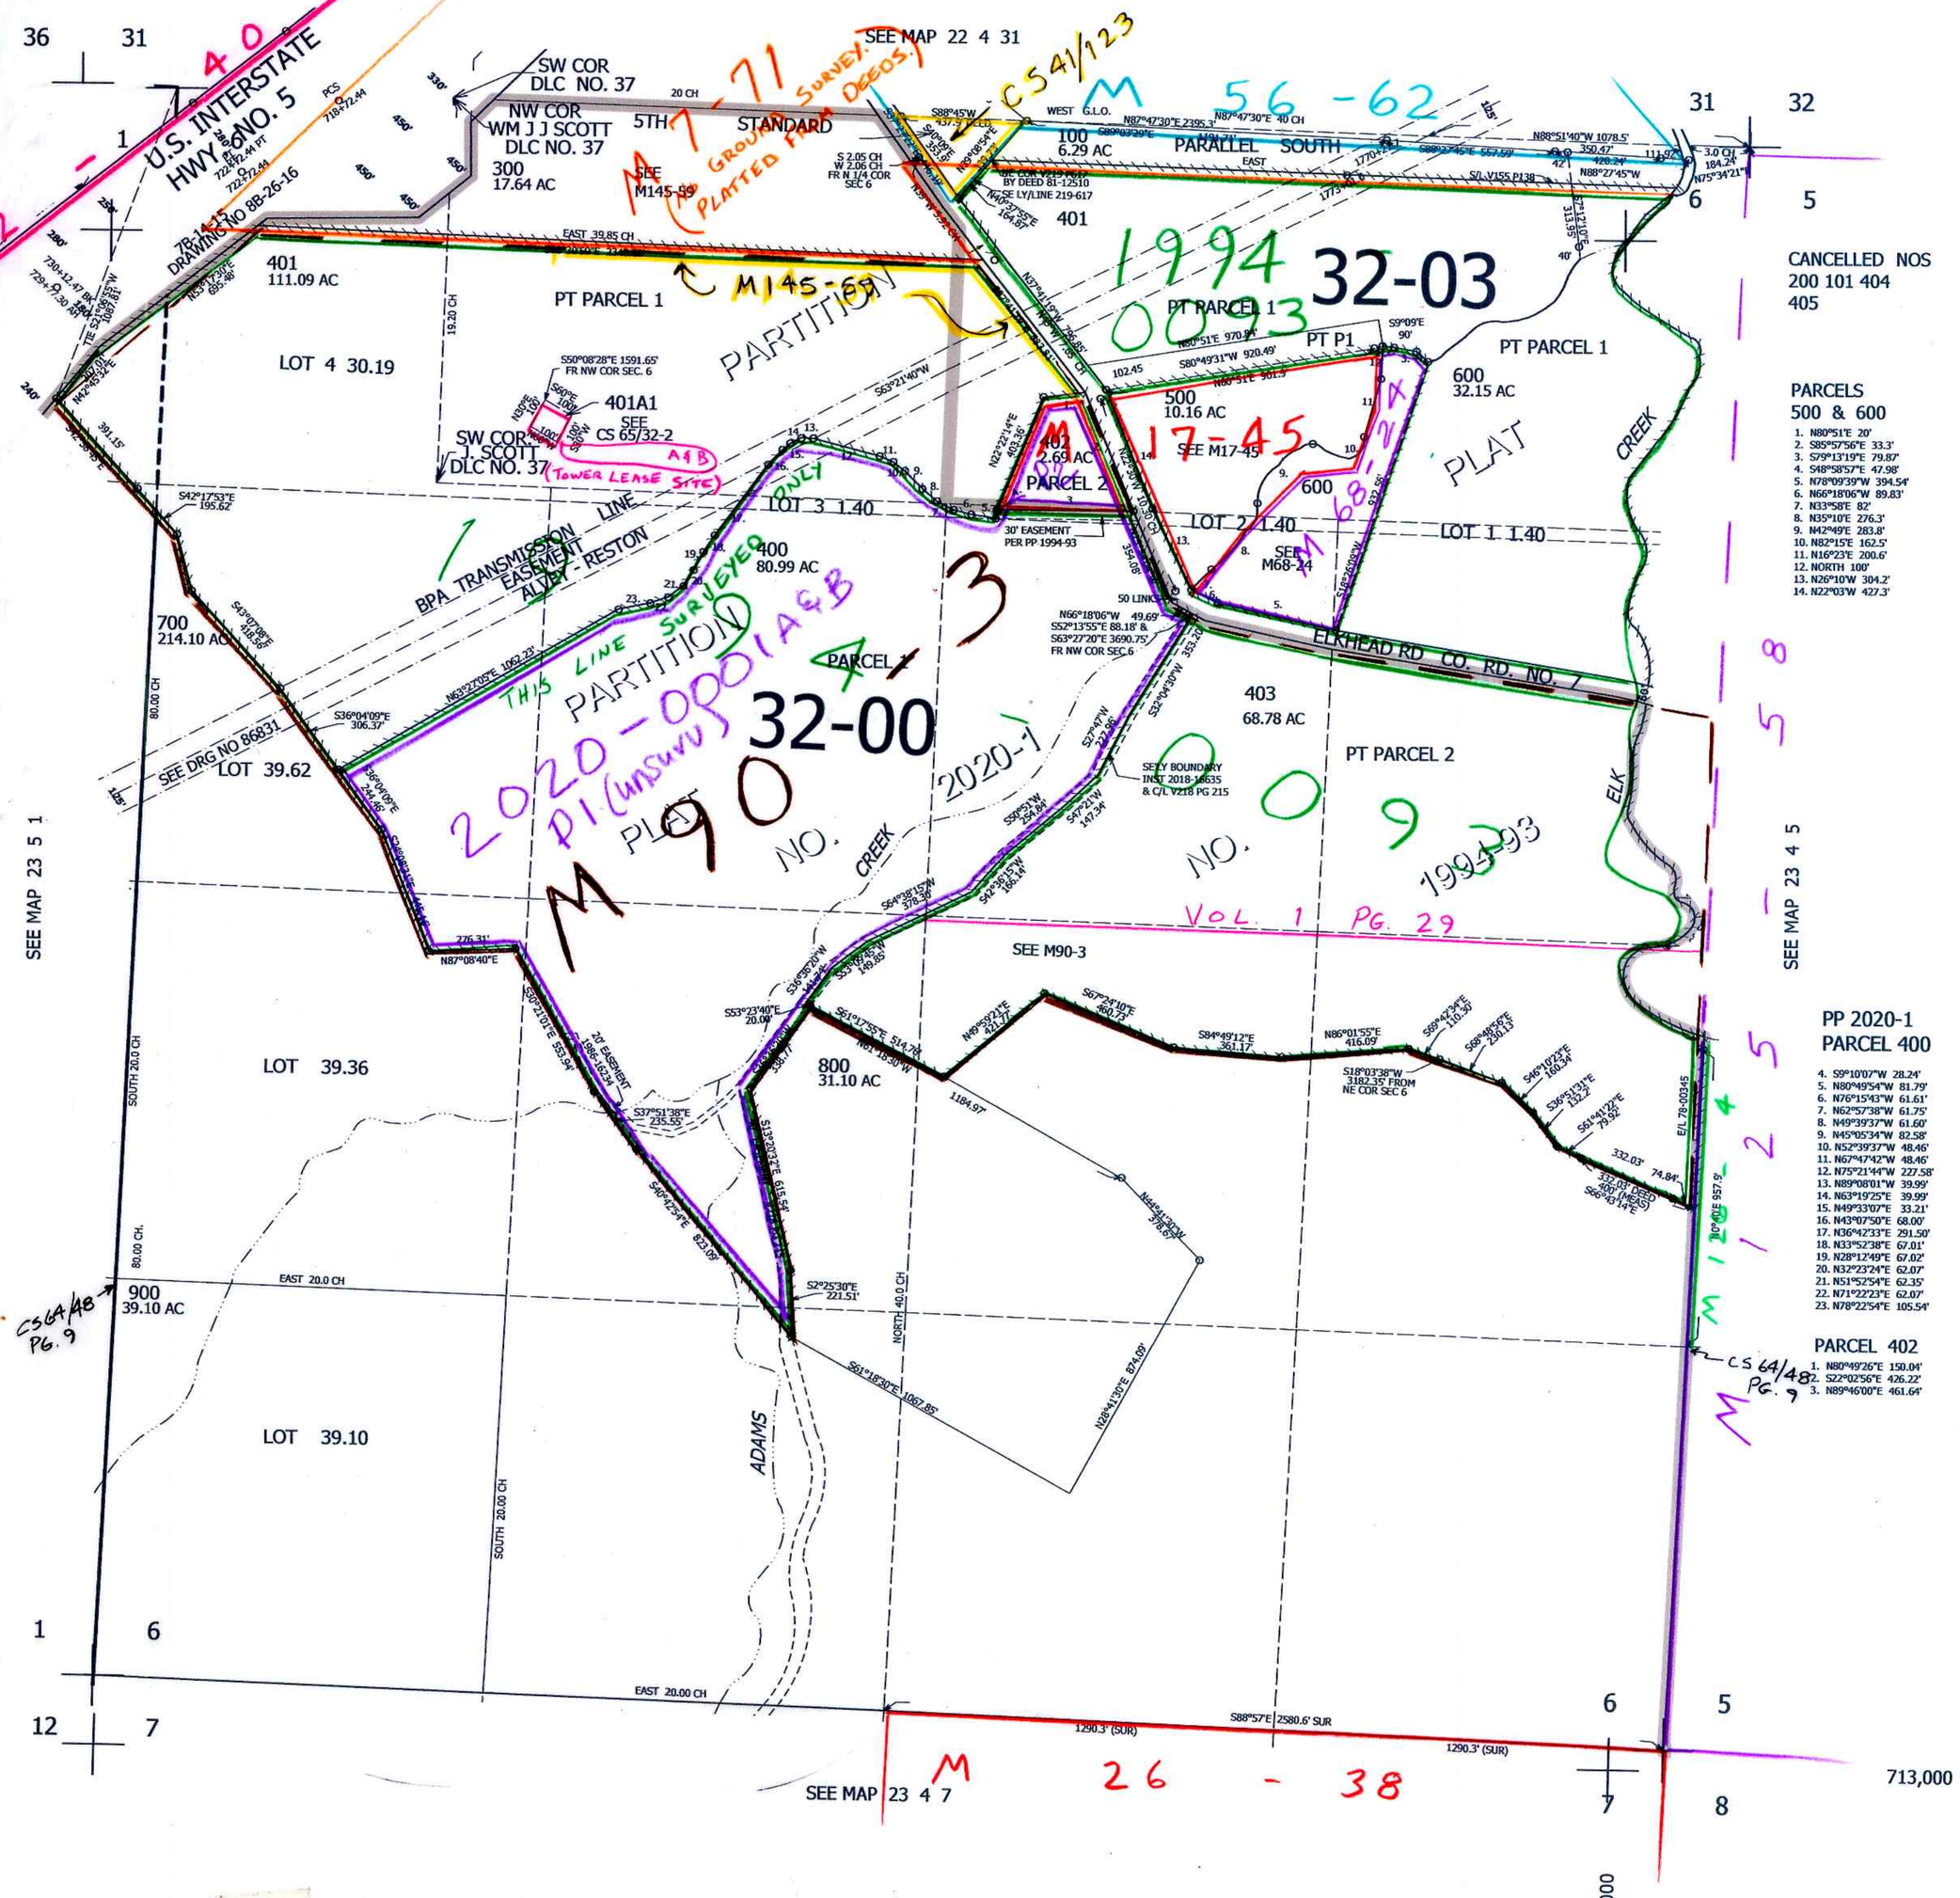
23 4 6