SECTION 21 T.23S. R.4W. W.M.
DOUGLAS COUNTY

REVISED ON 12-16-92

23 4 21

THIS MAP WAS PREPARED FOR ASSESSMENT PURPOSE ONLY.

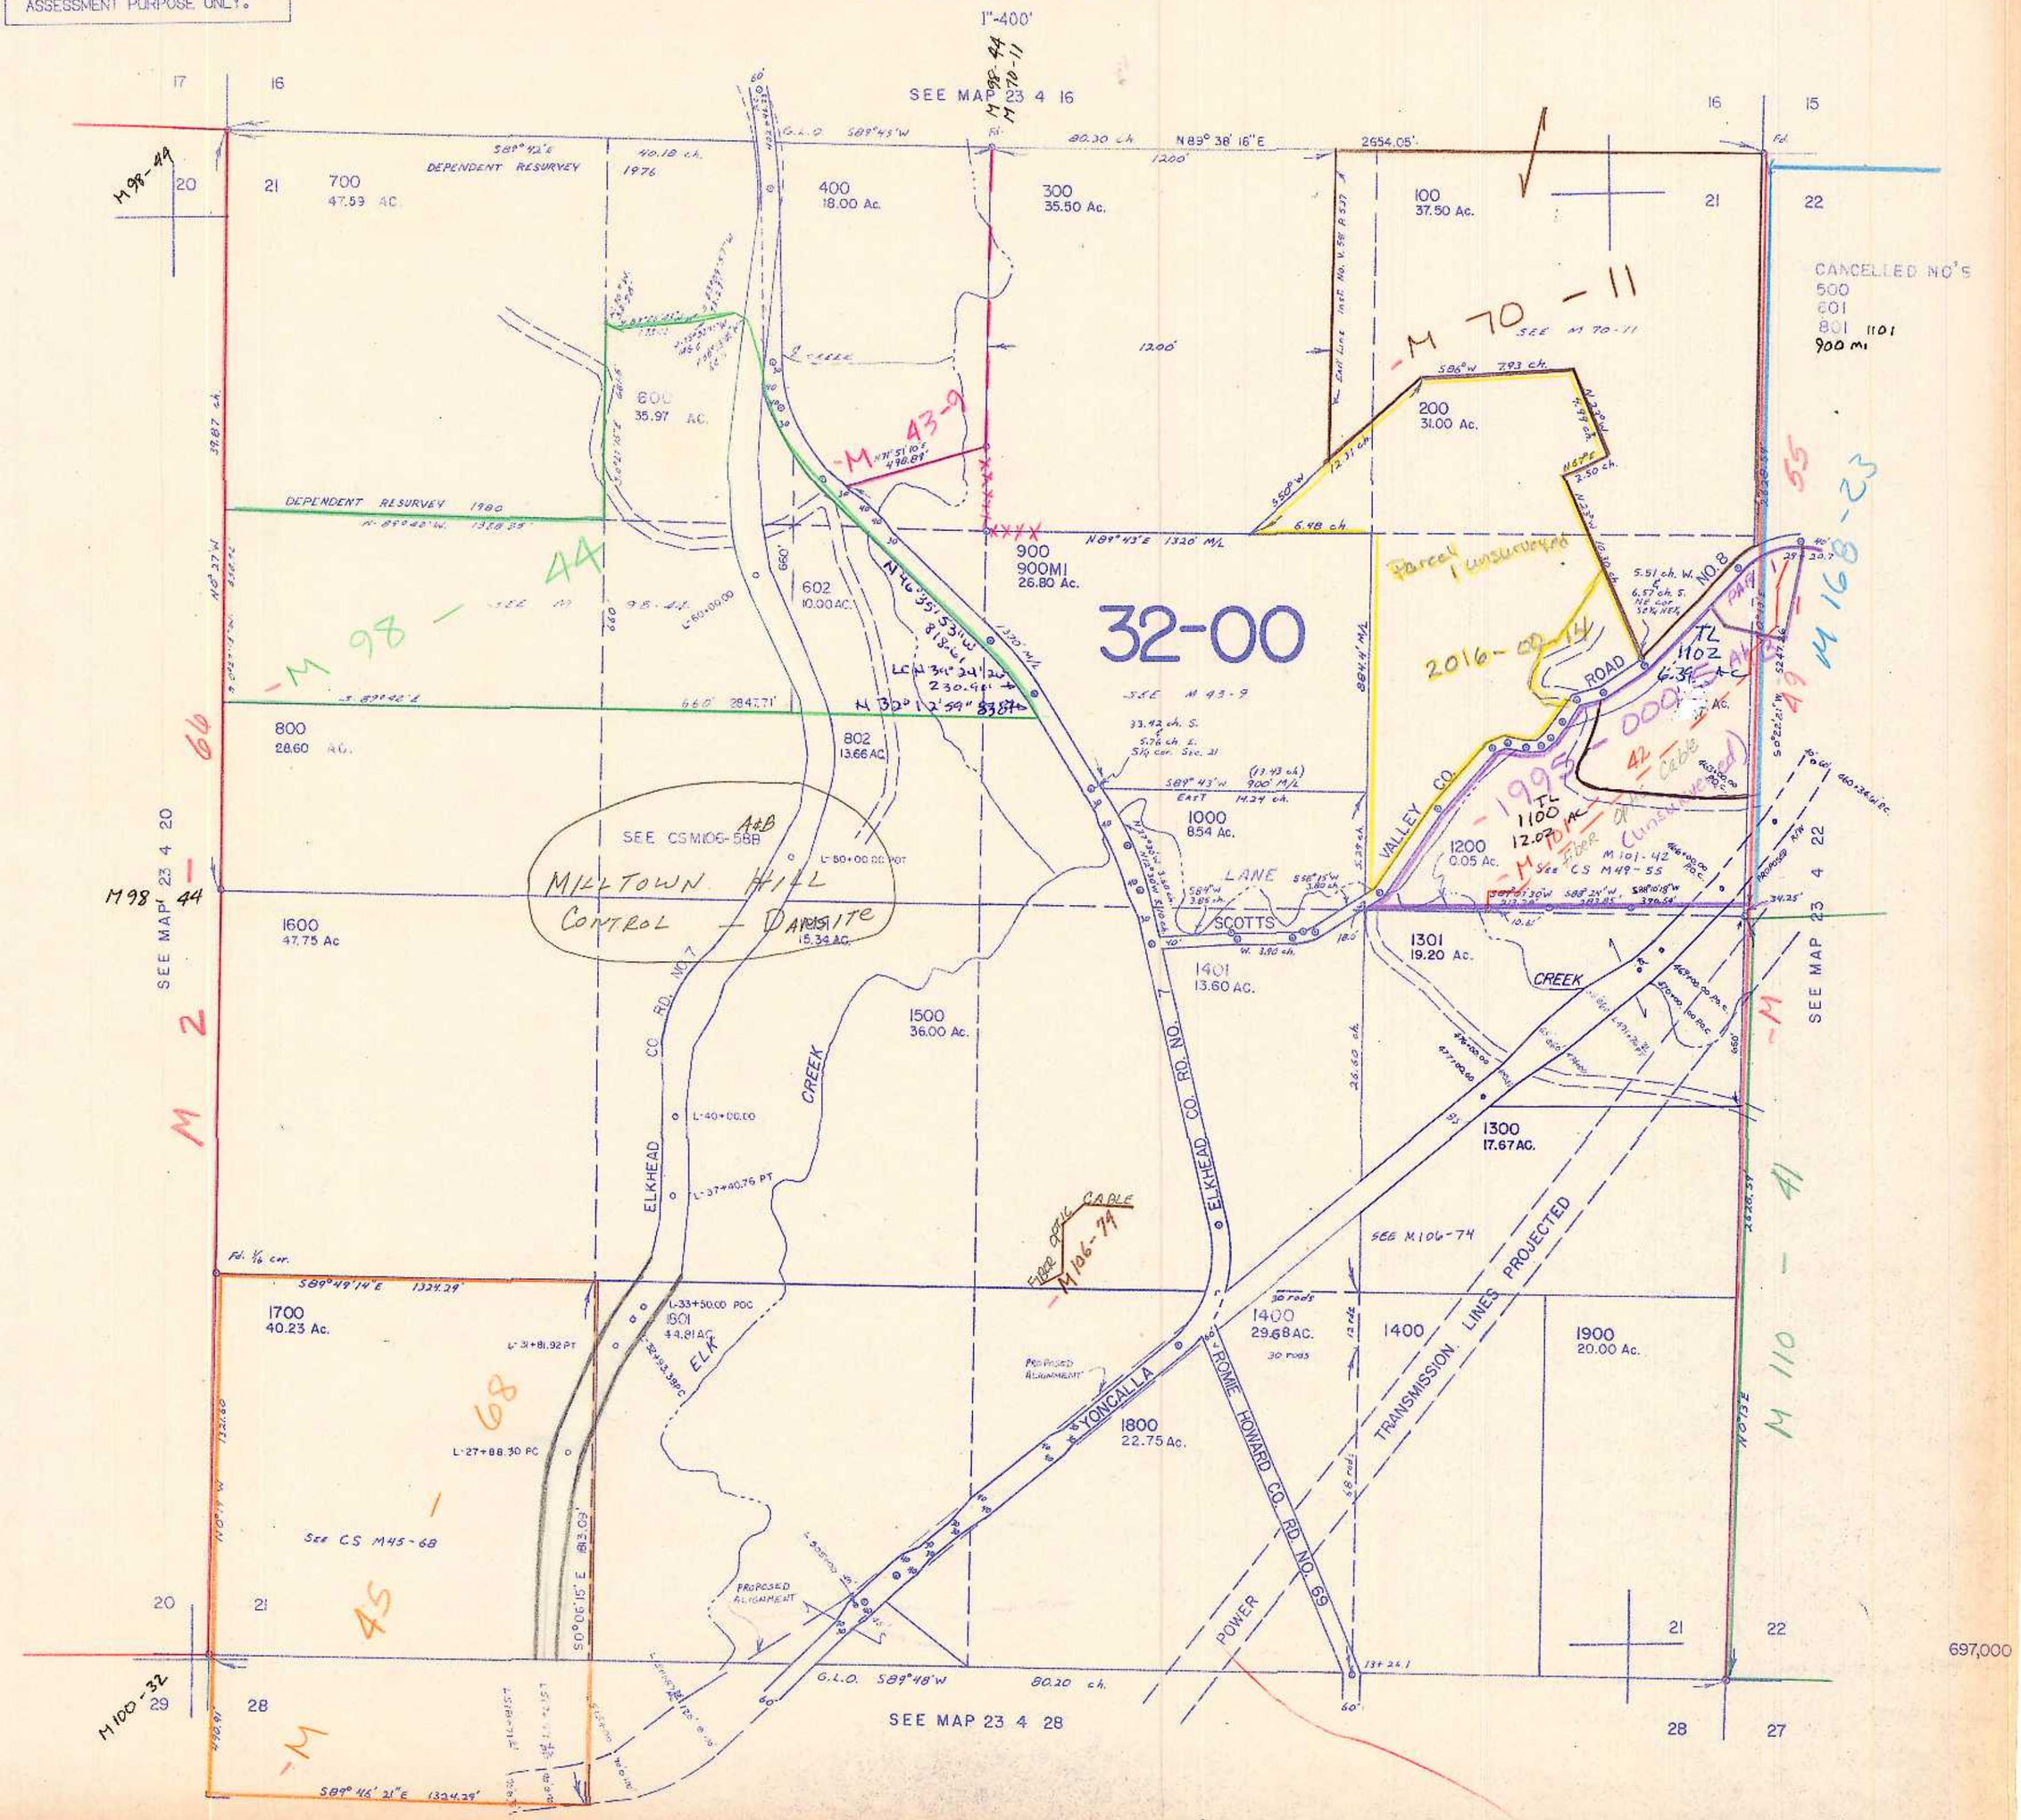

23 4 21