Date Exported 2025-01-15

THIS MAP WAS PREPARED FOR ASSESSMENT PURPOSE ONLY.

Upper Left:
123°12'44"W 43°32'8"N
4202189E 692719N ft

SEC.32 T.23S. R.04W. W.M.
DOUGLAS COUNTY
1" =400'

CANCELLED NOS:
101 200M1 103

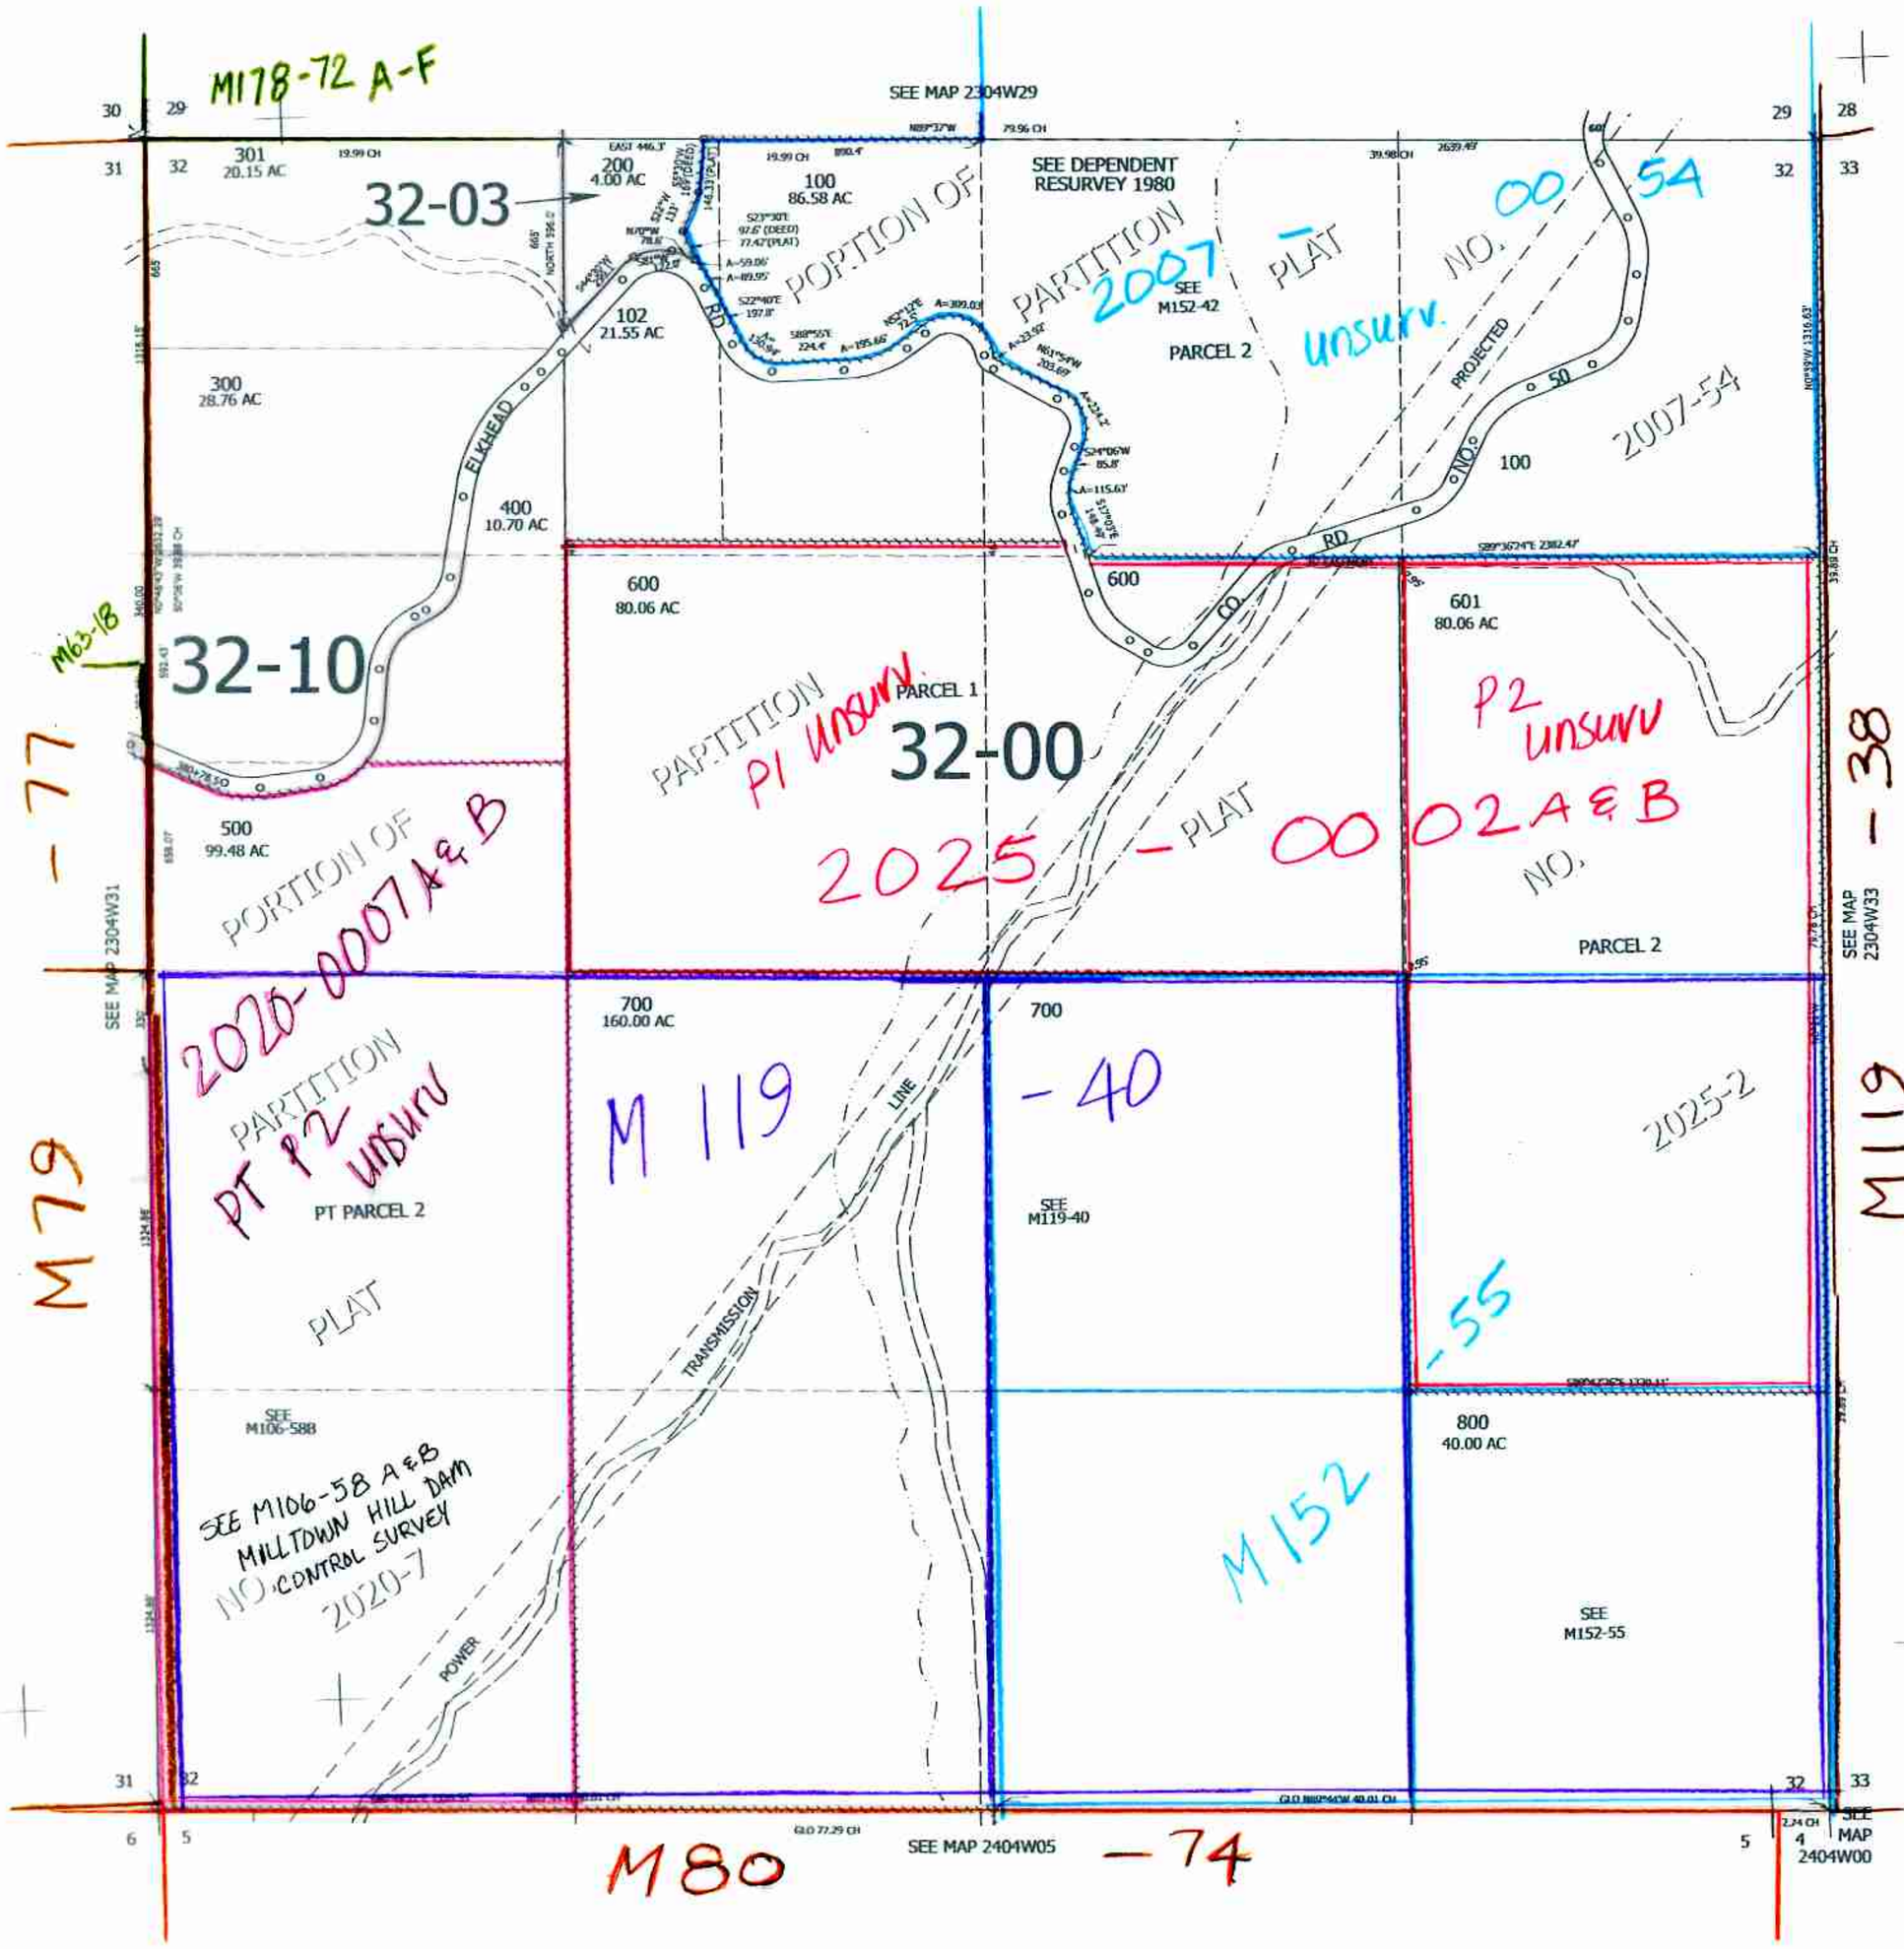

1-2025 8
KL

230432

Lower Right: