SEC. 1 T.23S. R.5W. W.M.
DOUGLAS COUNTY

1" = 400'

THIS MAP WAS PREPARED FOR ASSESSMENT PURPOSE ONLY.

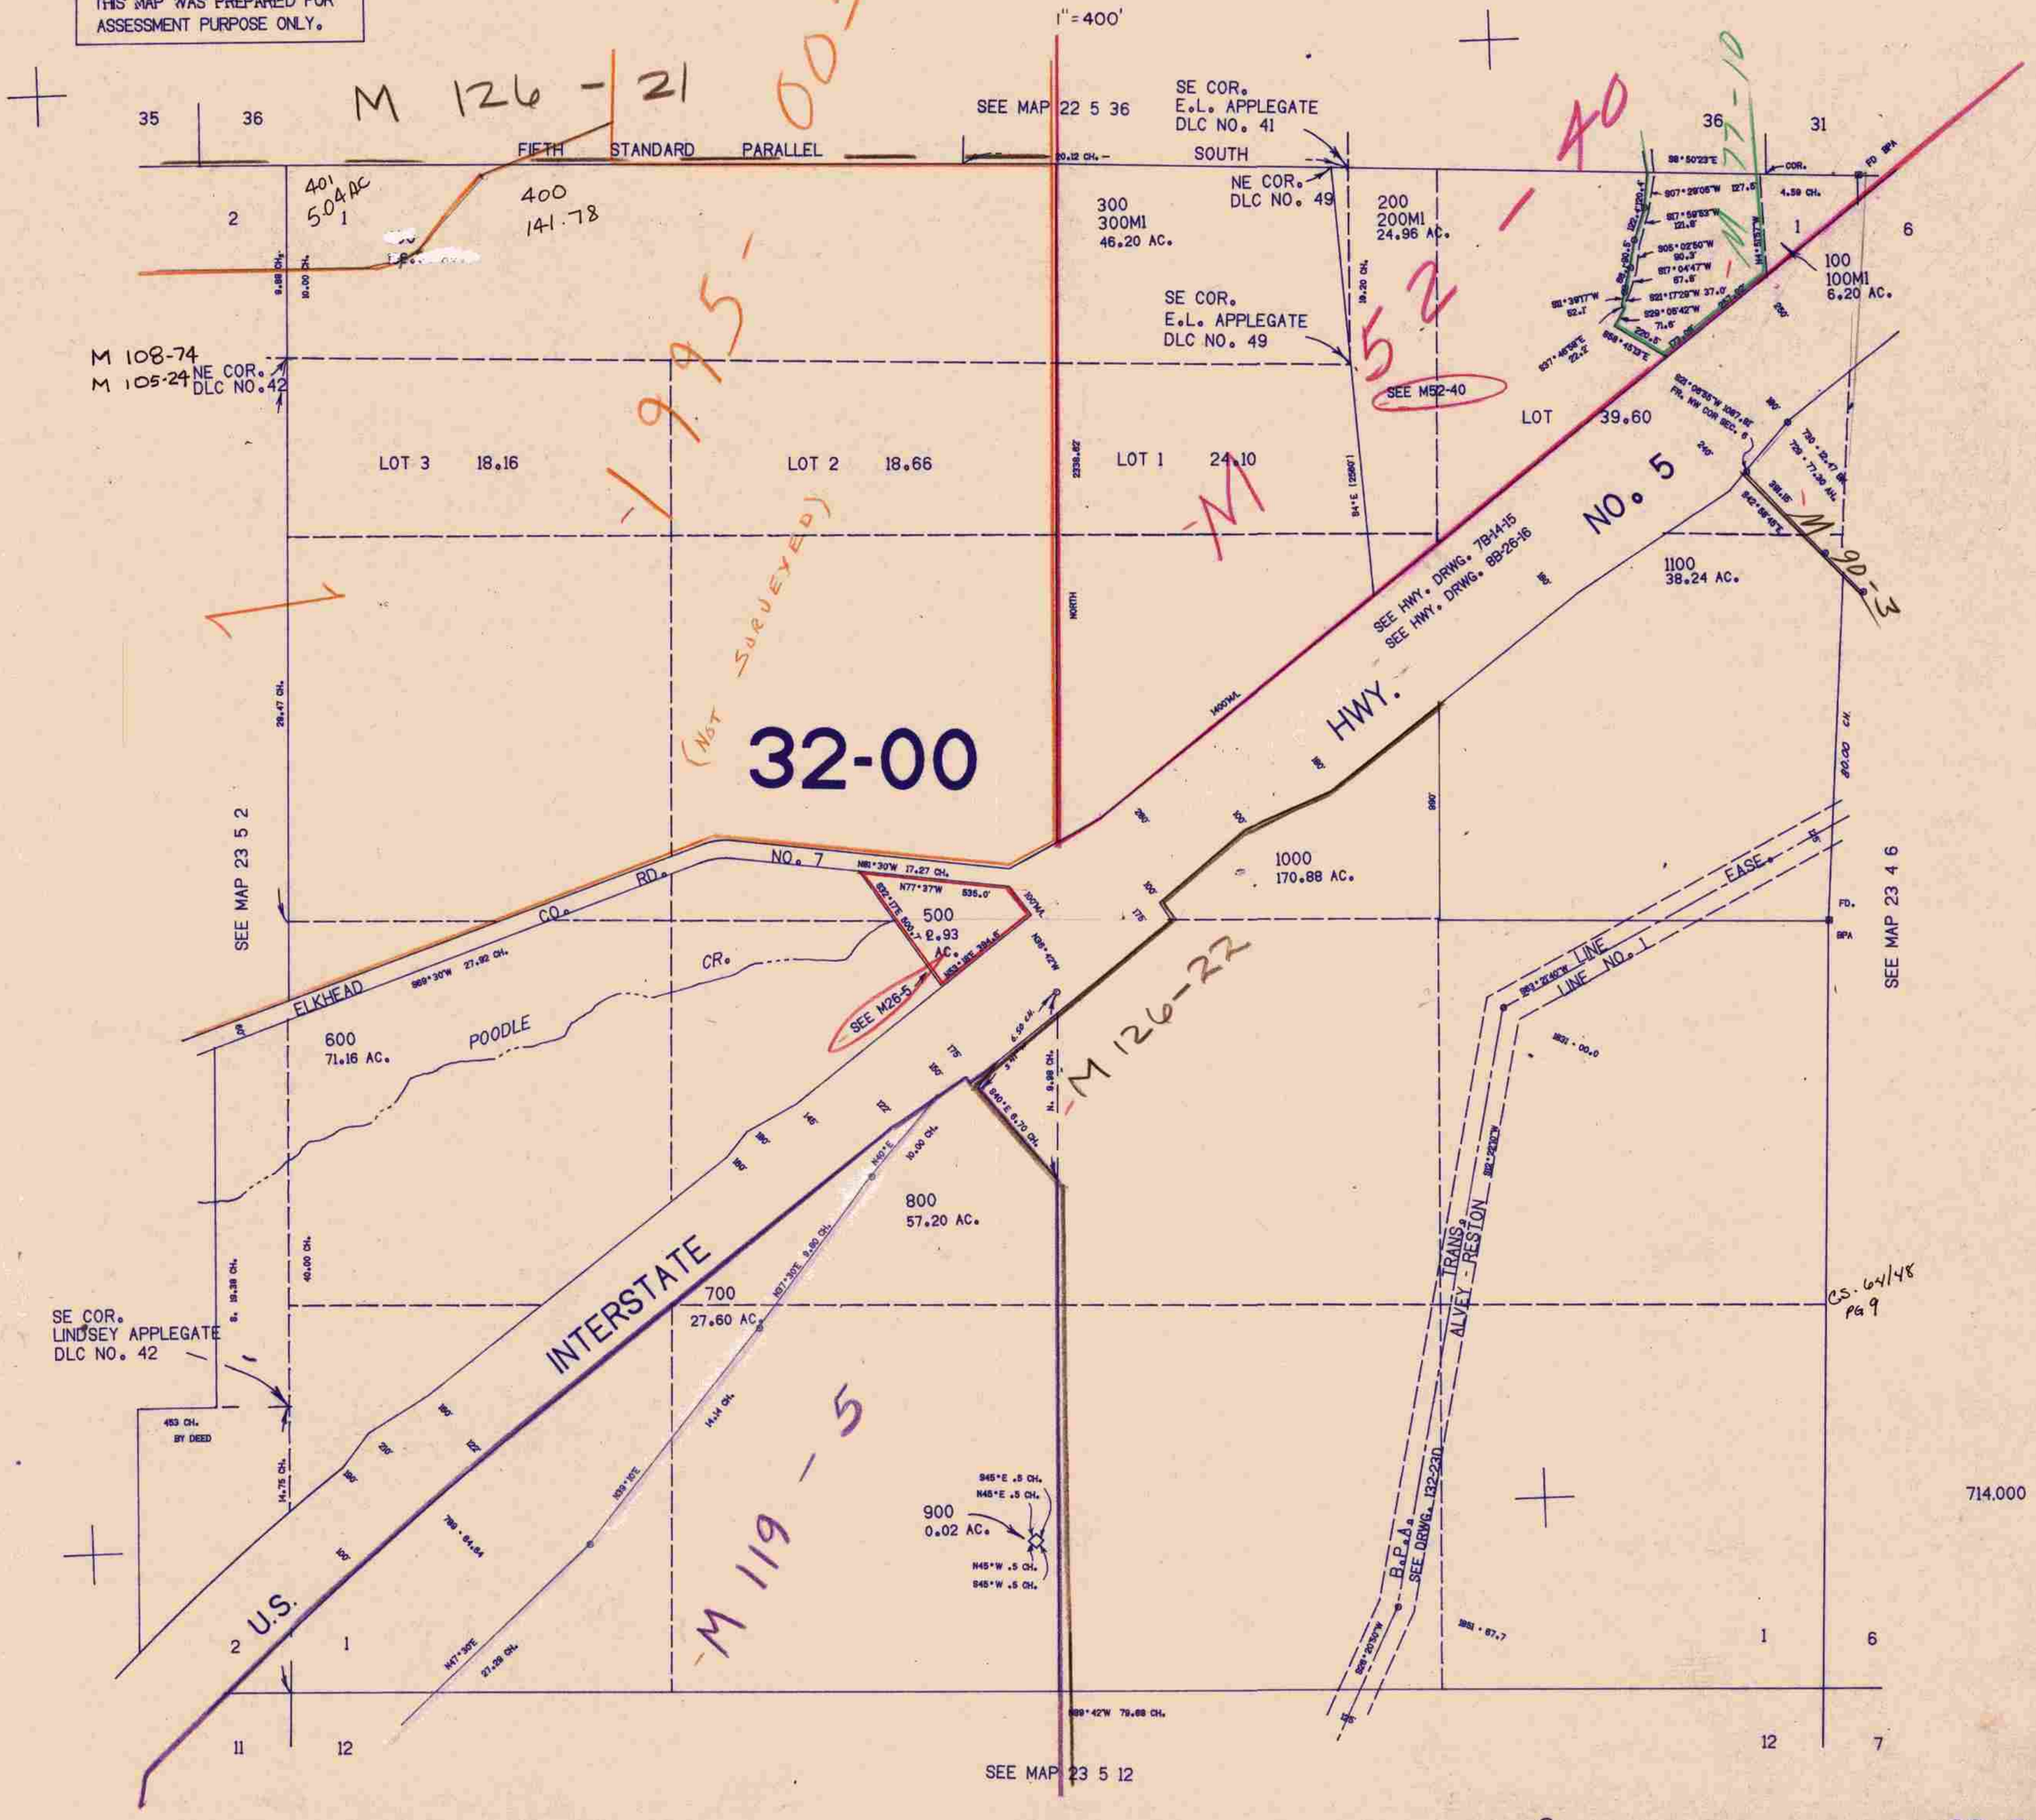

9/83 BS