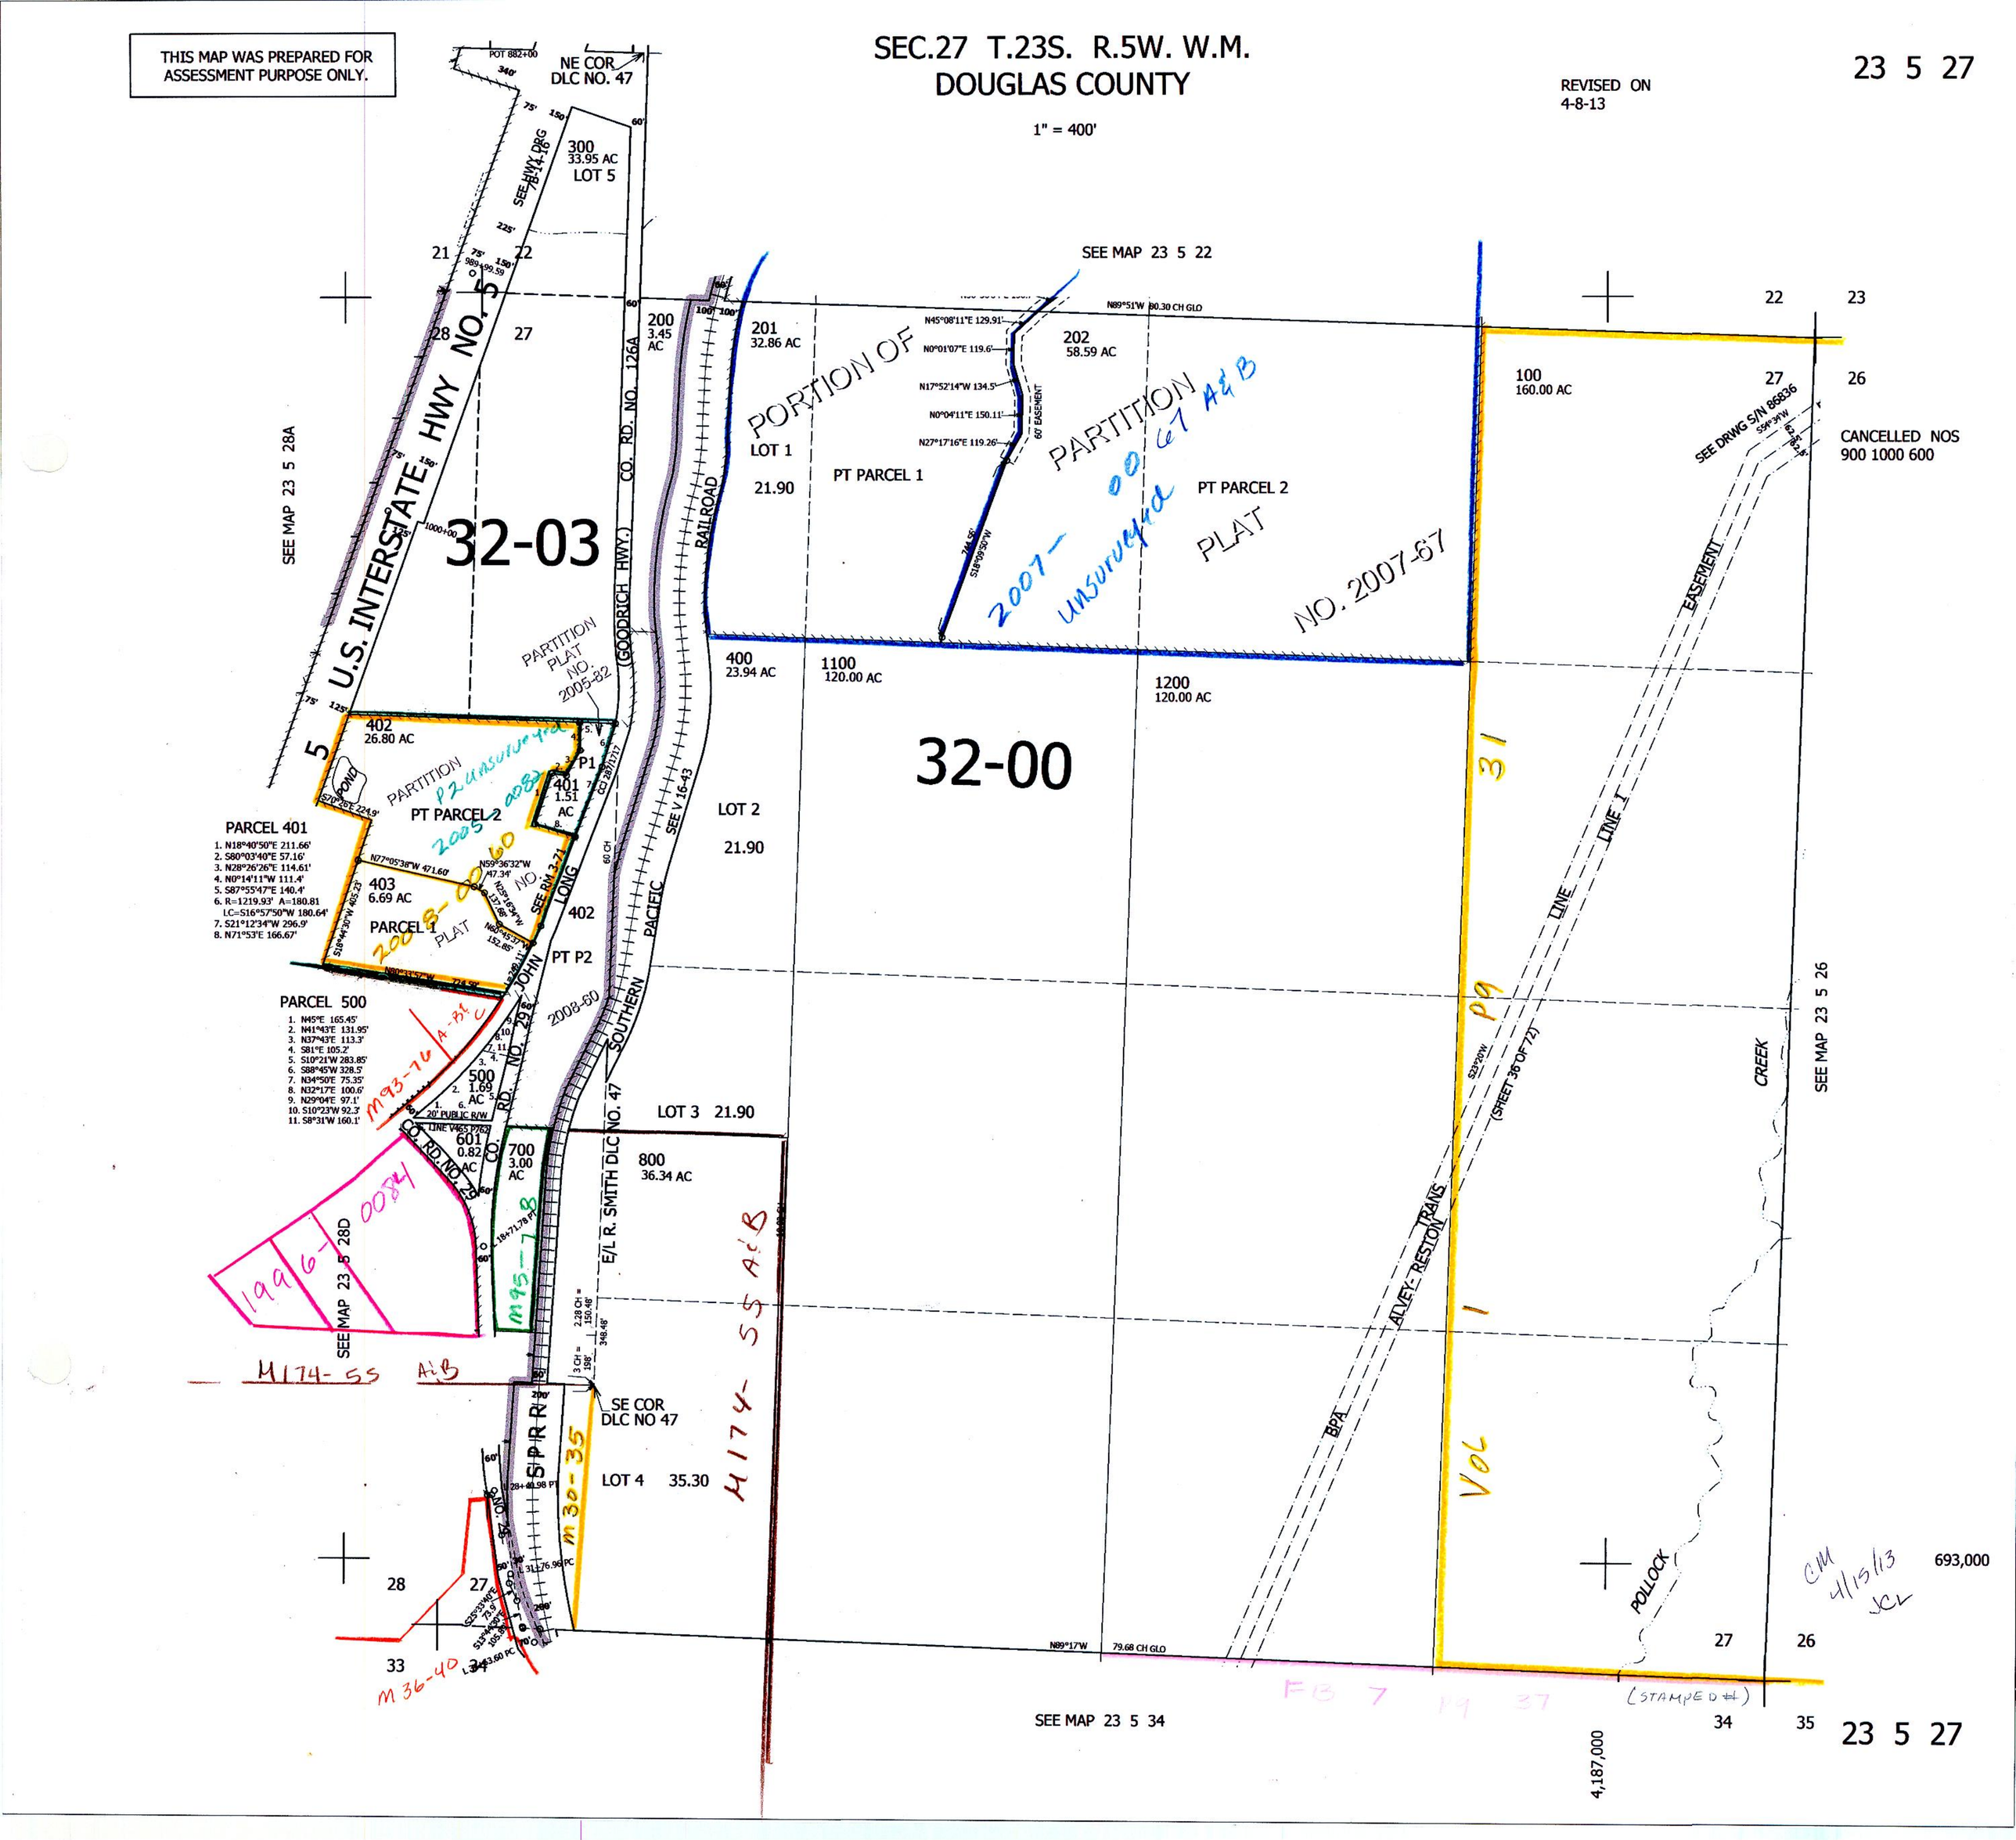
THIS MAP WAS PREPARED FOR ASSESSMENT PURPOSE ONLY.
SEC.27 T.23S. R.5W. W.M.
DOUGLAS COUNTY
1" = 400'
REVISED ON 4-8-13
23 5 27
NE COR DLC NO. 47
300 33.95 AC LOT 5
SEE HWY DRG
SEE MAP 23 5 22
SEE MAP 23 5 28A
U.S. INTERSTATE HWY NO. 5
32-03
200 3.45 AC
201 32.86 AC
202 58.59 AC
PORTION OF PARTITION PLAT NO. 2007-67
LOT 1 21.90
PT PARCEL 1
PT PARCEL 2
2007-0067 A&B unsurveyed
100 160.00 AC
CANCELLED NOS 900 1000 600
SEE DRWG S/N 86836
EASEMENT
PARTITION PLAT NO. 2005-82
(GOODRICH HWY.) CO. RD. NO. 126A
RAILROAD
400 23.94 AC
1100 120.00 AC
1200 120.00 AC
32-00
402 26.80 AC
PARTITION P2 unsurveyed 2005-0082
401 1.51 AC
PT PARCEL 2
PARCEL 401
1. N18°40'50"E 211.66'
2. S80°03'40"E 57.16'
3. N28°26'26"E 114.61'
4. N0°14'11"W 111.4'
5. S87°55'47"E 140.4'
6. R=1219.93' A=180.81 LC=S16°57'50"W 180.64'
7. S21°12'34"W 296.9'
8. N71°53'E 166.67'
403 6.69 AC
PARCEL 1
PLAT NO. 2008-0060
402
PT P2
LOT 2 21.90
SEE V 16-43
PACIFIC
SOUTHERN
JOHN LONG
PARCEL 500
1. N45°E 165.45'
2. N41°43'E 131.95'
3. N37°43'E 113.3'
4. S81°E 105.2'
5. S10°21'W 283.85'
6. S88°45'W 328.5'
7. N34°50'E 75.35'
8. N32°17'E 100.6'
9. N29°04'E 97.1'
10. S10°23'W 92.3'
11. S8°31'W 160.1'
M93-76 A-B&C
500 1.69 AC
20' PUBLIC R/W
CO. RD. NO. 29
601 0.82 AC
700 3.00 AC
LOT 3 21.90
800 36.34 AC
E/L R. SMITH DLC NO. 47
M95-78
1996-0084
SEE MAP 23 5 28D
M174-55 A&B
M174-55 A&B
SE COR DLC NO 47
S P R R
LOT 4 35.30
M30-35
M36-40
BPA
ALVEY-RESTON TRANS
(SHEET 36 OF 72)
Vol 1
P9
31
LINE
LINE 1
CREEK
SEE MAP 23 5 26
POLLOCK
693,000
CM 4/15/13 JCL
SEE MAP 23 5 34
4,187,000
FB 7 P9 37
(STAMPED #)
23 5 27