THIS MAP WAS PREPARED FOR ASSESSMENT PURPOSE ONLY.

SE1/4 SEC.28 T.23S. R.5W. W.M.
DOUGLAS COUNTY
1" = 200'

REVISED ON 5-25-22

23 5 28D
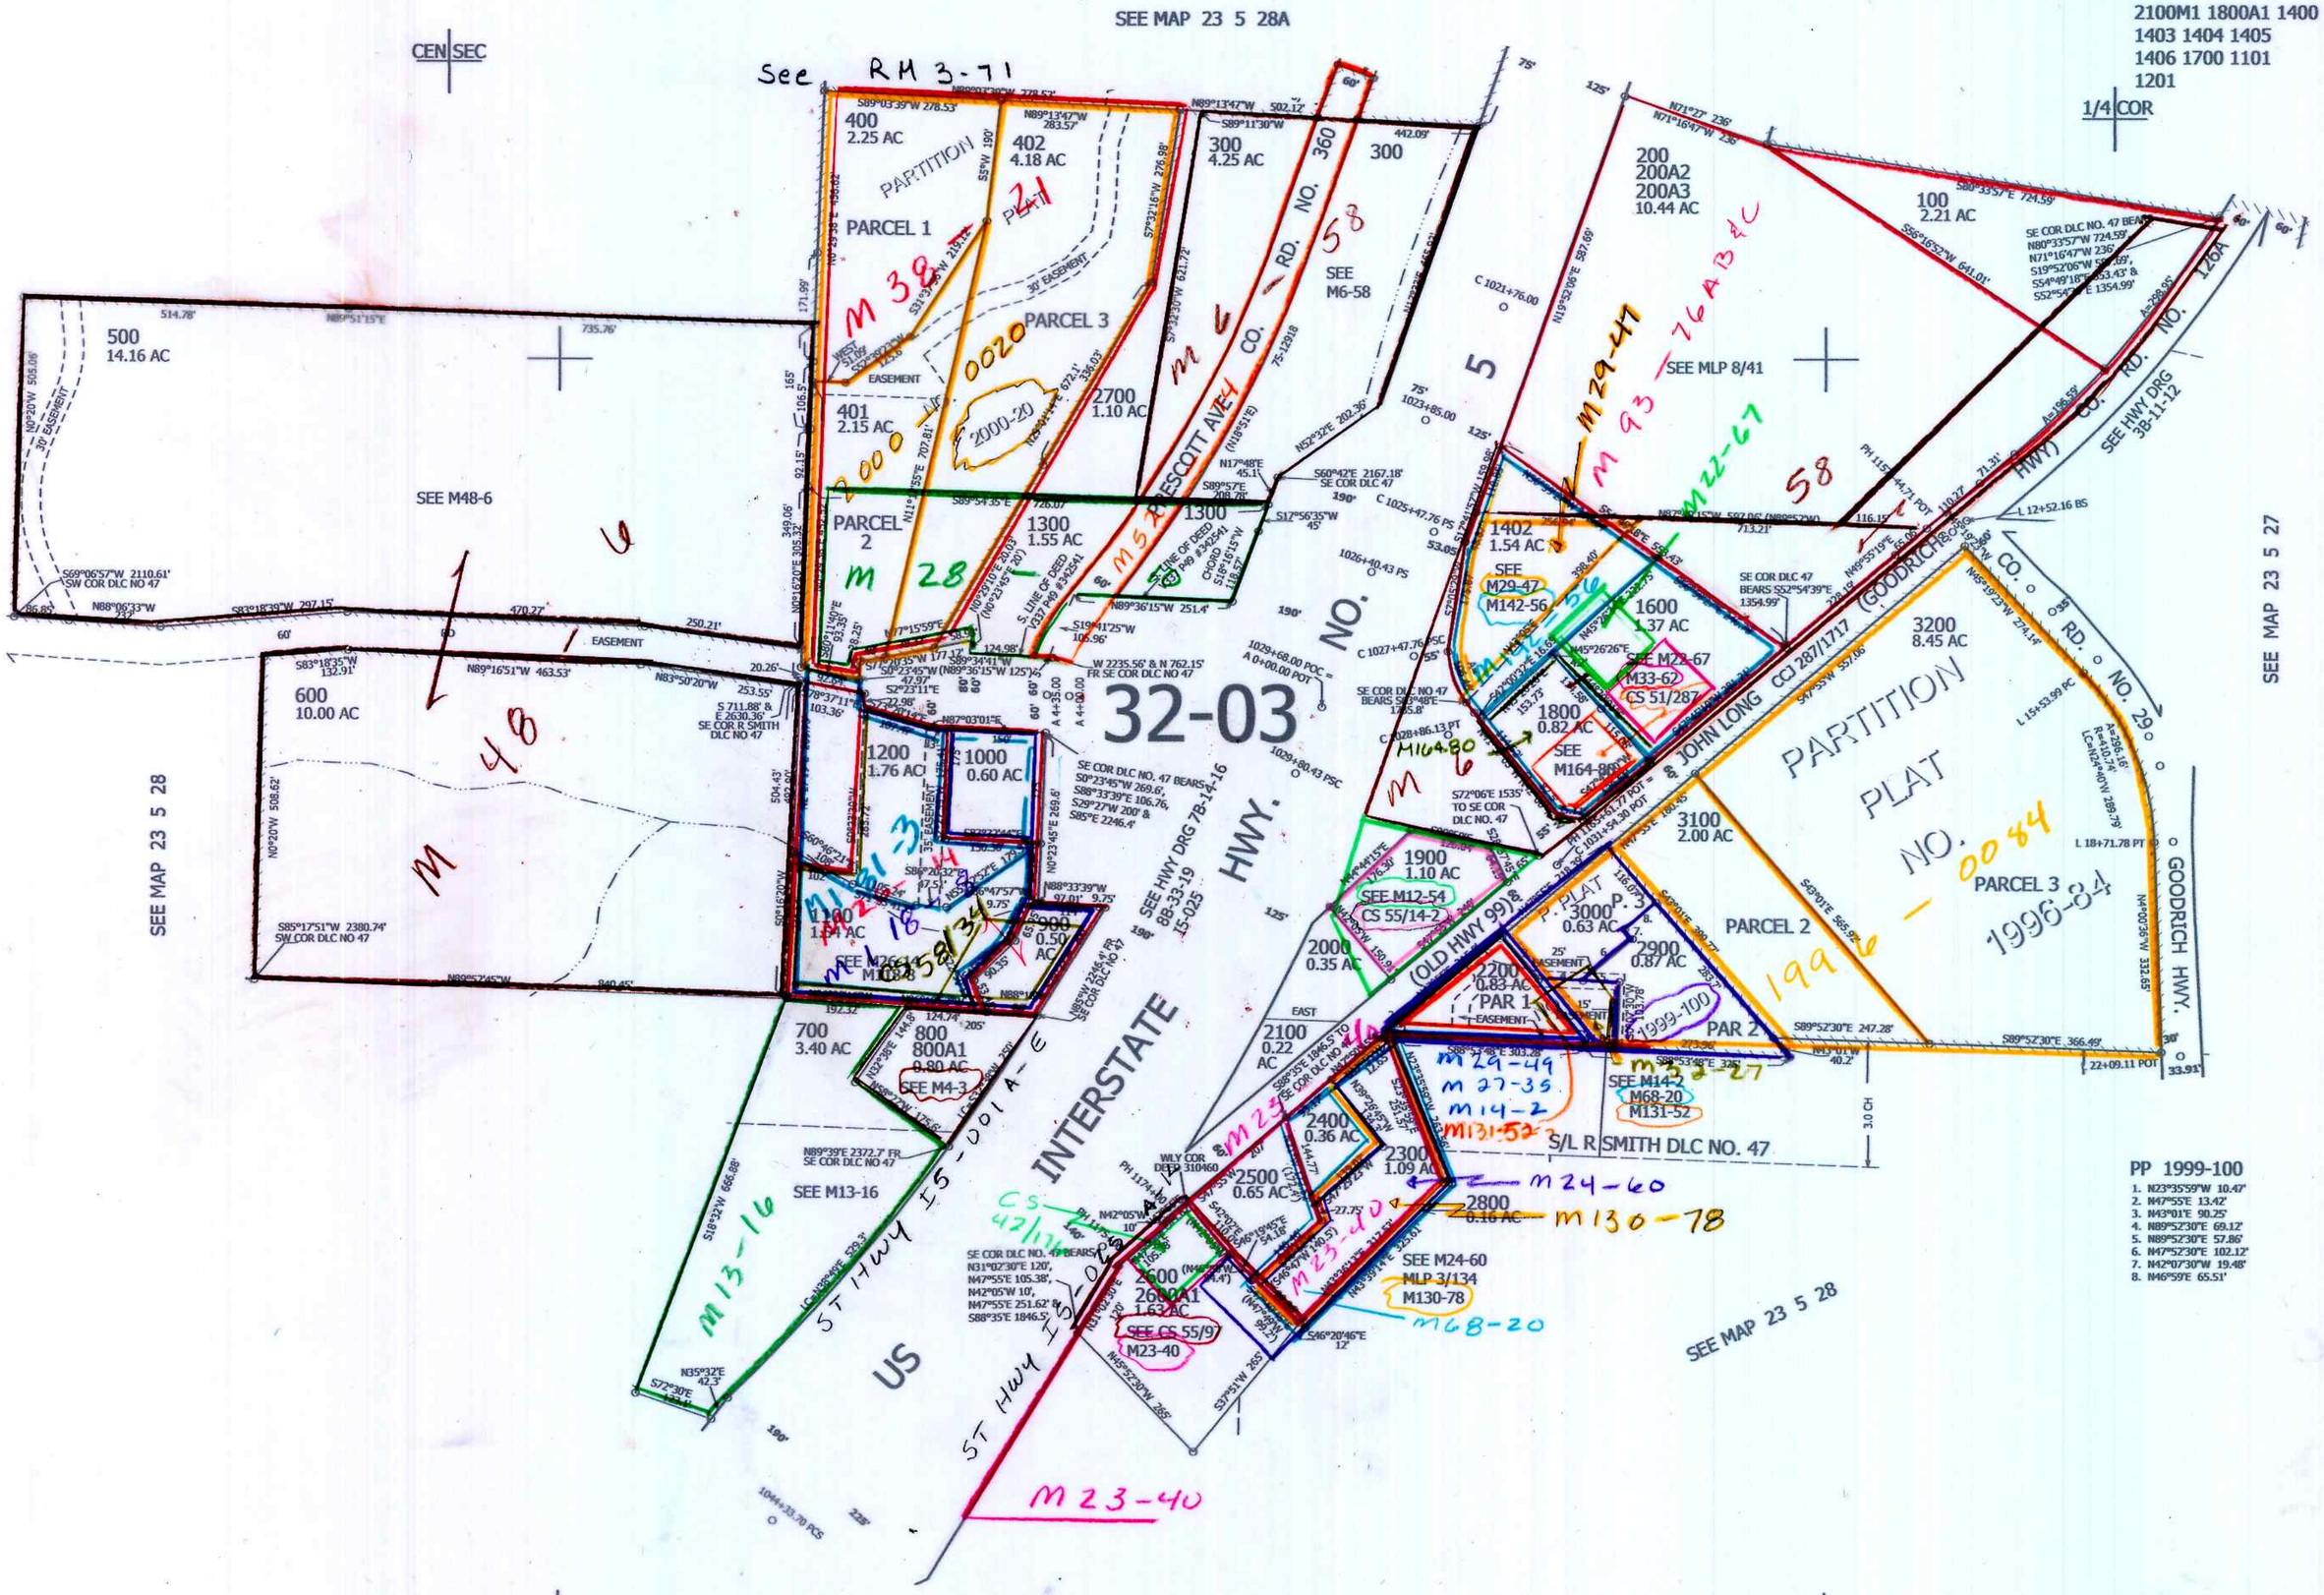
CANCELLED NOS
1500 1401 2200A1
1601 1600A1 200A1
2100M1 1800A1 1400
1403 1404 1405
1406 1700 1101
1201