THIS MAP WAS PREPARED FOR ASSESSMENT PURPOSE ONLY.

SEC.35 T.23S. R.5W. W.M.
DOUGLAS COUNTY

1" = 400'

REVISED ON 4-6-07

23 5 35
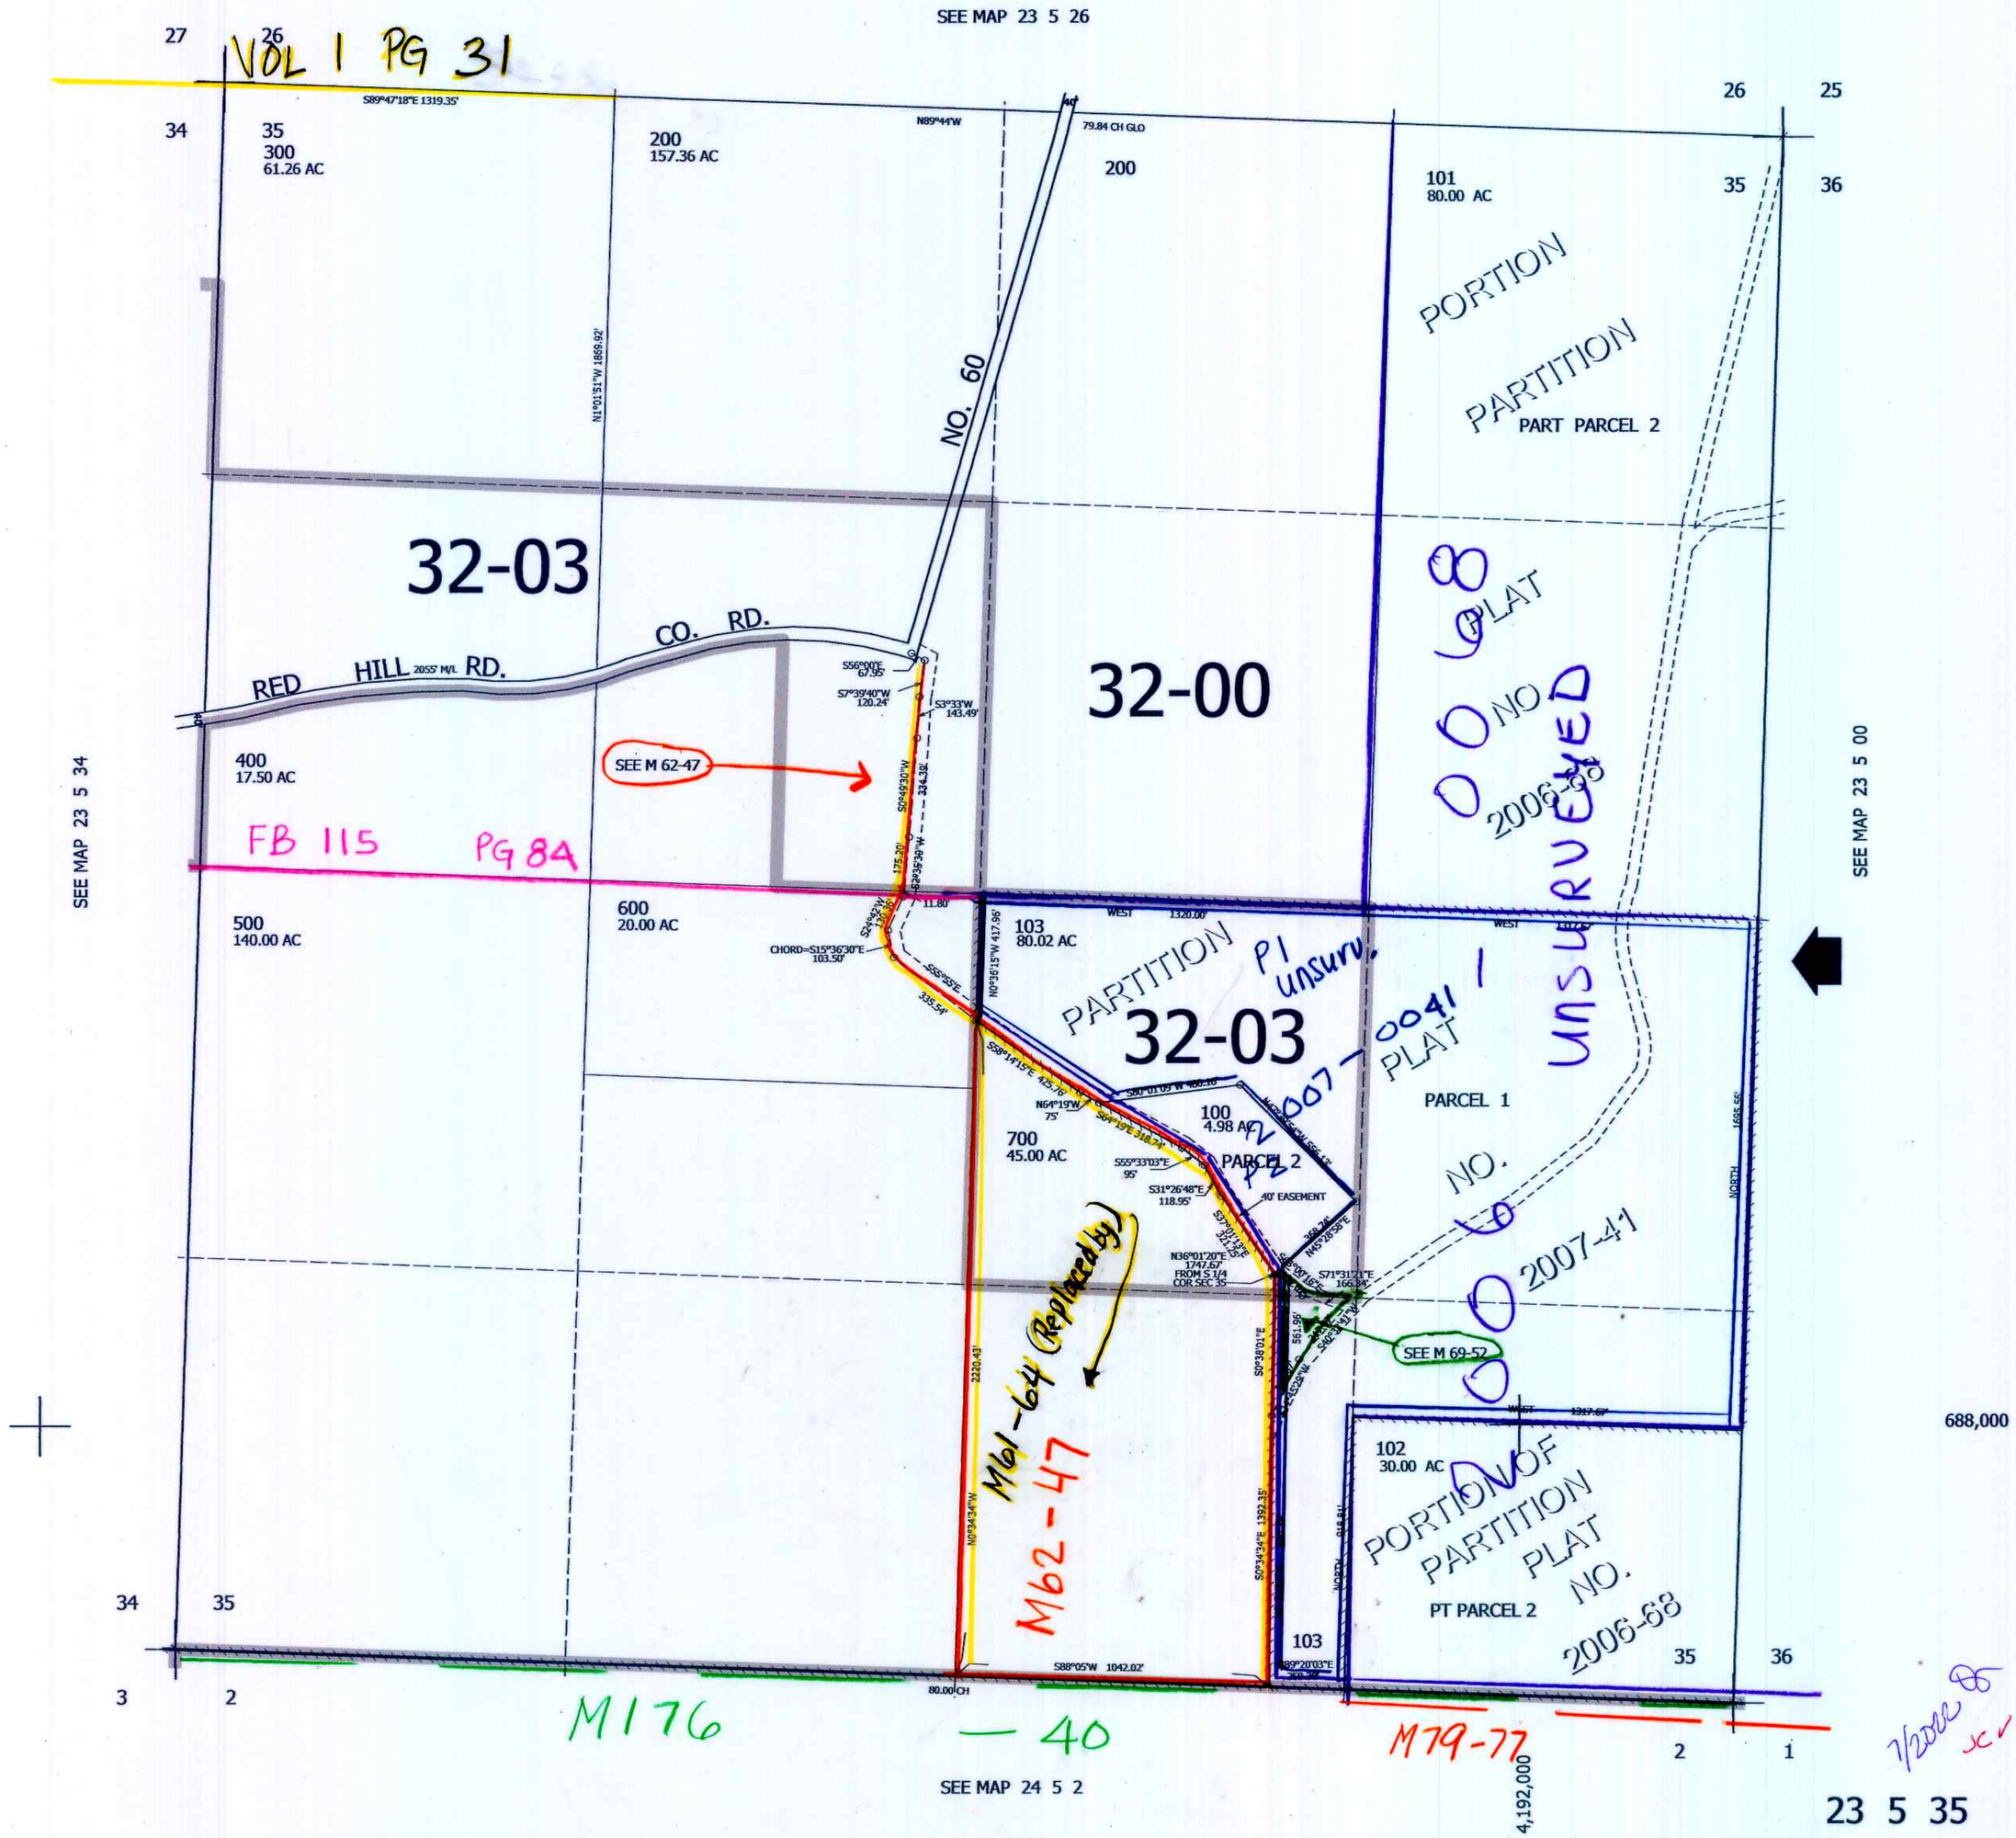
CANCELLED NOS