THIS MAP WAS PREPARED FOR ASSESSMENT PURPOSE ONLY.
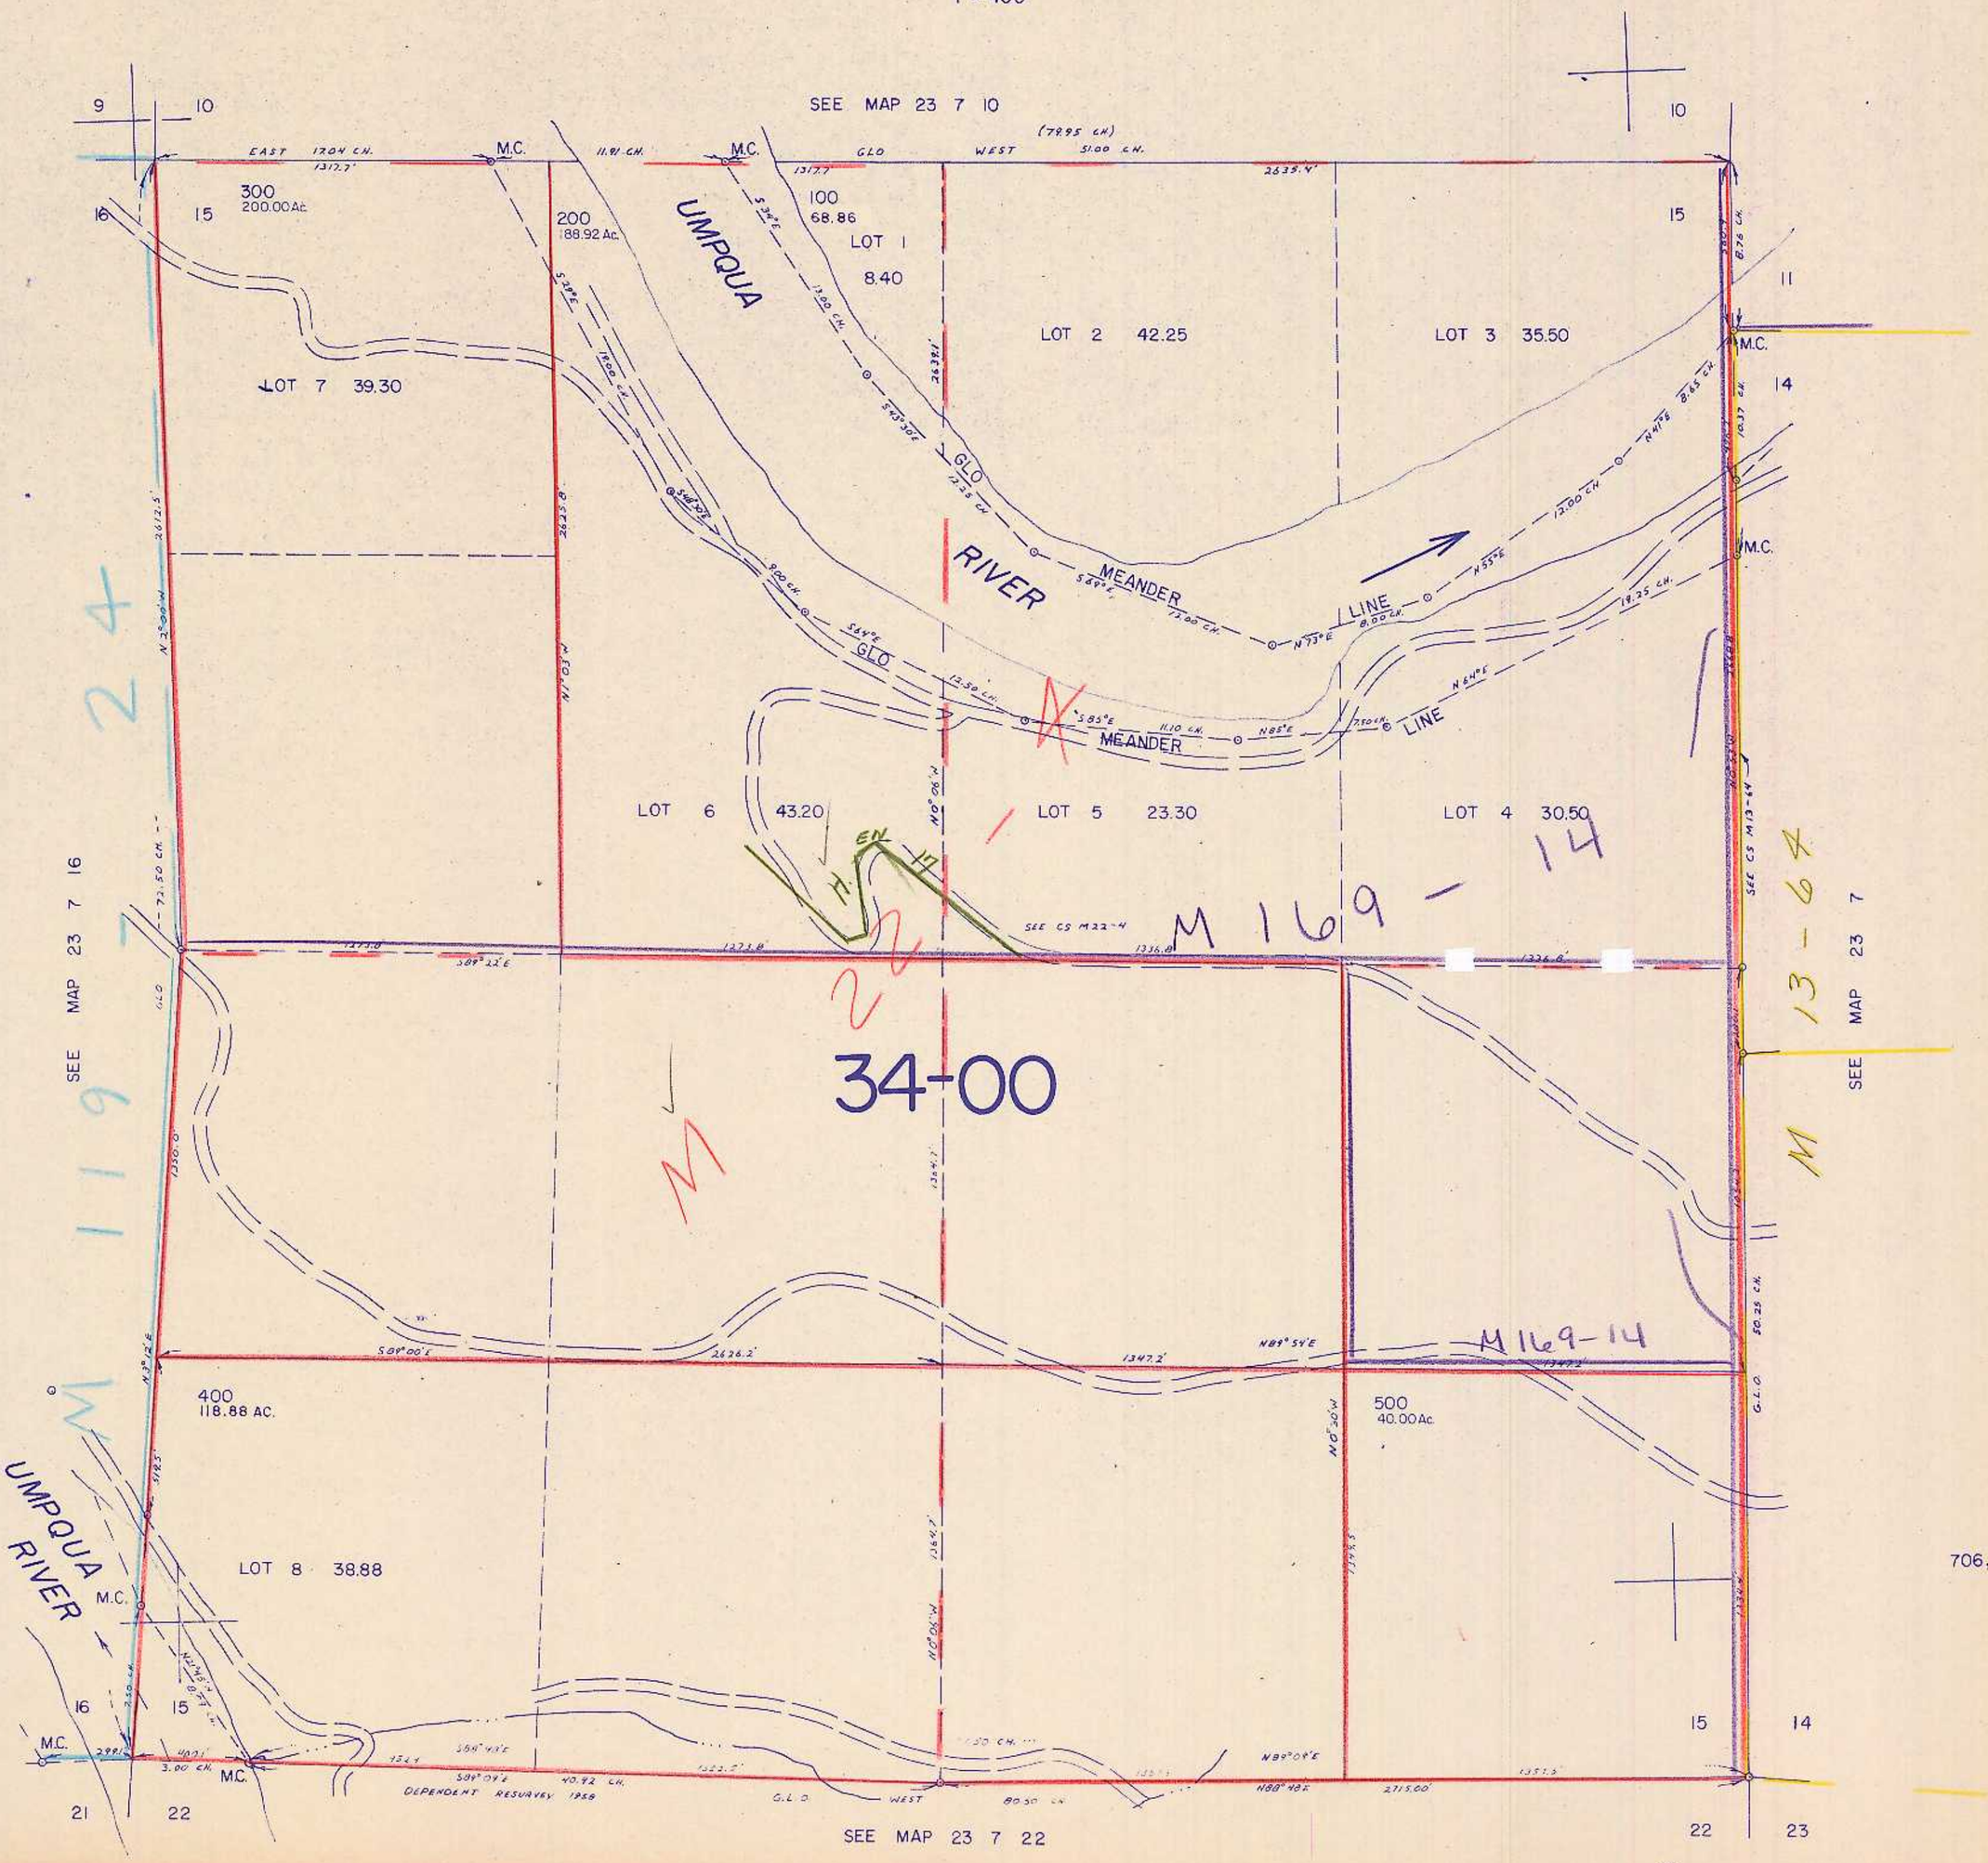
SECTION 15 T.23 S. R. 7 W. W.M.
DOUGLAS COUNTY
1" = 400'