THIS MAP WAS PREPARED FOR ASSESSMENT PURPOSE ONLY.

SEC.1 T.23S. R.8W. W.M.
DOUGLAS COUNTY

1" = 400'

REVISED ON 11-16-06

23 8 1

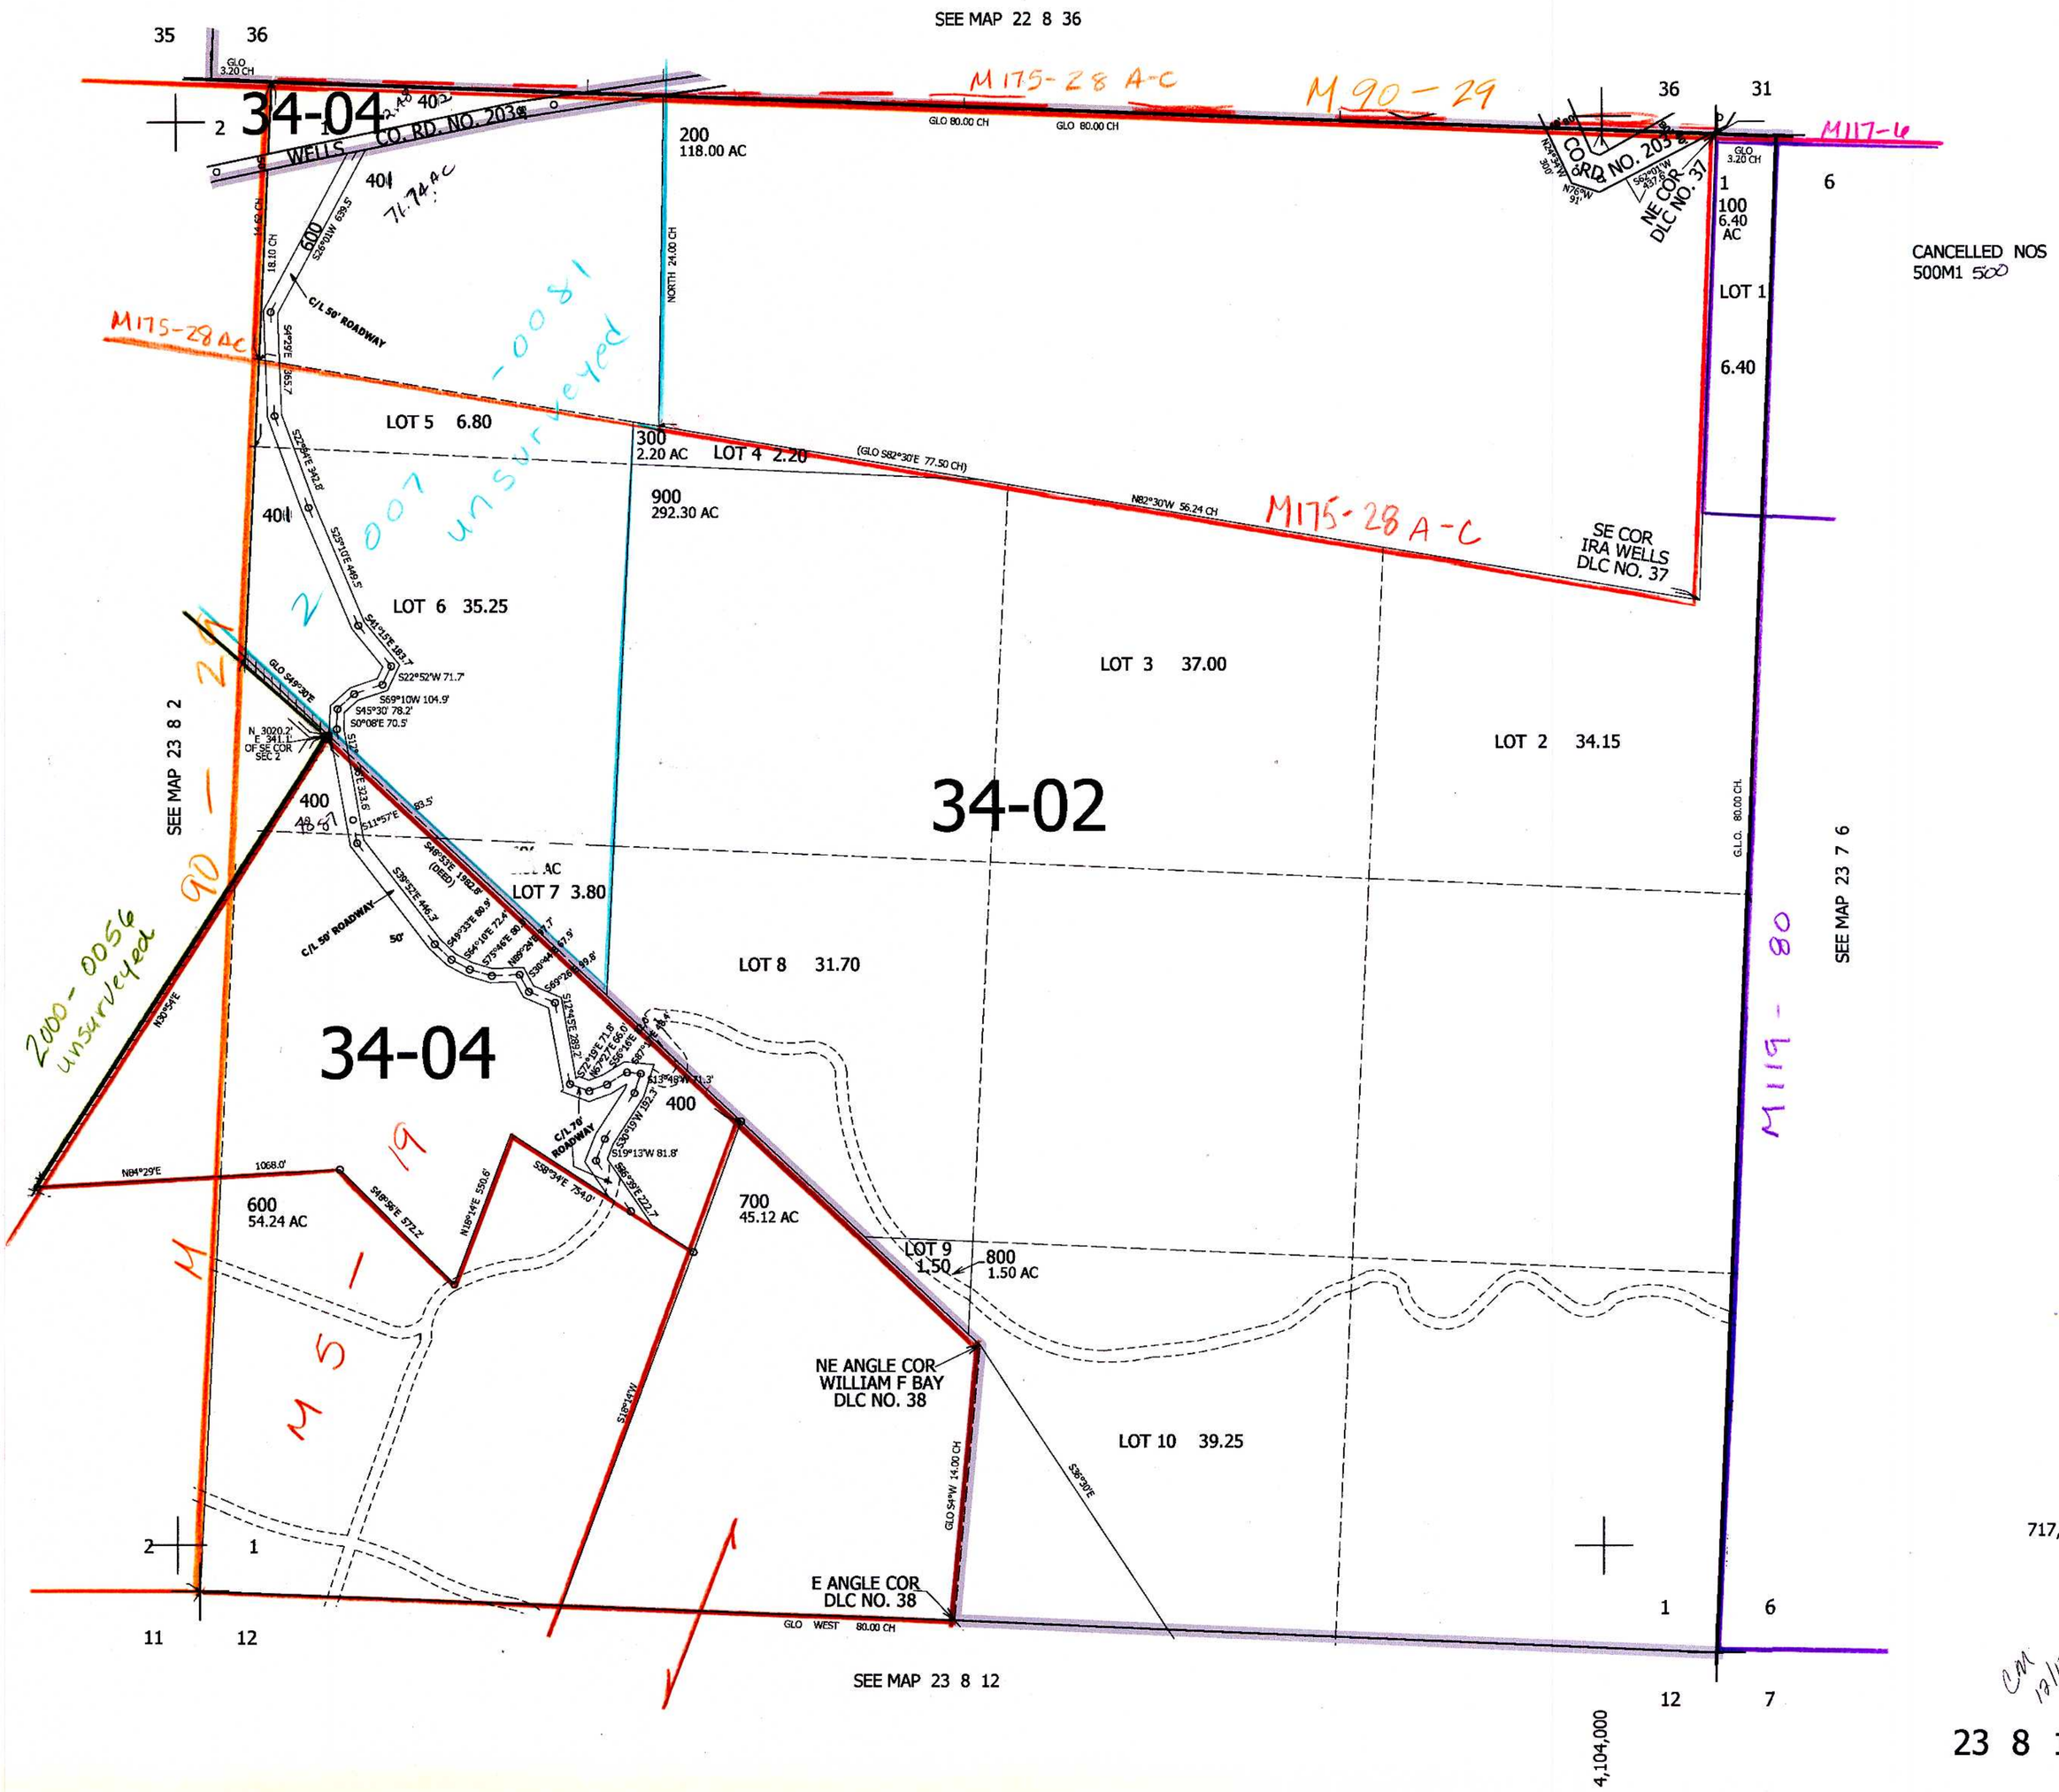

23 8 1