


THIS MAP WAS PREPARED FOR ASSESSMENT PURPOSE ONLY.

SECTION 12 T.23S. R. 8 W. W.M.
DOUGLAS COUNTY

REVISED ON
11-04-91

23 8 12

1" = 400

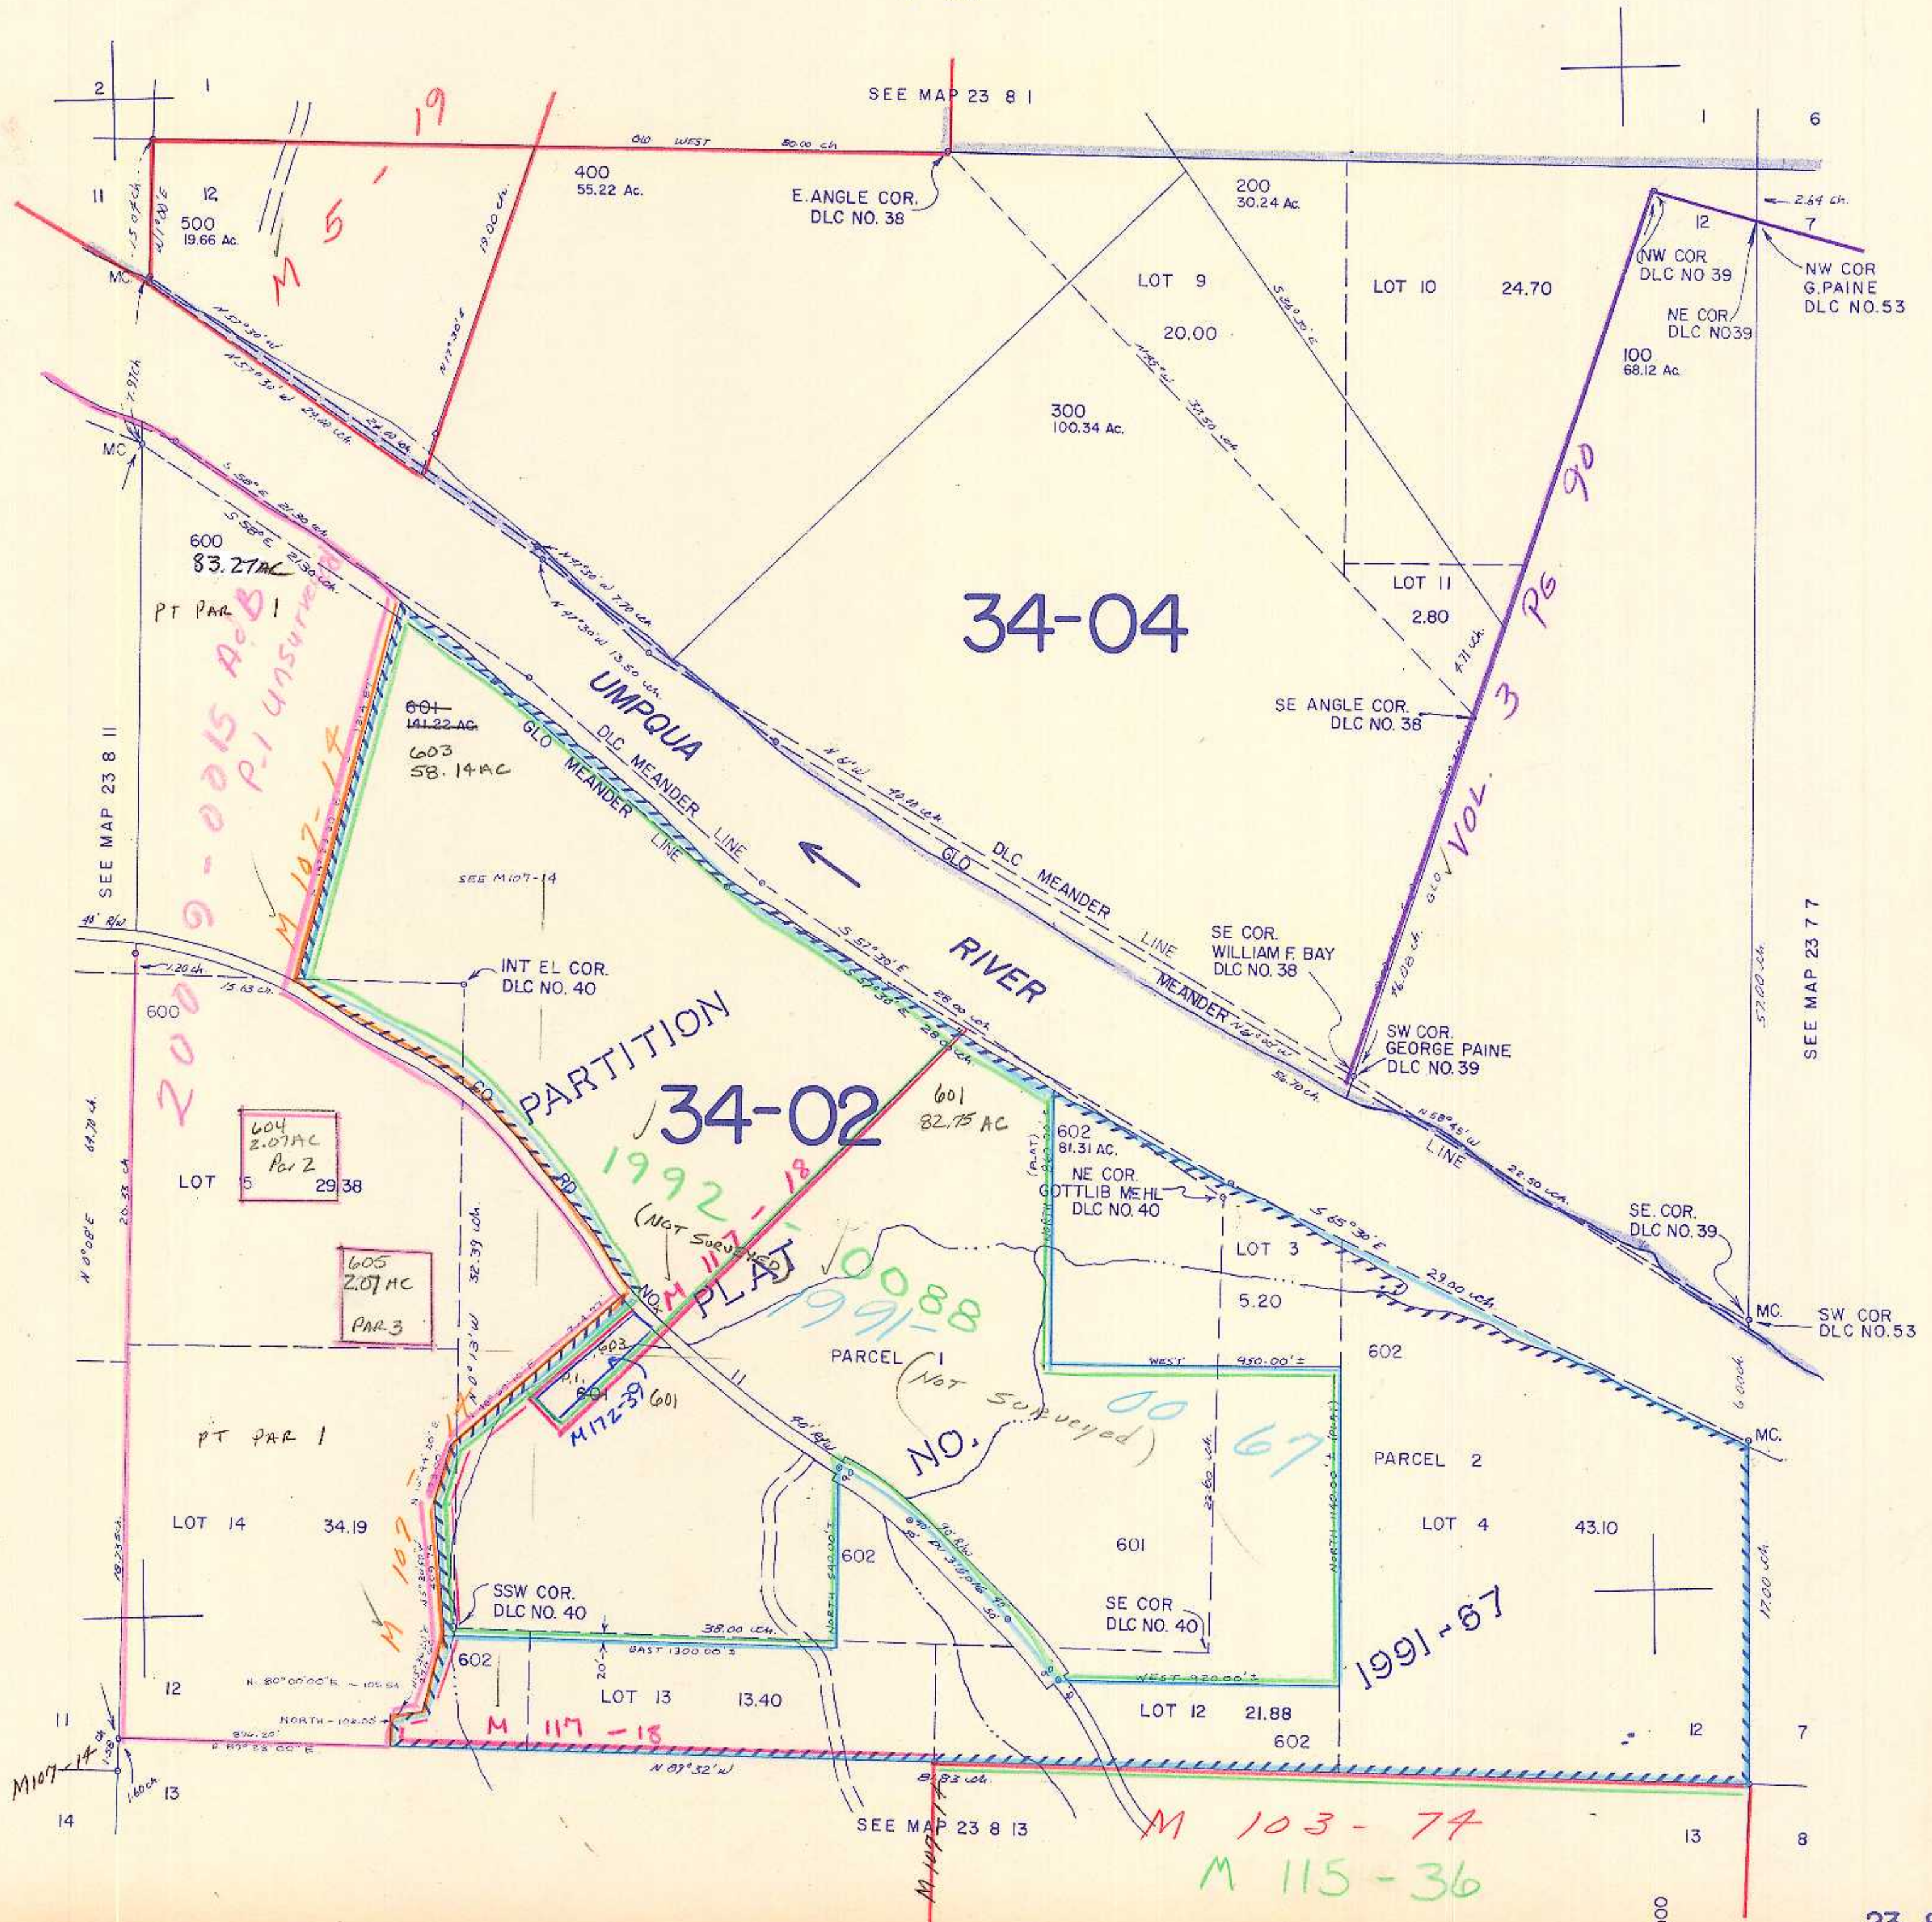

712,000

23 8 12